

CITY OF SUPERIOR

SEWER PLAN

Contract let Feb. 4, 1892
 completed Sept. 1, 1892
 Wolf & King, Contractor
 Lamagan & Carlson, Inspectors
 A. S. Cooper, City Engr.

1892

BANKS






AVE.

Section of 10" Pipe

Section of 12" Pipe

Section of 15" Pipe

Section of 18"x24" Sewer

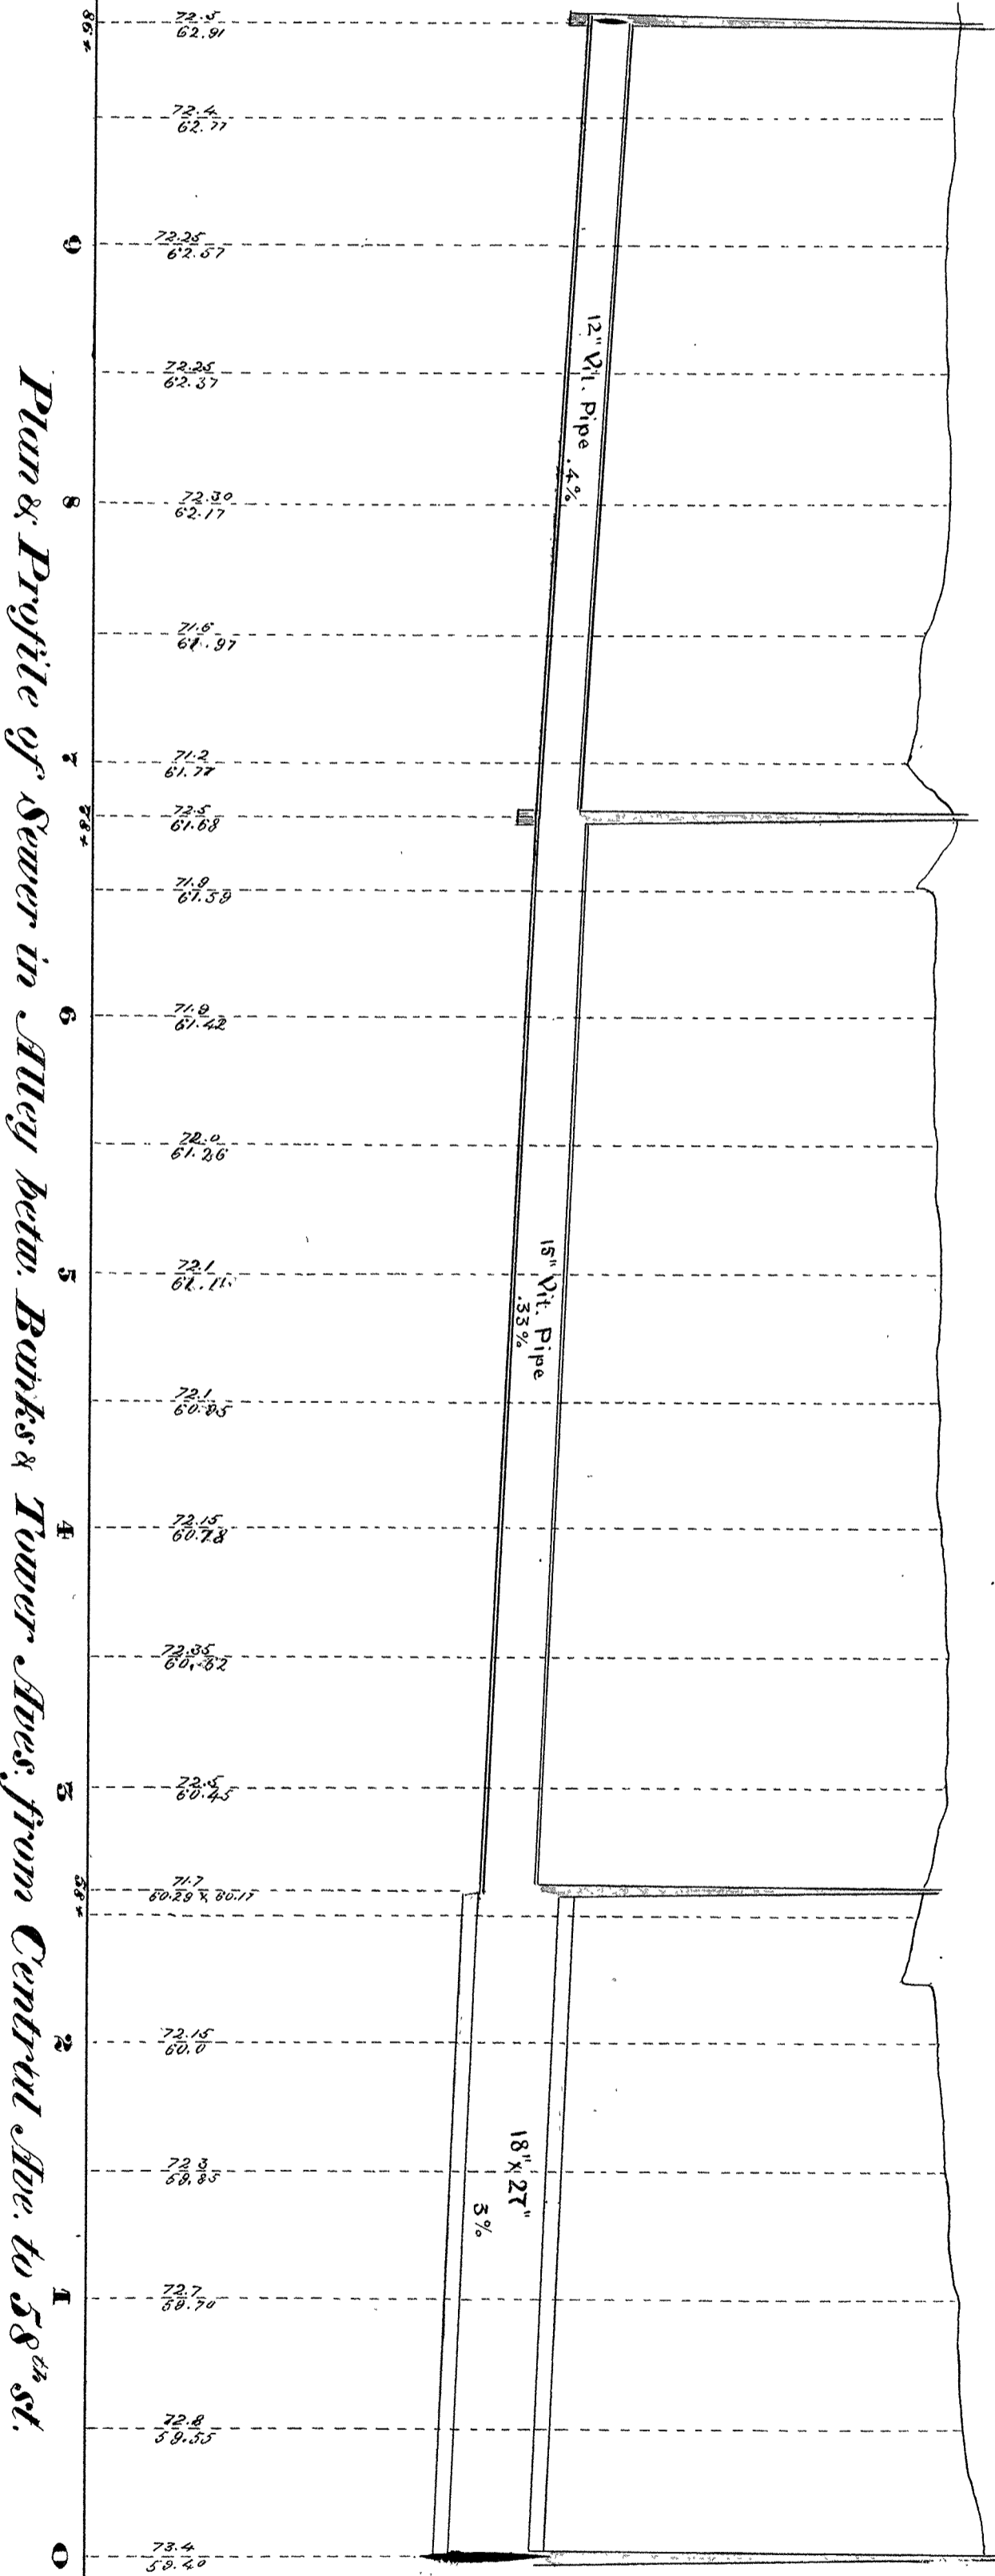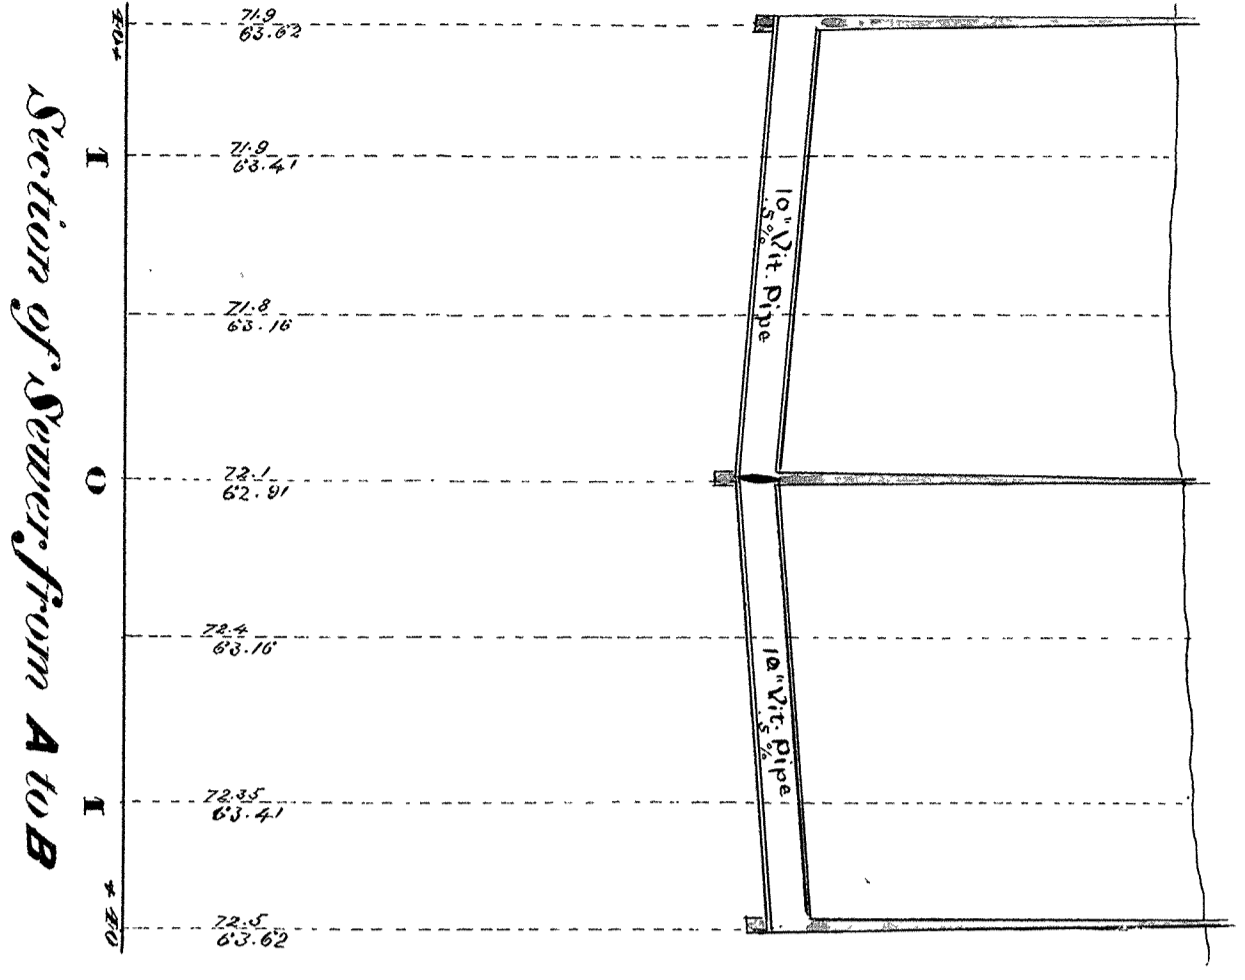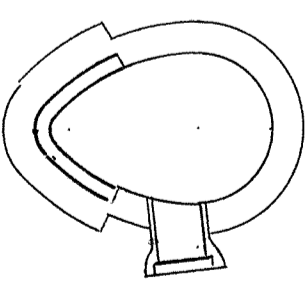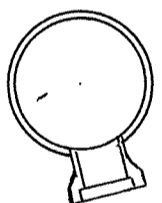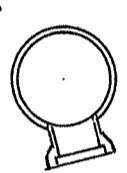

Scale: Horizontal 60' = 1"
 Vertical 4' = 1"
 Section 2" = 1"