
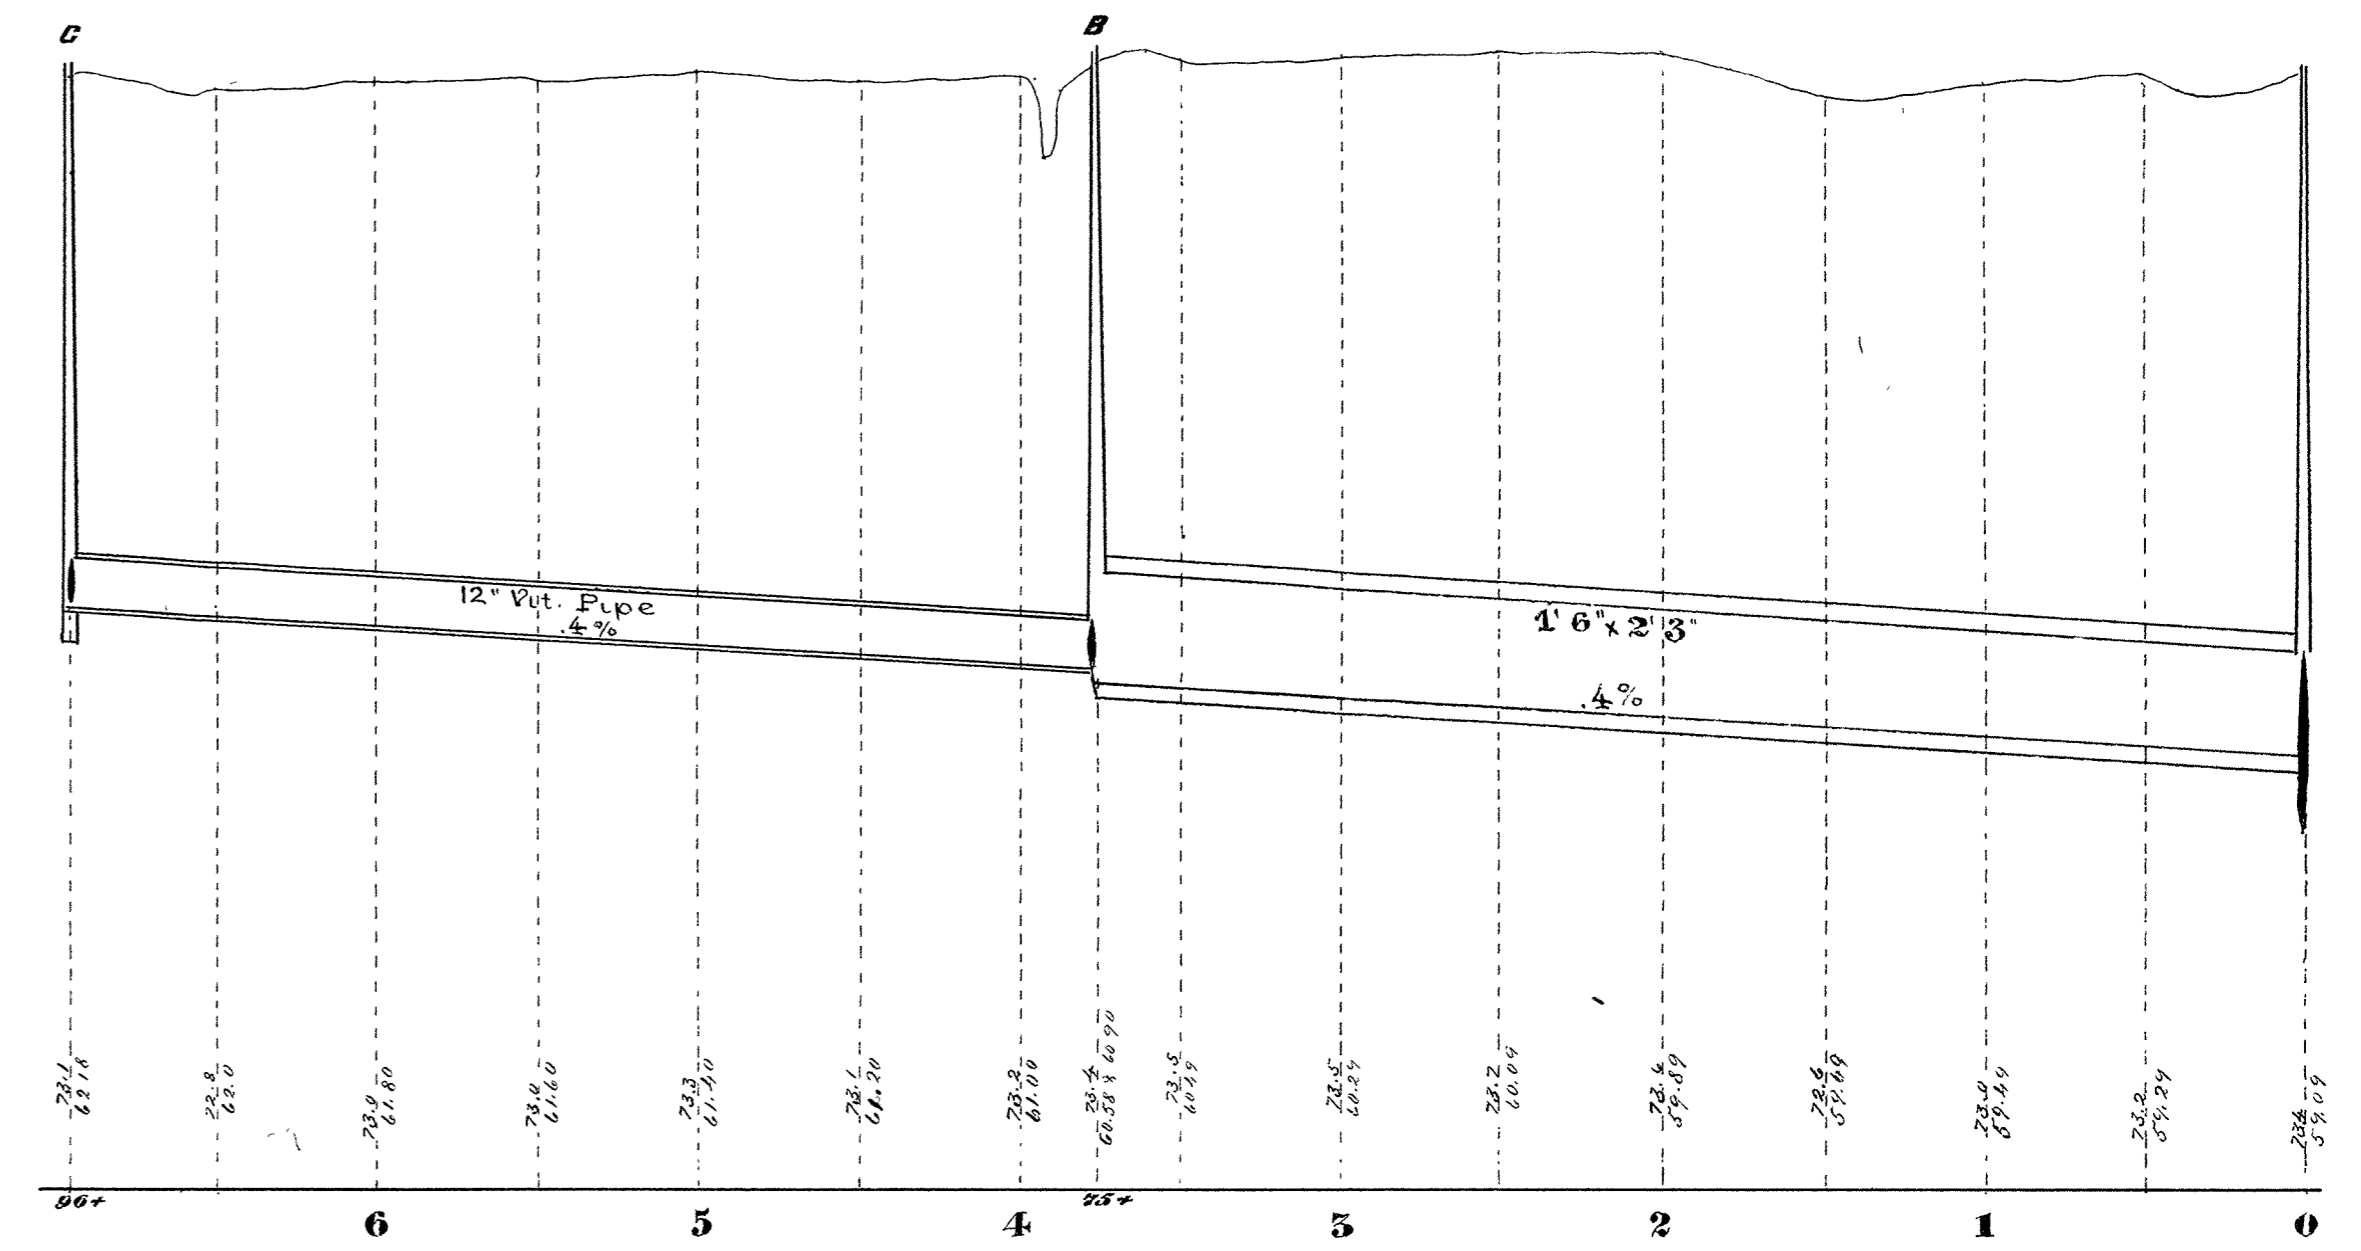
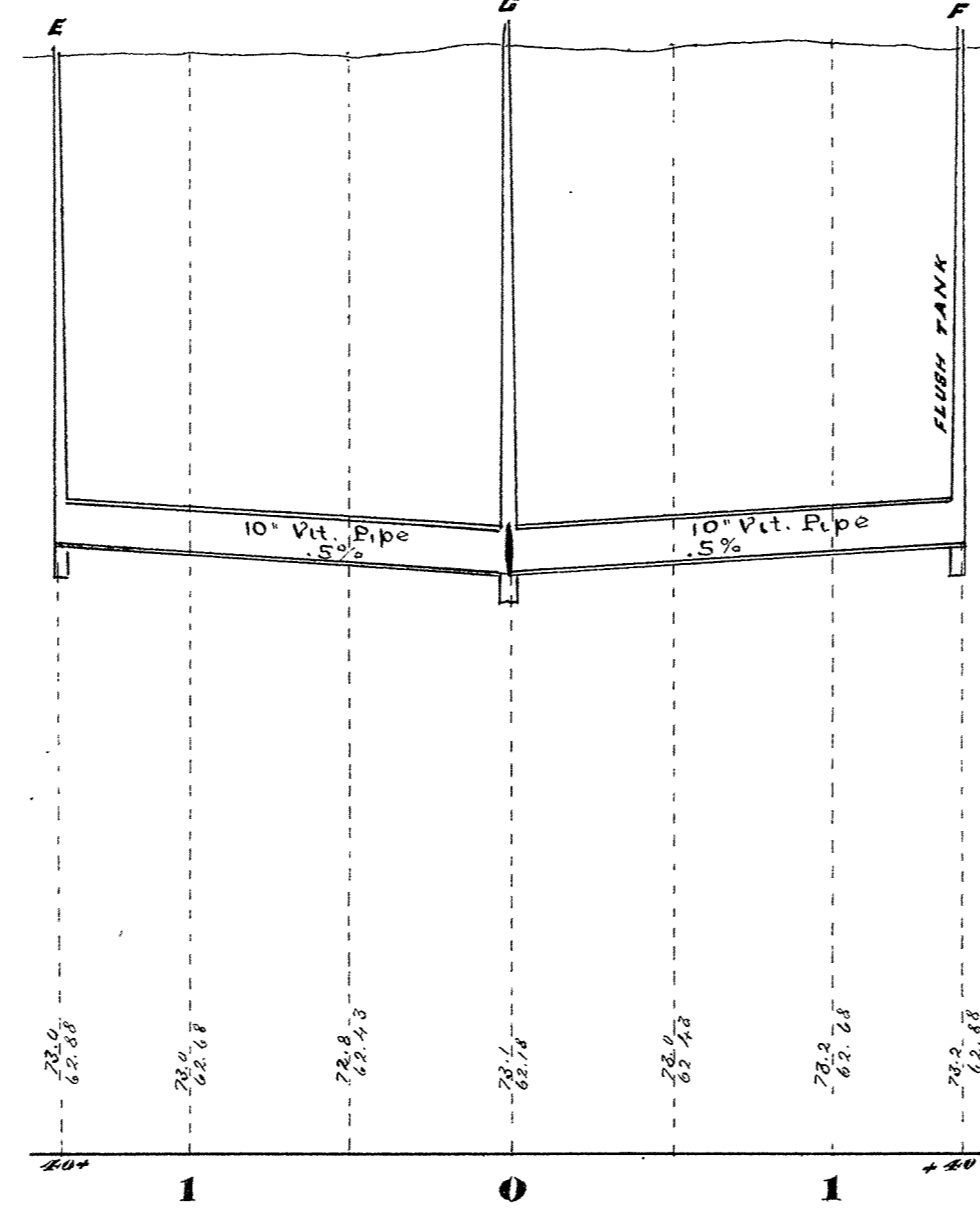
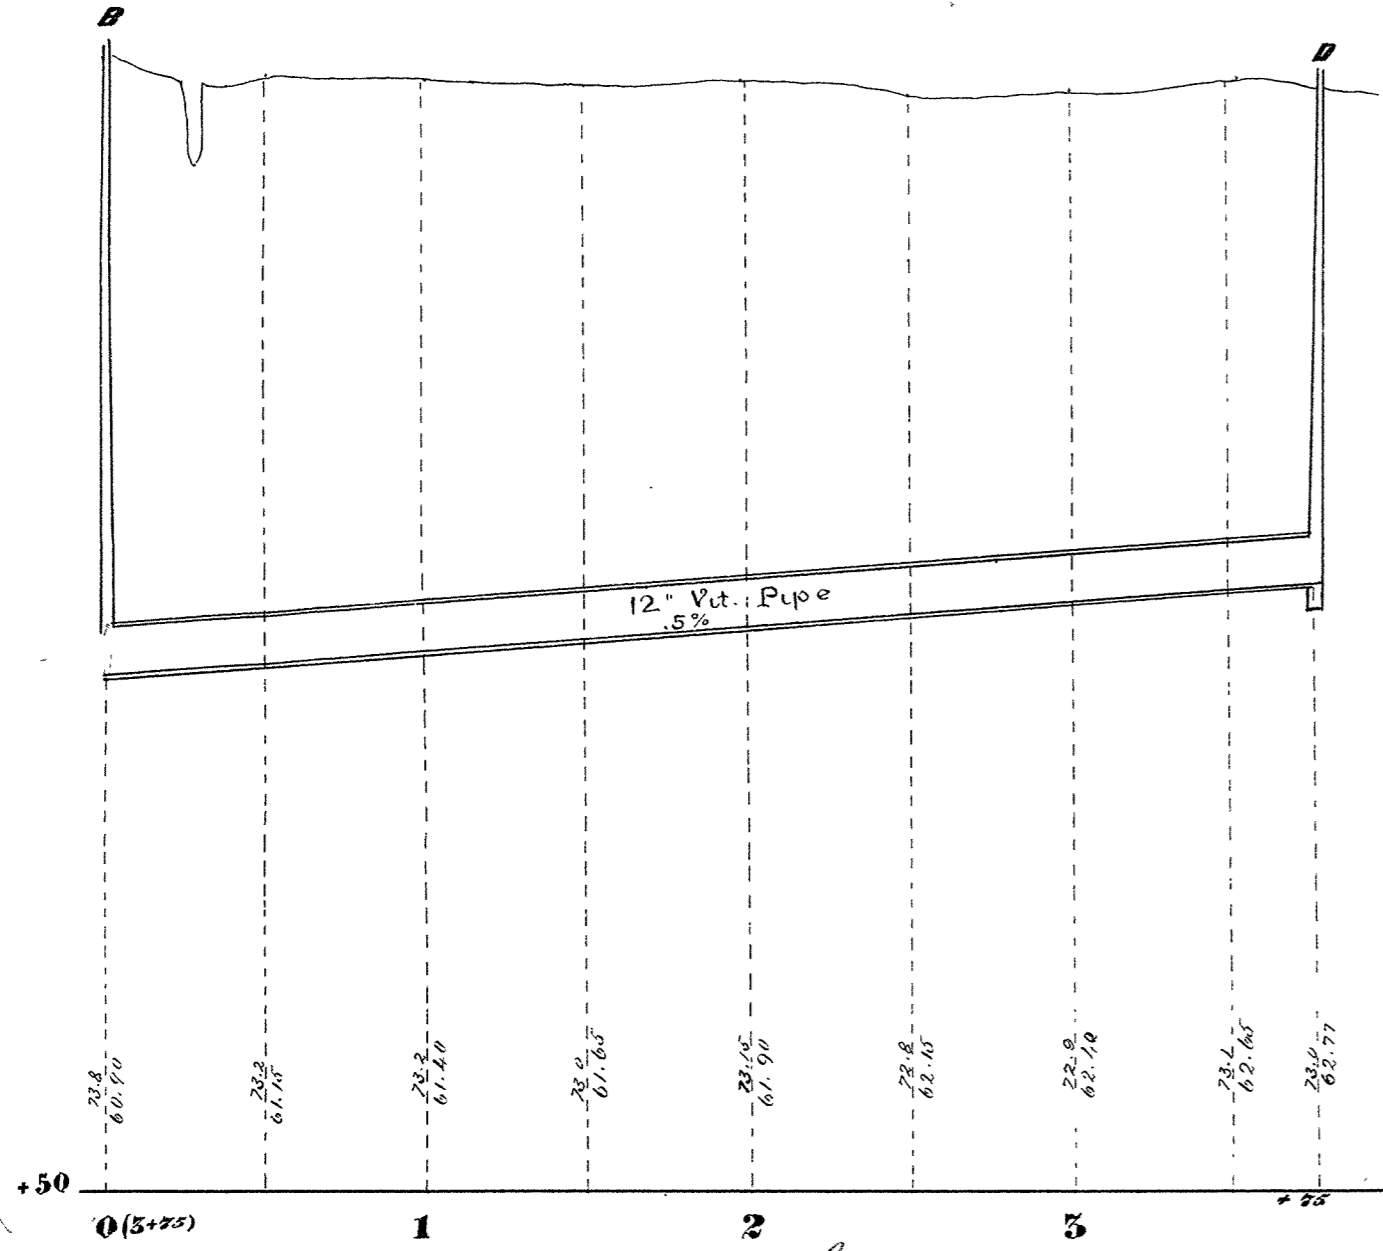
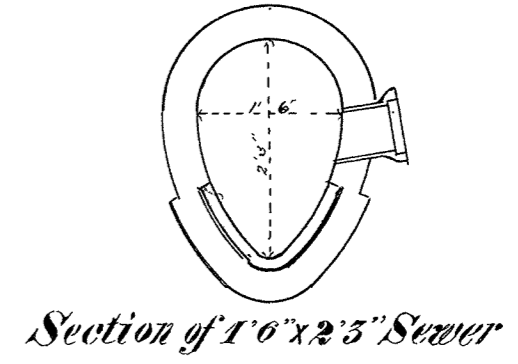
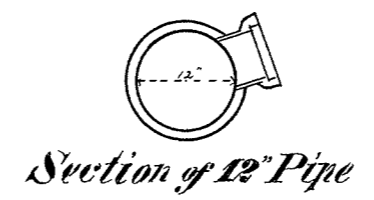


CITY OF SUPERIOR

SEWER PLAN

Contract let Feb. 4, 1892
 completed Sept. 1, 1892
 Wolf & King, Contractor
 H. A. Carlson, Inspector
 A. S. Cooper, City Engr

1893

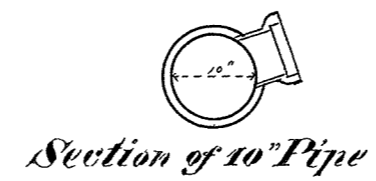

5-14