


**CITY OF SUPERIOR**  
**SEWER PLAN**

Contract let. Feb. 4, 1892  
 completed Sept. 1, 1892  
 Wolf & King, Contractor  
 Jos. P. Duff & H. A. Carlson, Inspectors  
 A. S. Cooper, City Engineer

1893

Scale: Horizontal 60ft. = 1 inch  
 Vertical 4ft. = 1 inch  
 Section 4ft. = 1 inch

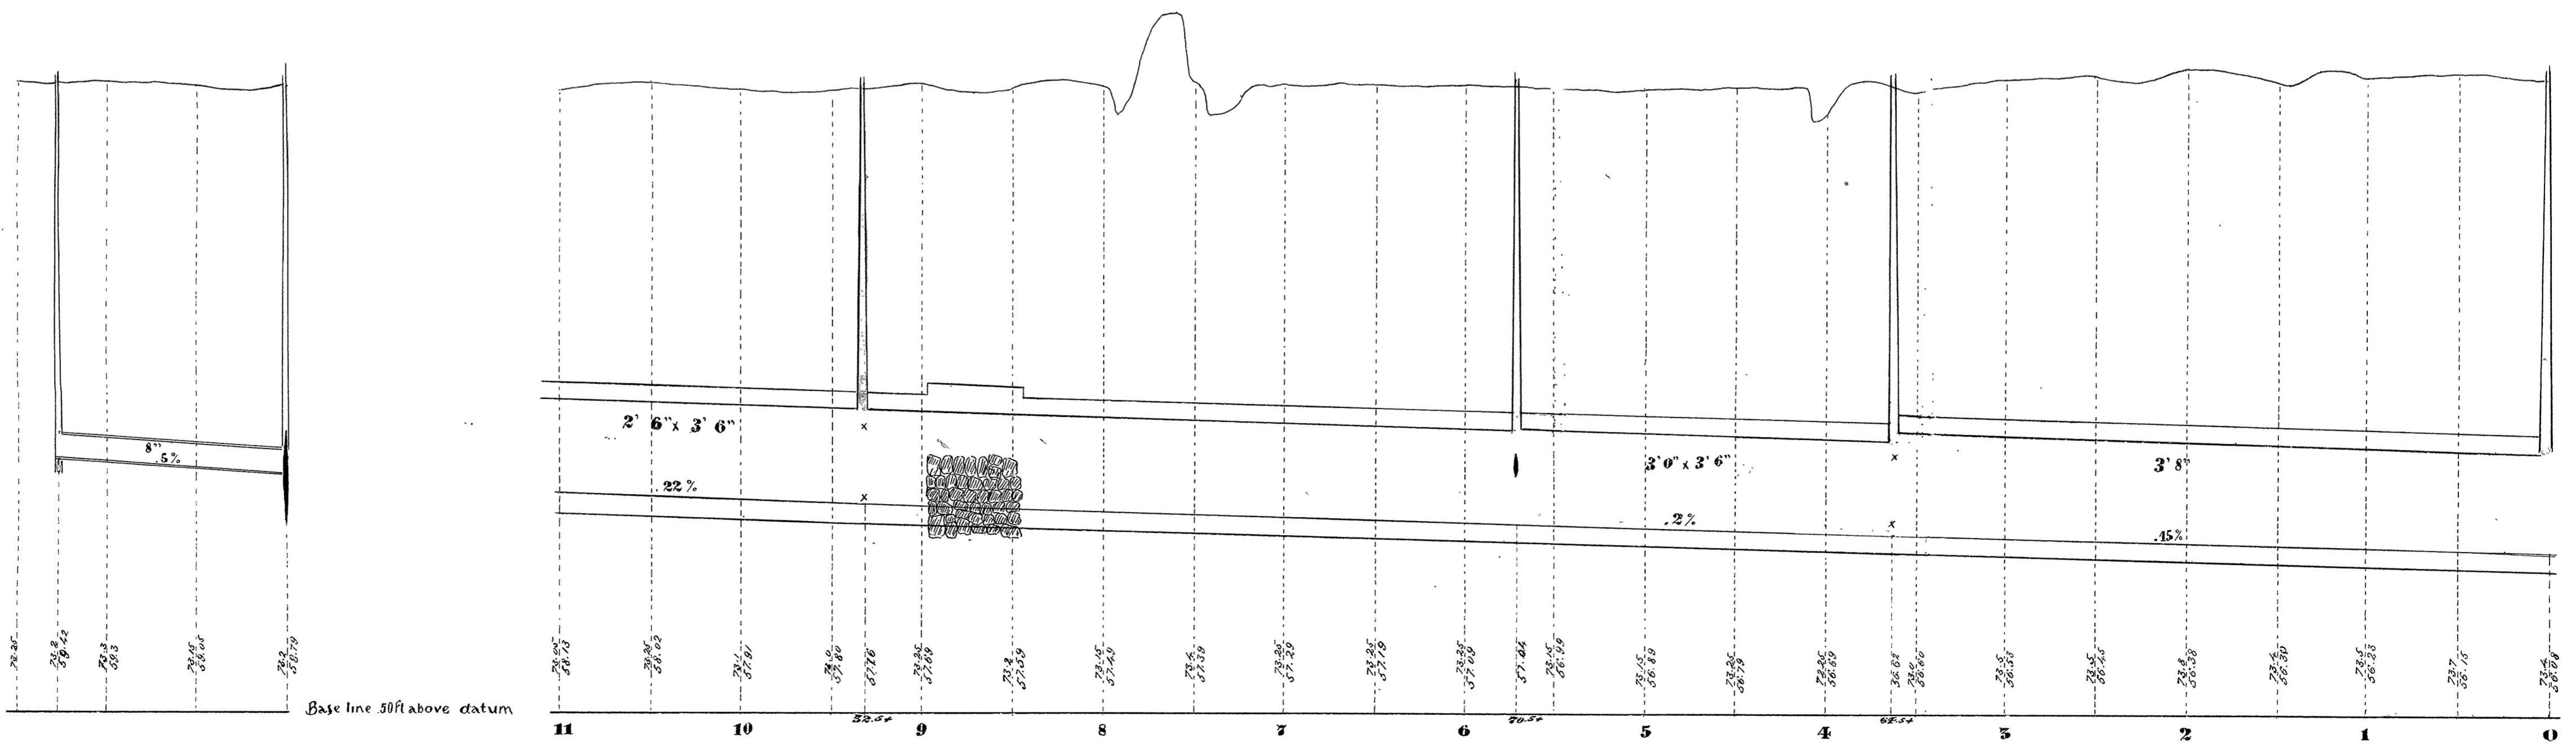

Profile of Sewer from A to B

Plan & Profile of Sewer in John Ave. and Alley North of Central Ave. from Alley South of Central Ave. to Tower Ave.