



CITY OF SUPERIOR

1893

SEWER PLAN

Contract let Feb. 4, 1892  
 completed Sept. 1, 1892  
 Wolf & King, Contractor.  
 H. A. Carlson, Inspector  
 A. S. Cooper, City Eng'r.

Scale: { Horizontal 60 ft. = 1 inch  
 Vertical 4 ft. = 1 inch  
 Section 4 ft. = 1 inch  
 2 ft. = 1 inch

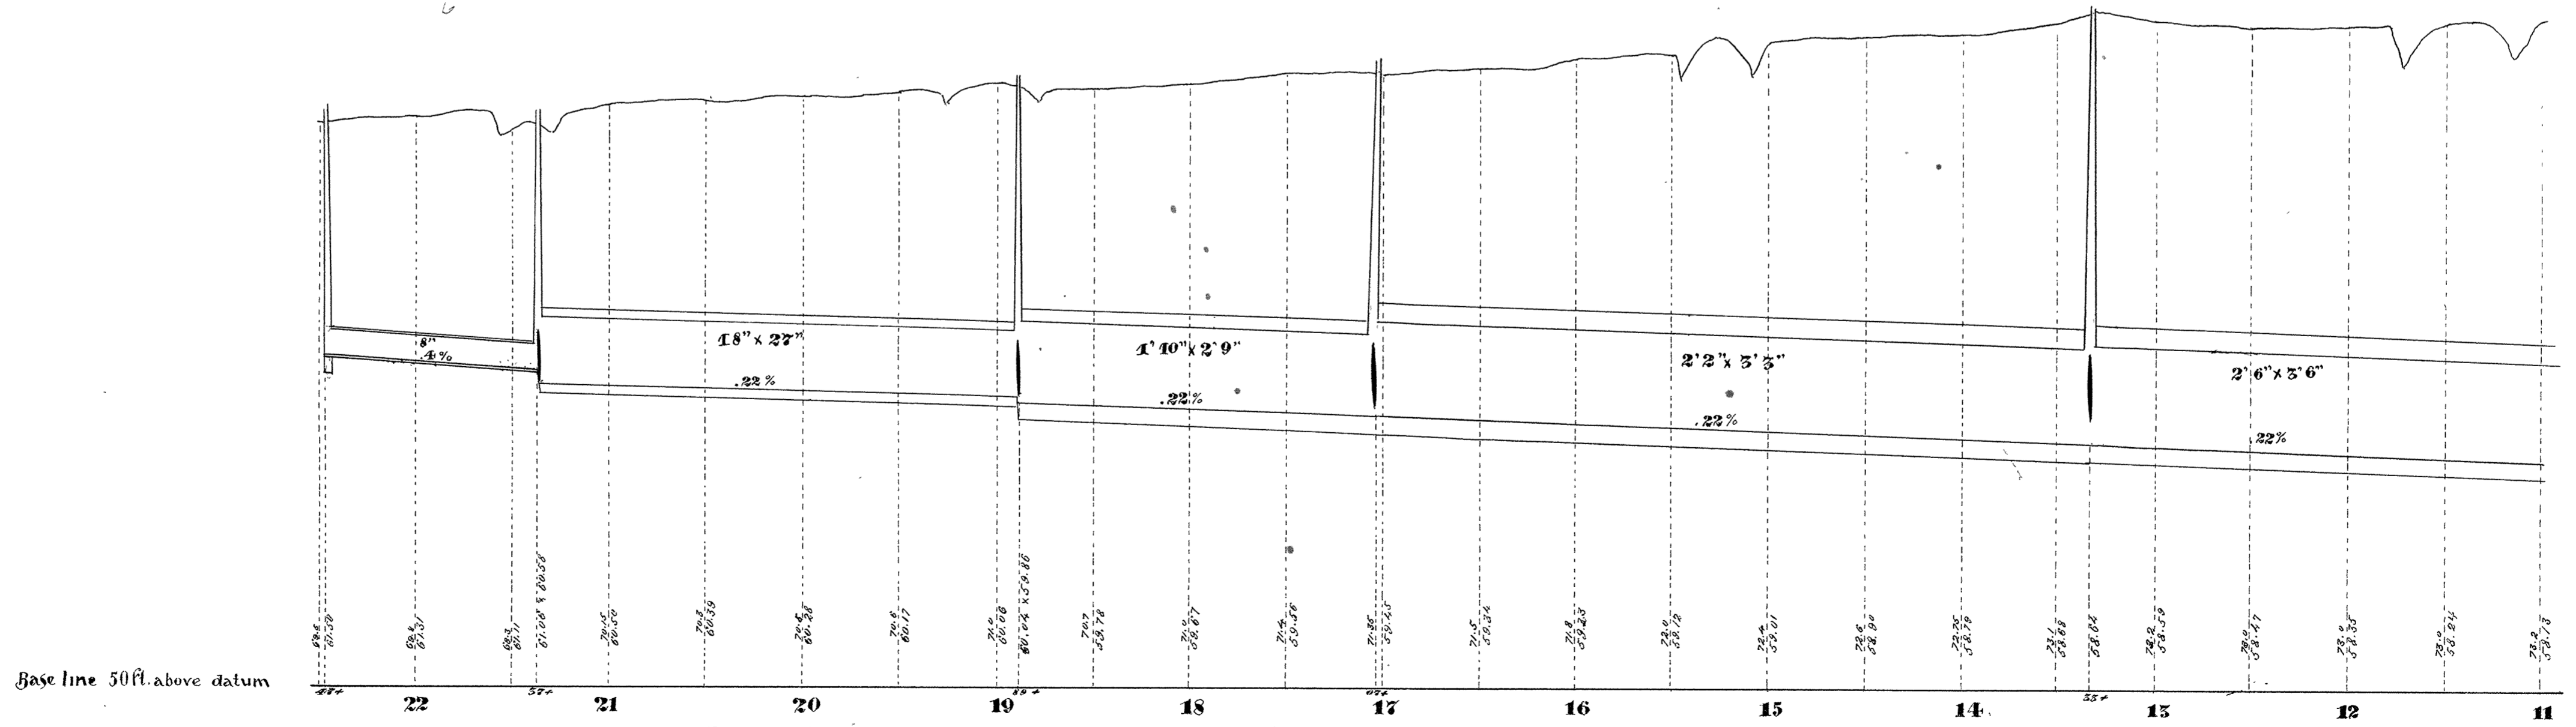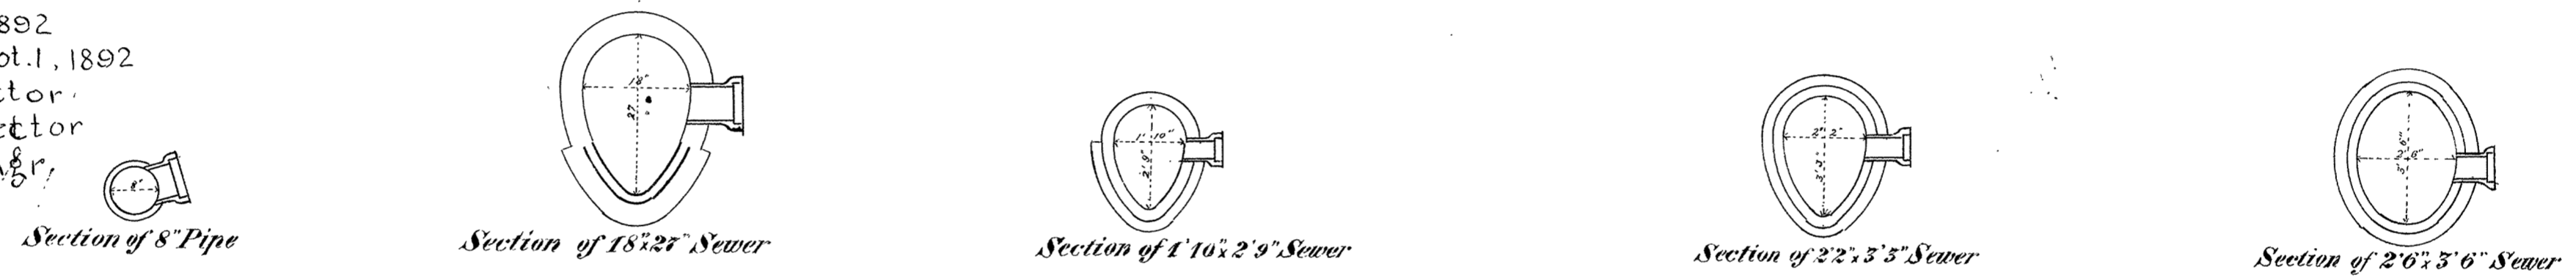

Base line 50ft. above datum

Plan & Profile of Sewer in Alley North of Central Ave. from Tower Ave. to Railway