
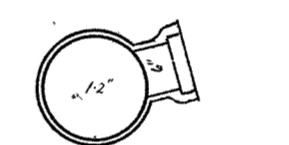
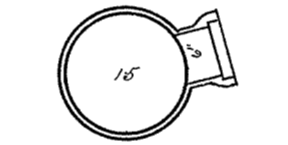



Scale: { Horizontal 60' = 1"
Vertical 4' = 1"
Section 2' = 1"

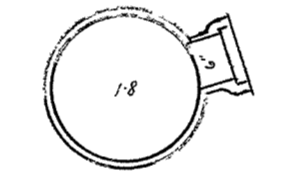

CITY OF SUPERIOR

SEWER PLAN

Contract let April 20, 1893
Completed Aug. 13, 1893
Monks Bros. Contractor
James Dever. Inspector
A. J. Thomas, City Engineer

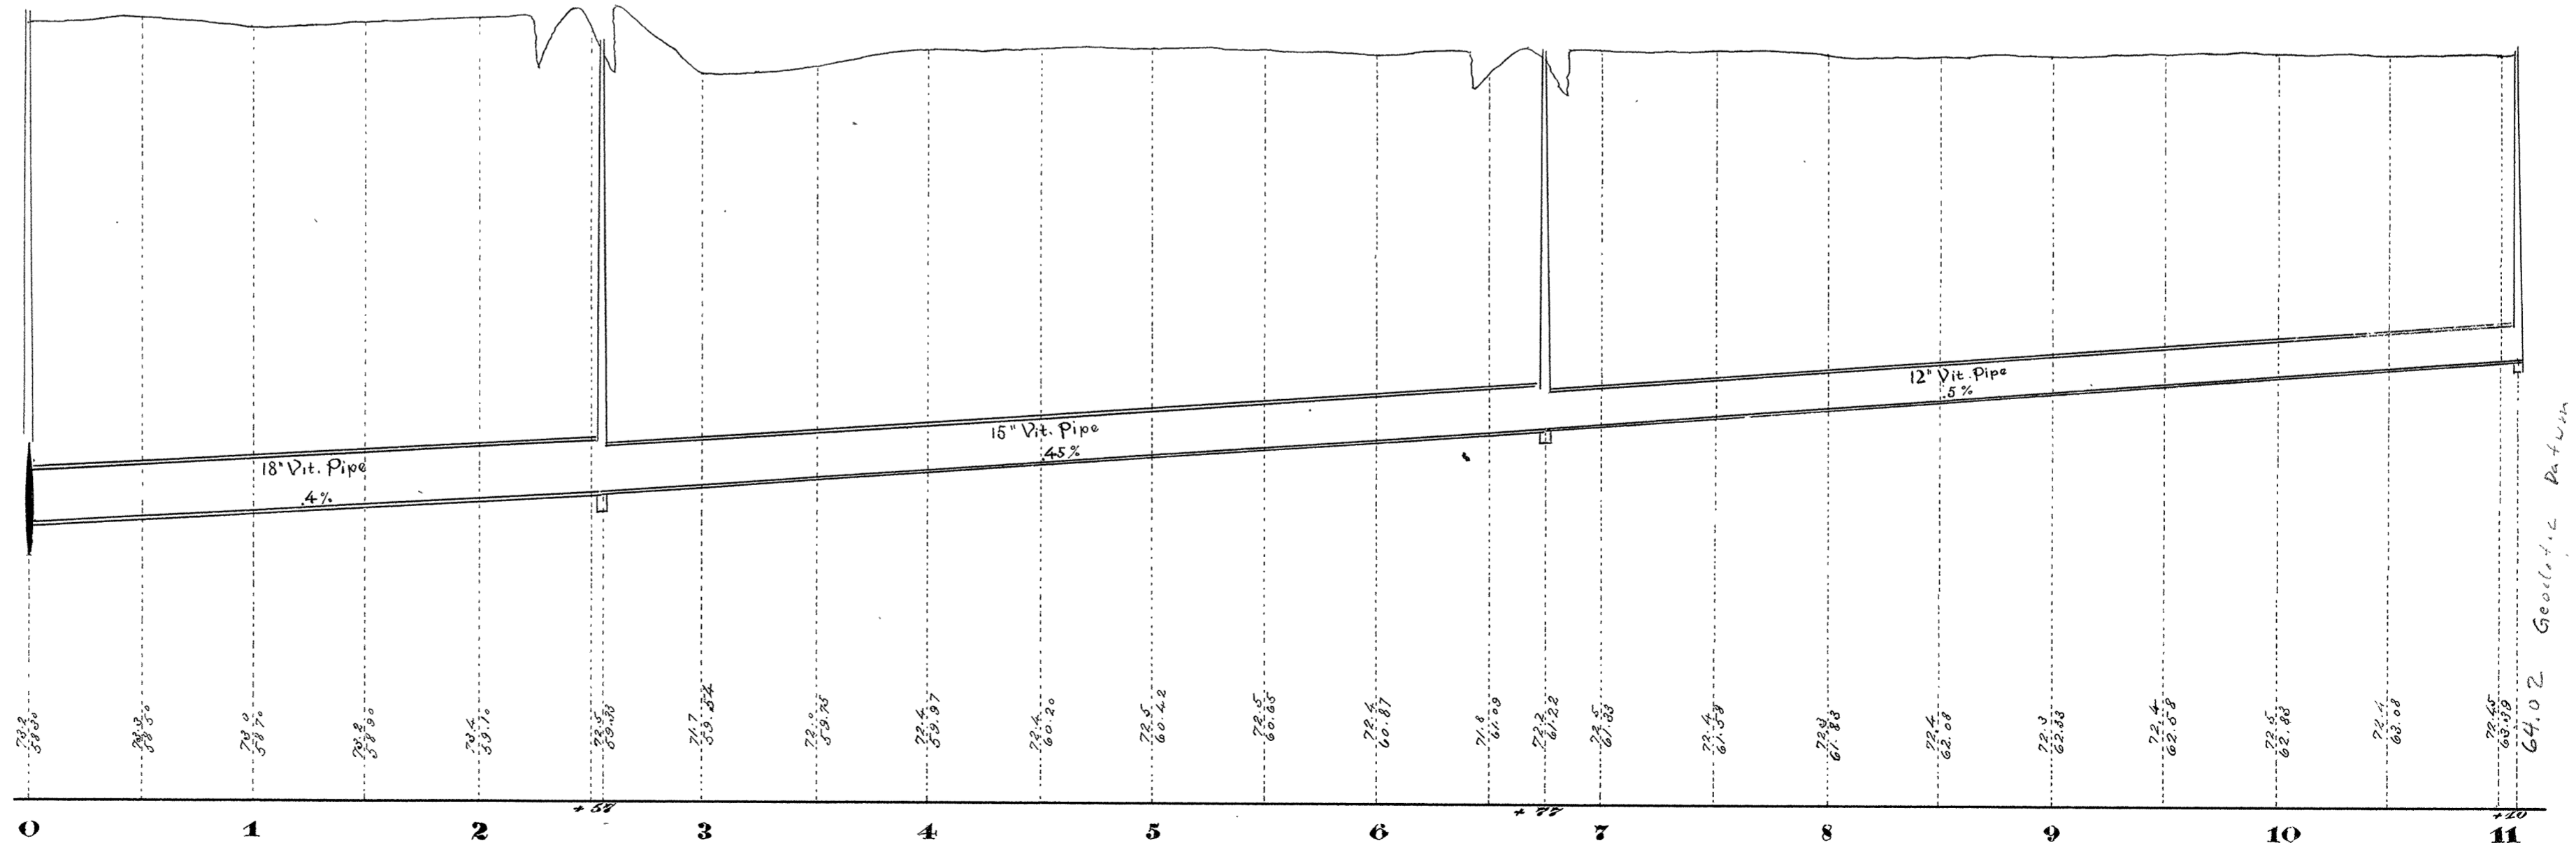

Base line 50' above City Datum

Plan & Profile of Sewer in Alley betw. Ogden & Tower Aves. from Central Ave. to Sixtyfourth St.

5-23