


CITY OF SUPERIOR SEWER PLAN

HORIZONTAL SCALE 1" = 60'
 VERTICAL SCALE 1" = 4'
 JOB STARTED MARCH 1938
 JOB COMPLETED APRIL 1938
 W.P.A. LABOR
 W.HANCHETT INSPECTOR
 T.M.BASTERASH CITY ENGINEER

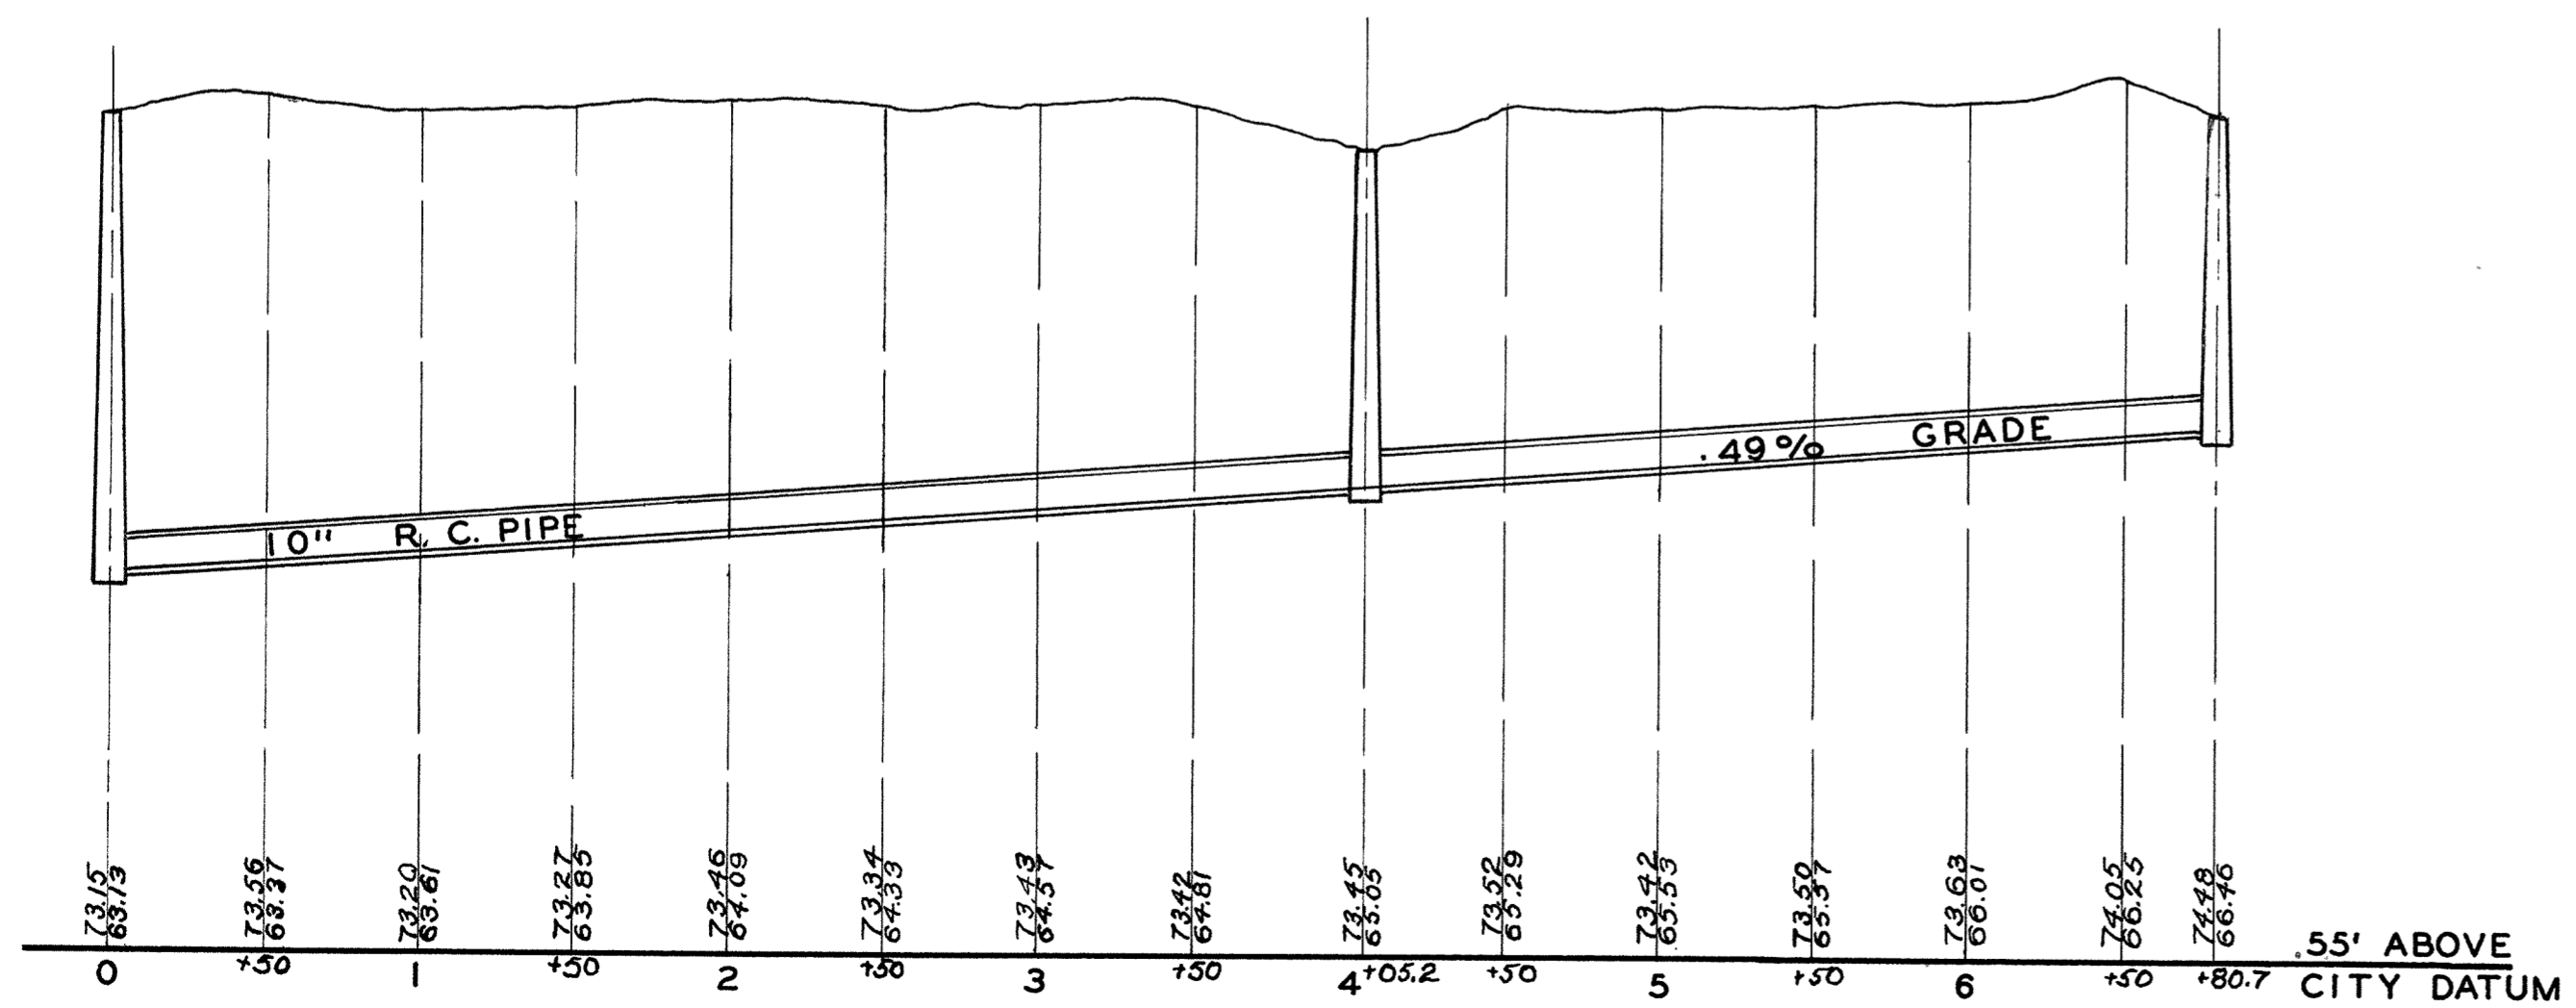

5-31A