


Horizontal Scale: 1 in. = 80 ft.  
 Vertical Scale: 1 in = 4 ft.  
 CONTRACT No 1432  
 Contract let July 10, 1914.  
 Contract completed Nov. 25<sup>th</sup> 1914.  
 William Danforth Contractor.  
 Marlin Nelson Inspector.  
 E.B.Banks City Engineer.

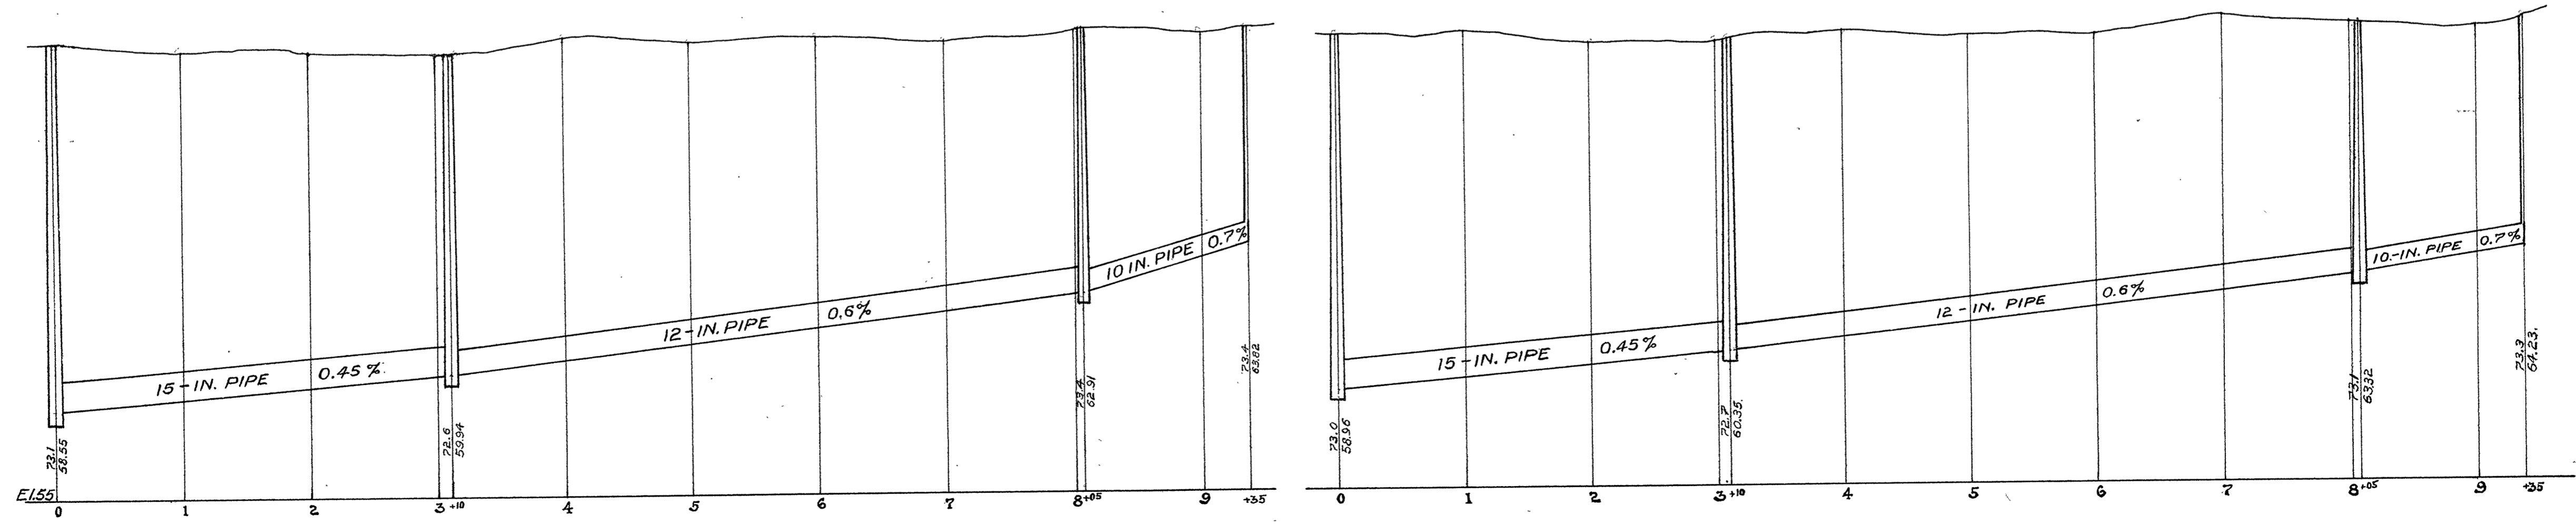

5-32