



Horizontal Scale: 1in = 80ft.
 Vertical Scale: 1in = 4ft.
 CONTRACT N^o 14-32
 Contract let: July 10, 1914.
 Contract completed: Nov. 25th 1914
 William Danforth Contractor.
 Martin Nelson Inspector.
 E.B.Banks: City Engineer.

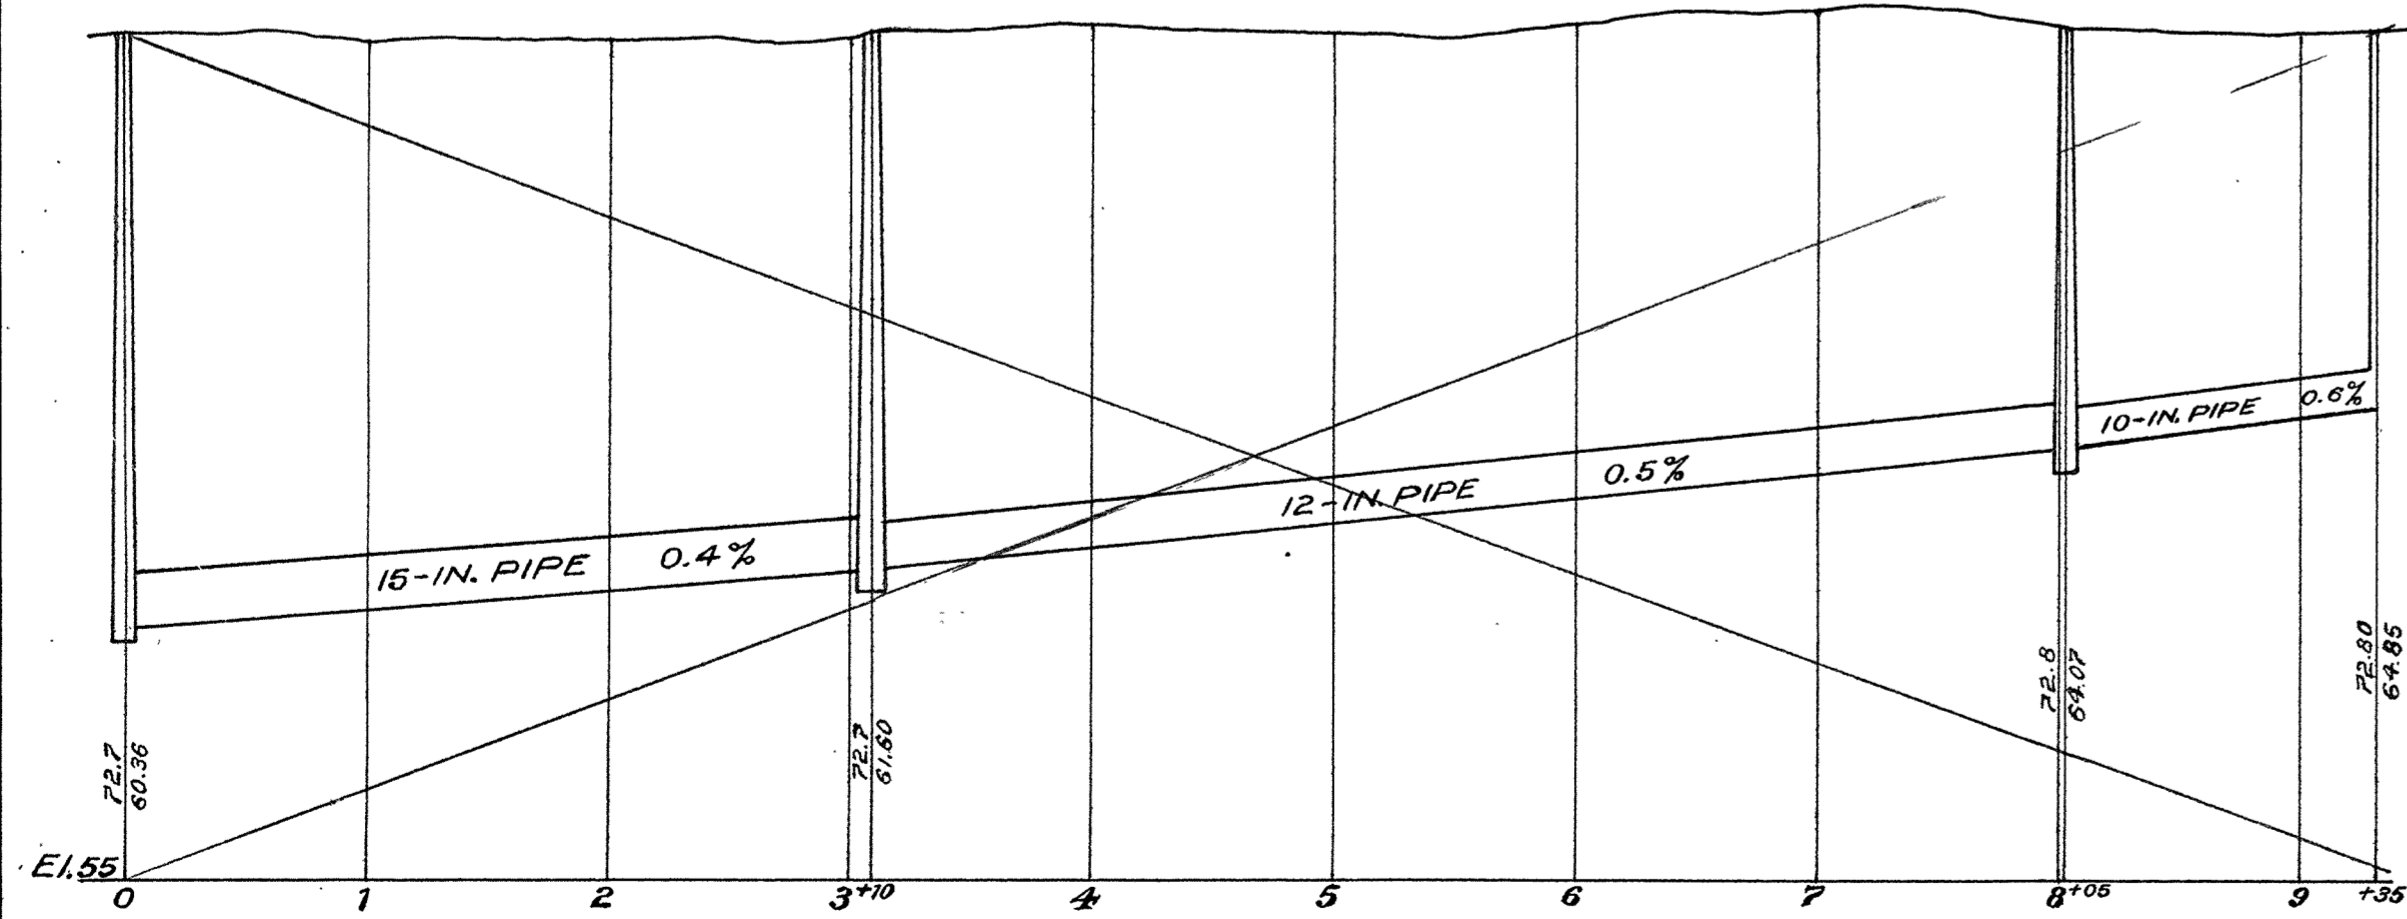

VOID - SEE 33A

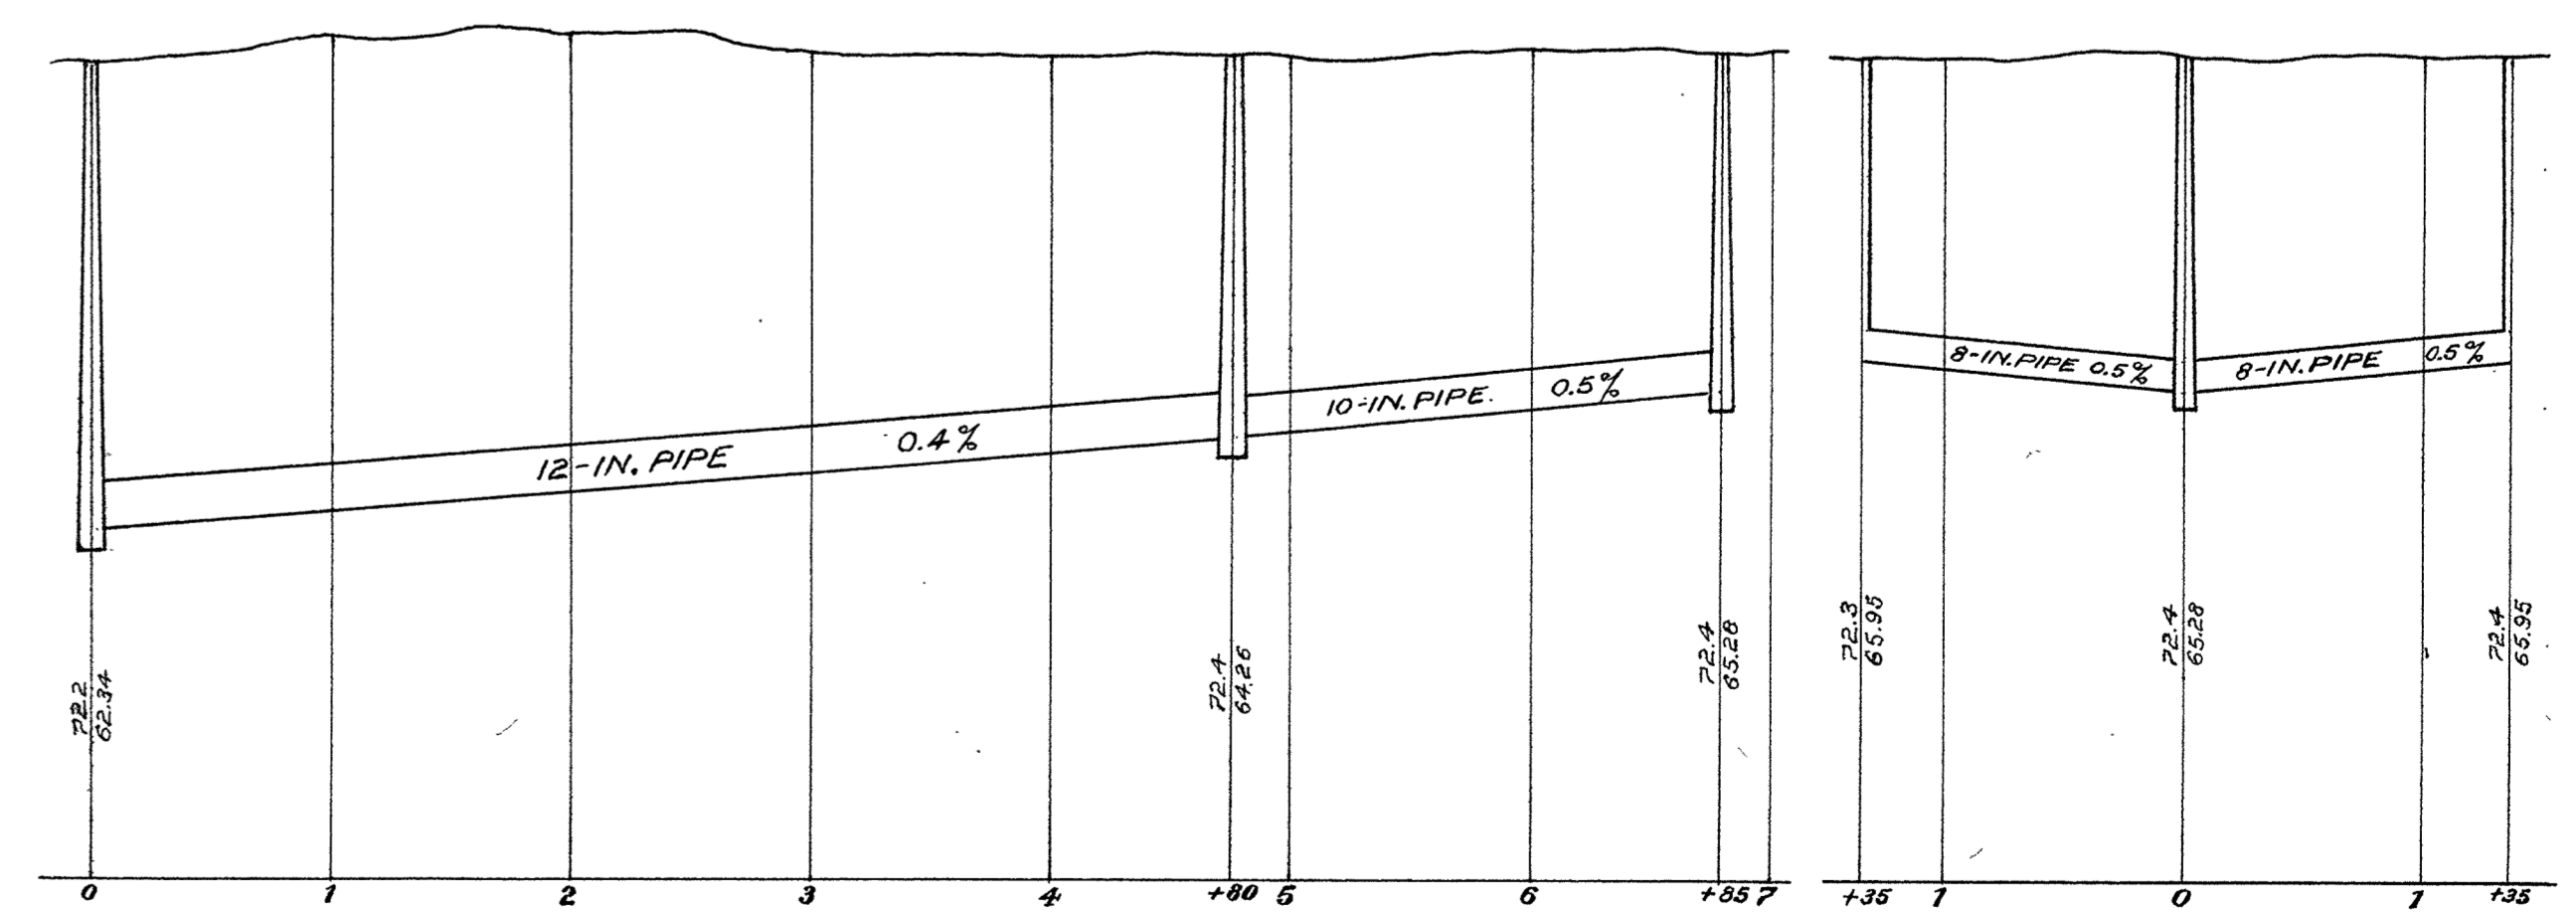

5-33