

HAMMOND AVE.


52 ND ST

M.H. 19+97.83

M.H. 24+02.36

M.H. 28+02.69

M.H. 32+03.64

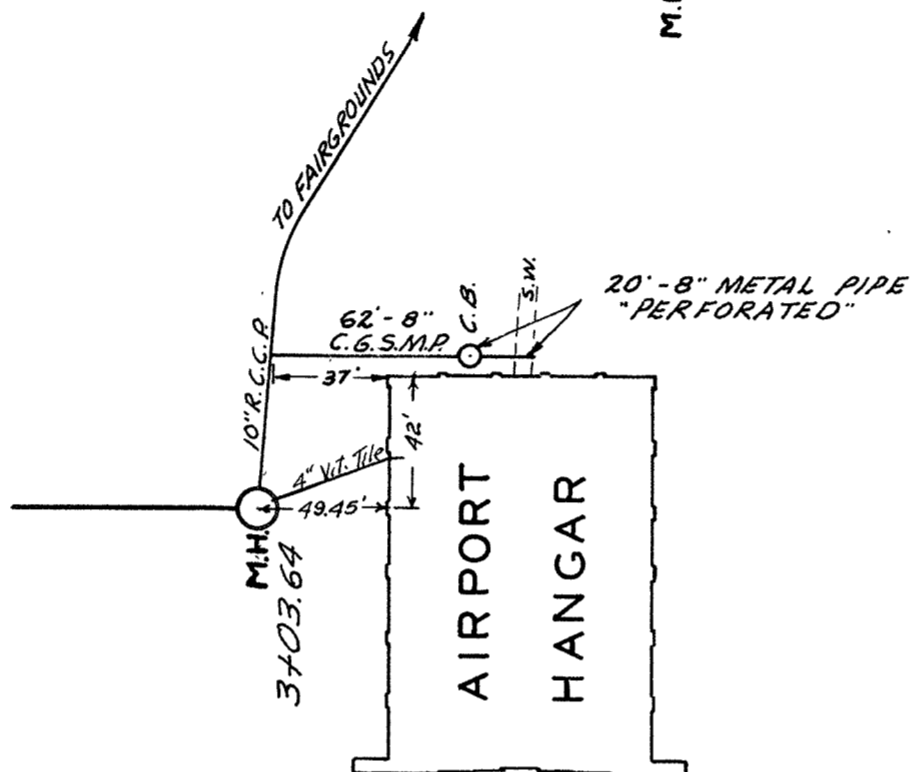

CITY OF SUPERIOR
SEWER PLAN


HORIZONTAL SCALE 1" = 60'
VERTICAL SCALE 1" = 4'

W.P.A. LABOR INSPECTOR
W.P.A. ENG.

JOB STARTED JUNE 1938

JOB COMPLETED AUGUST 1938

T.M. BASTERASH CITY ENGINEER

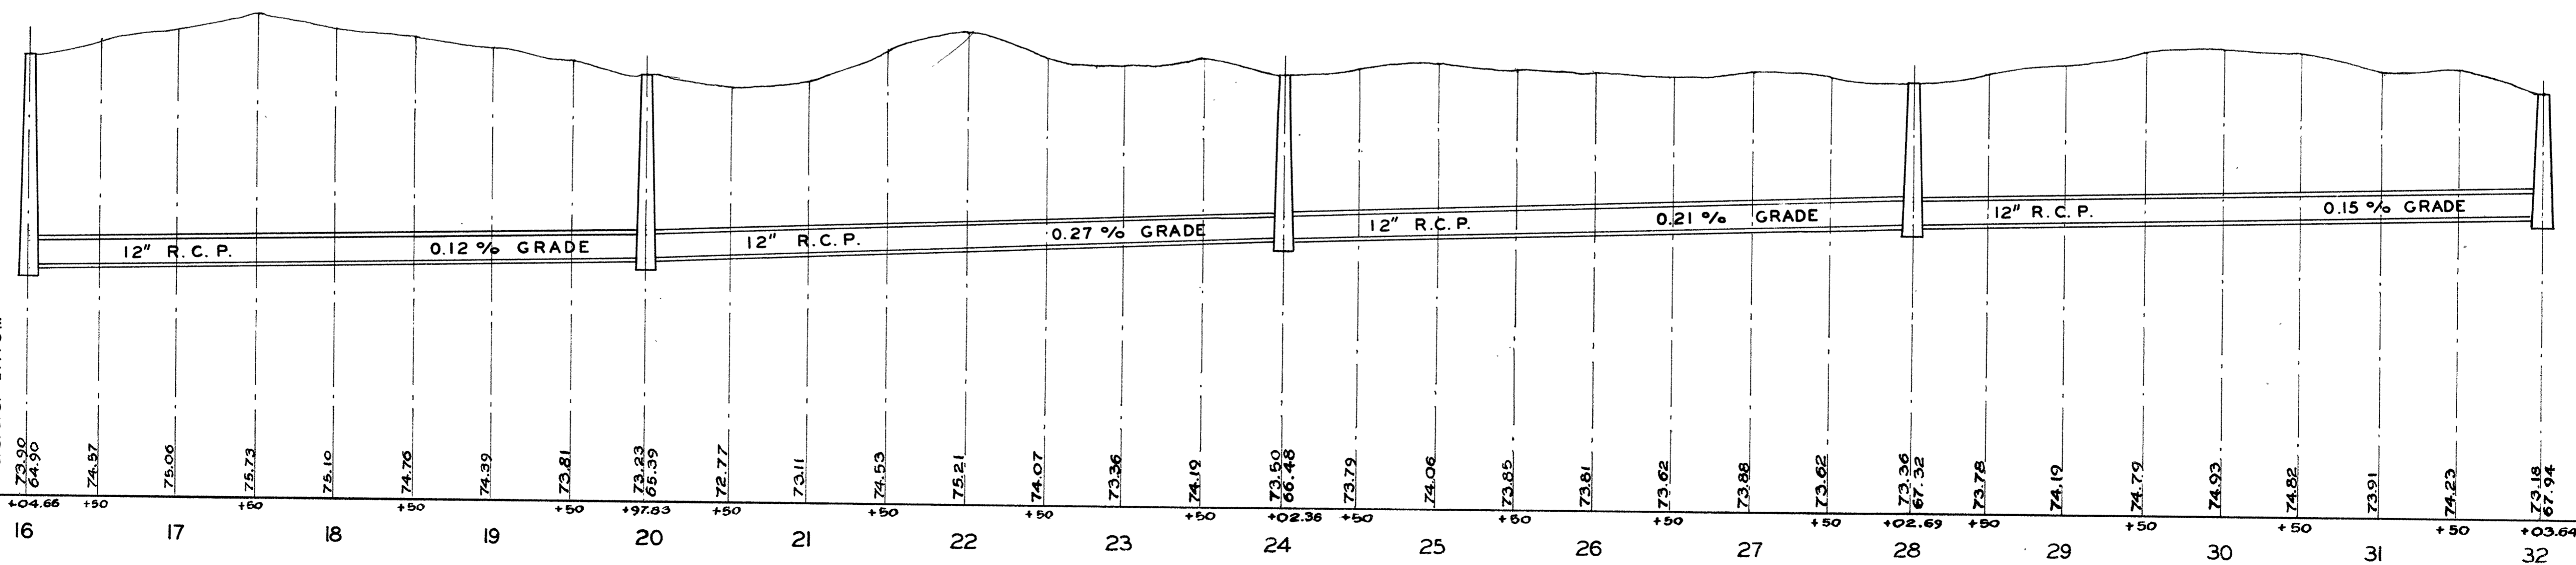

5-33B