



MAP AND PROFILE
 SHOWING SEWER FROM MAIN SEWER
 IN ALLEY SO. OF CENTRAL AVE. TO
 ALLEY SO. OF 58TH ST. BETWEEN BAXTER
 AND LAMBORN AVE'S.

HORIZONTAL SCALE: 1/IN=100 FT.
 VERTICAL SCALE: 1/IN= 6 FT.
 CONTRACT No. 1650
 CONTRACT LET
 CONTRACT COMPLETED
 CITY OF SUPERIOR CONTRACTOR
 NICK ANDERSON INSPECTOR
 E.B.BANKS CITY ENGINEER

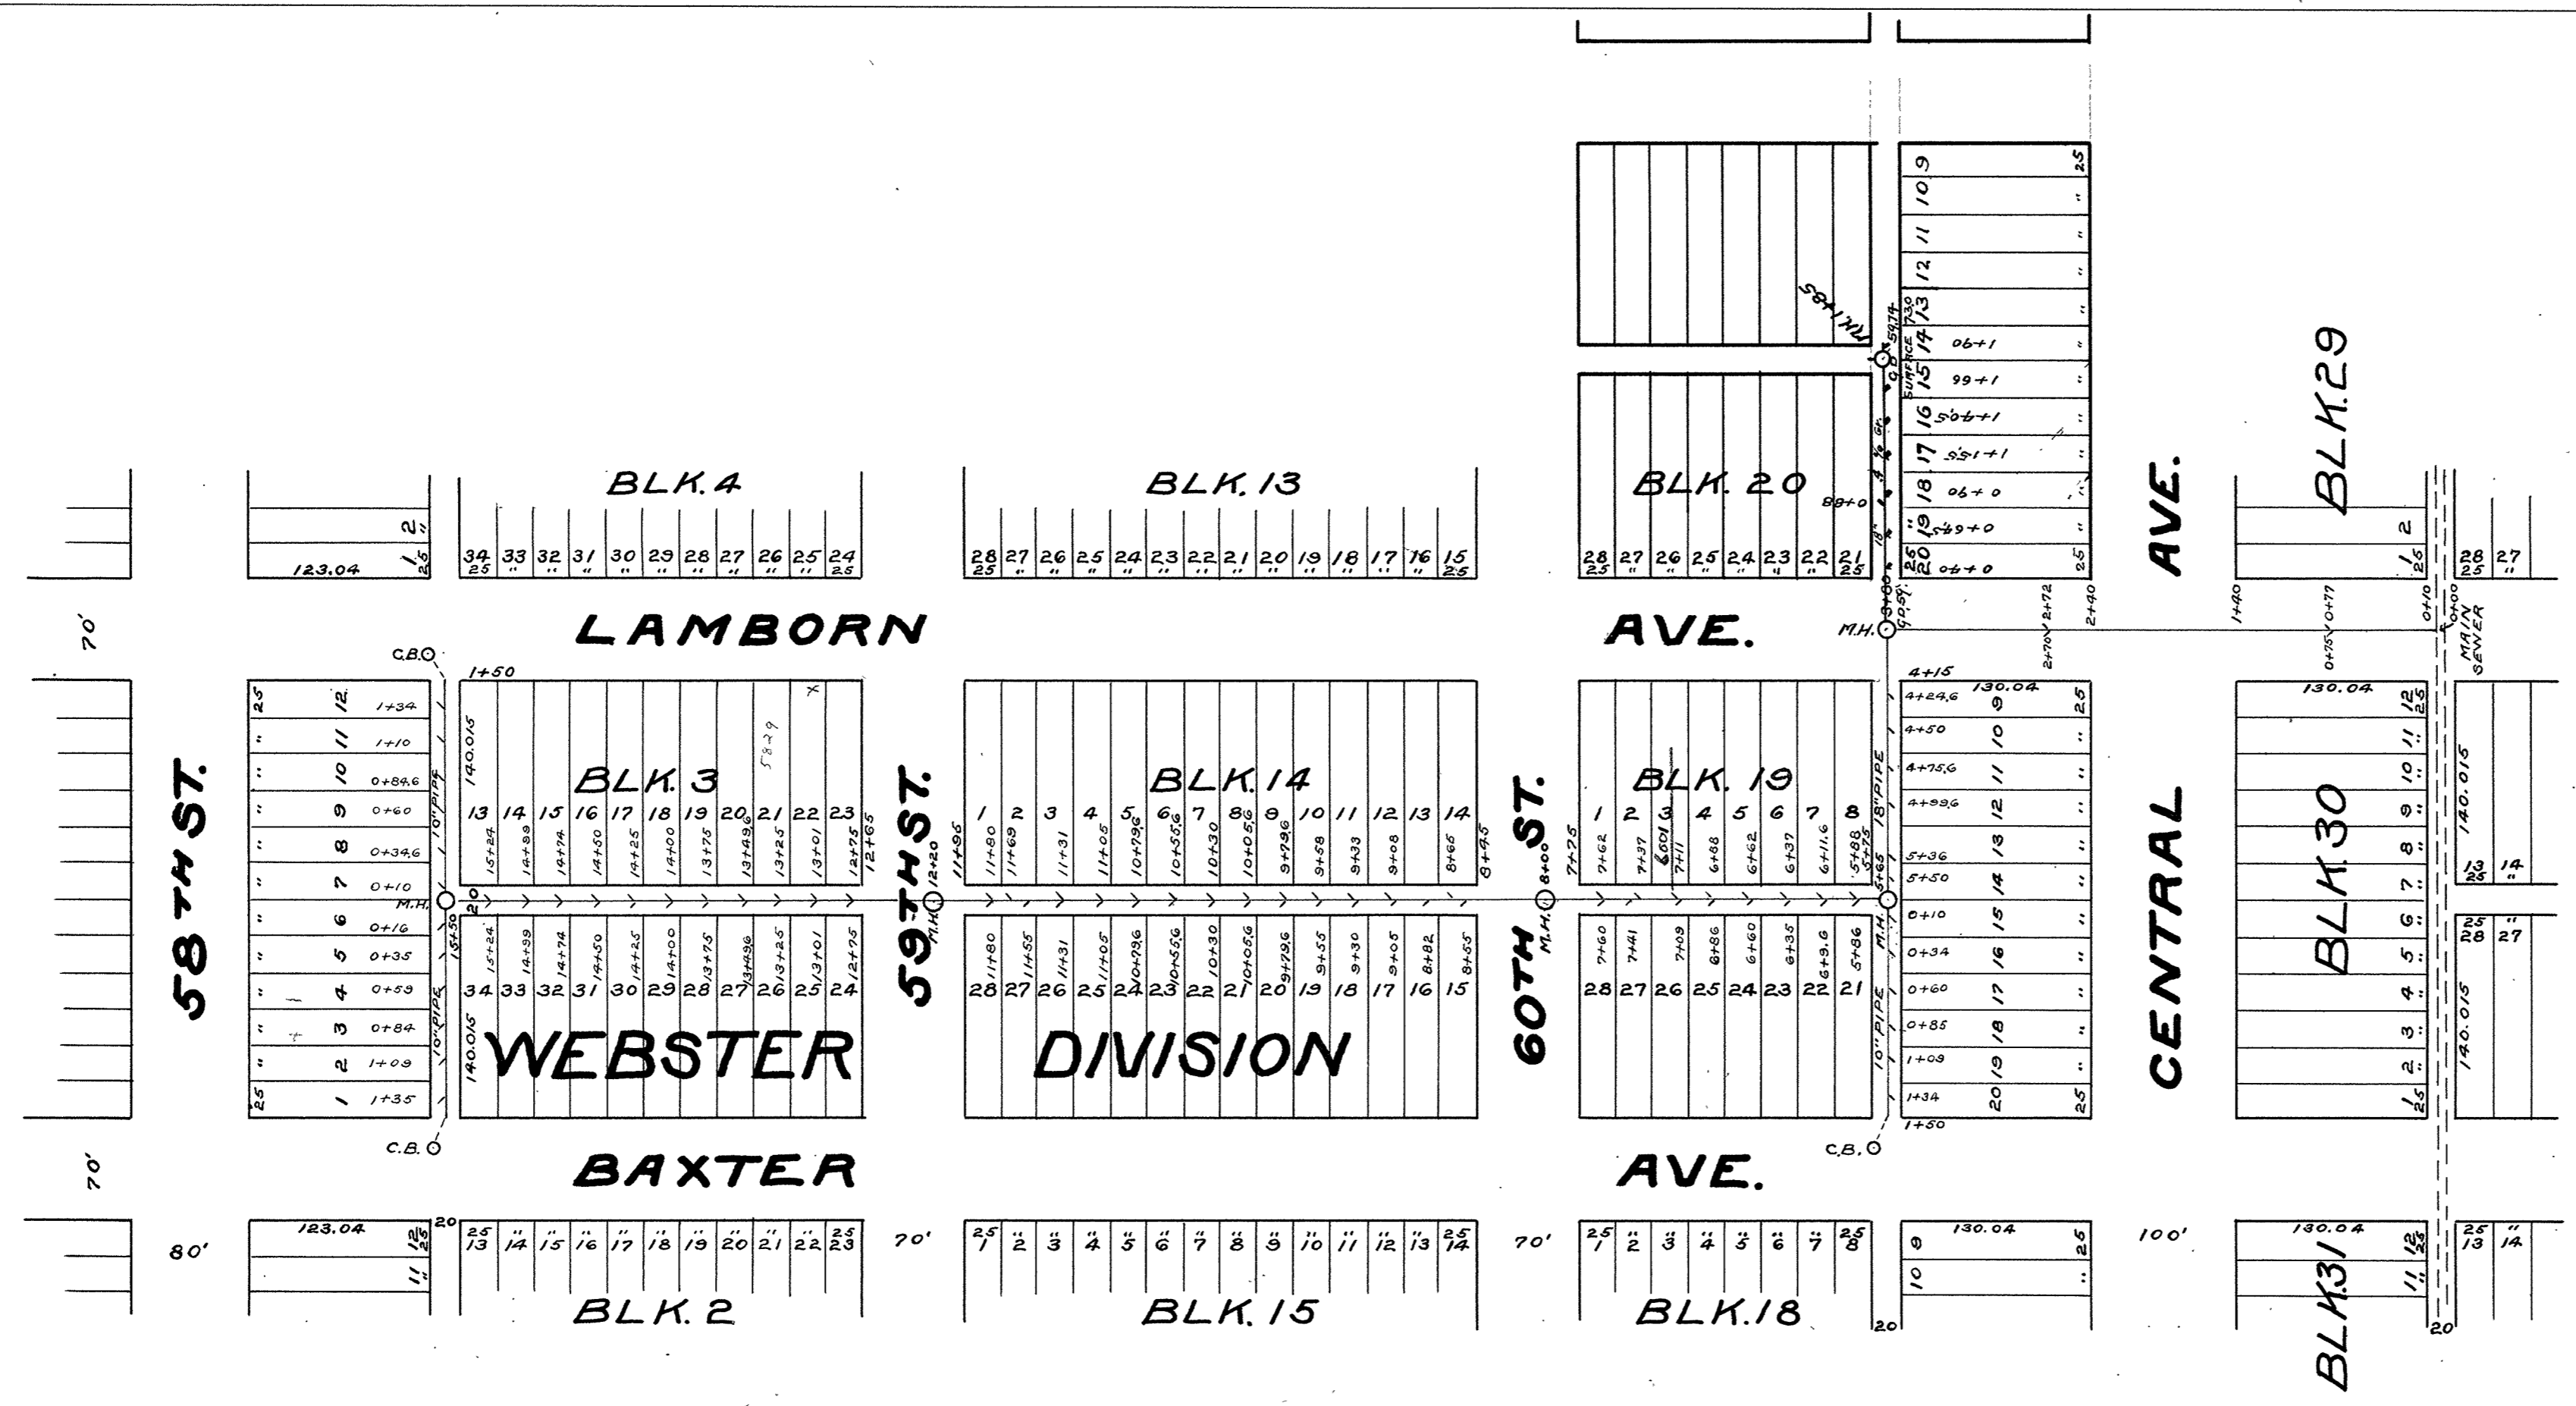

LATERAL SEWER
 TO SERVE LOTS 15 TO 20 BLK. 19

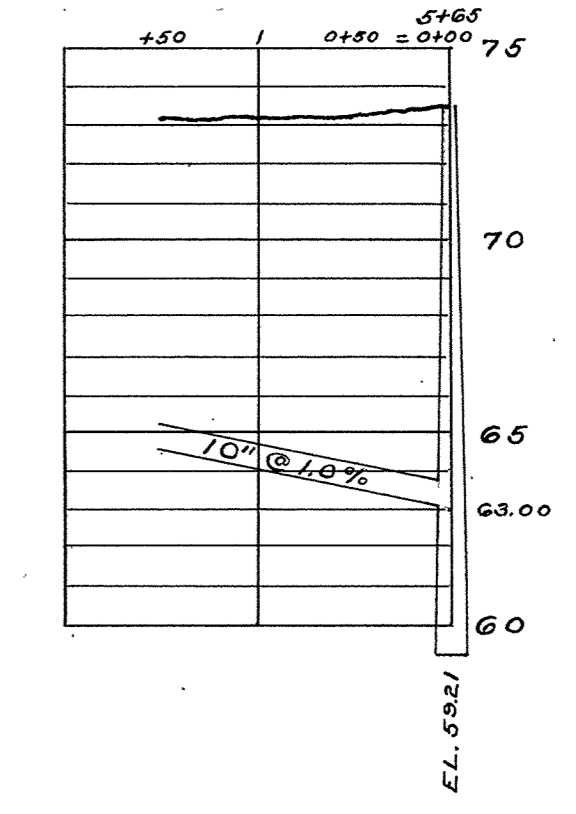

LATERAL SEWER
 TO SERVE LOTS 1 TO 12 BLK. 3

