


FIFTY-EIGHTH STREET

CITY OF SUPERIOR SEWER PLAN

HORIZONTAL SCALE: 1"=60'
VERTICAL SCALE: 1"= 4'

JOB STARTED MAR. 1936
JOB COMPLETED APR. 1938
W.P.A. LABOR
M.SKAMSER INSPECTOR
L.W.PELESKE CITY ENGINEER

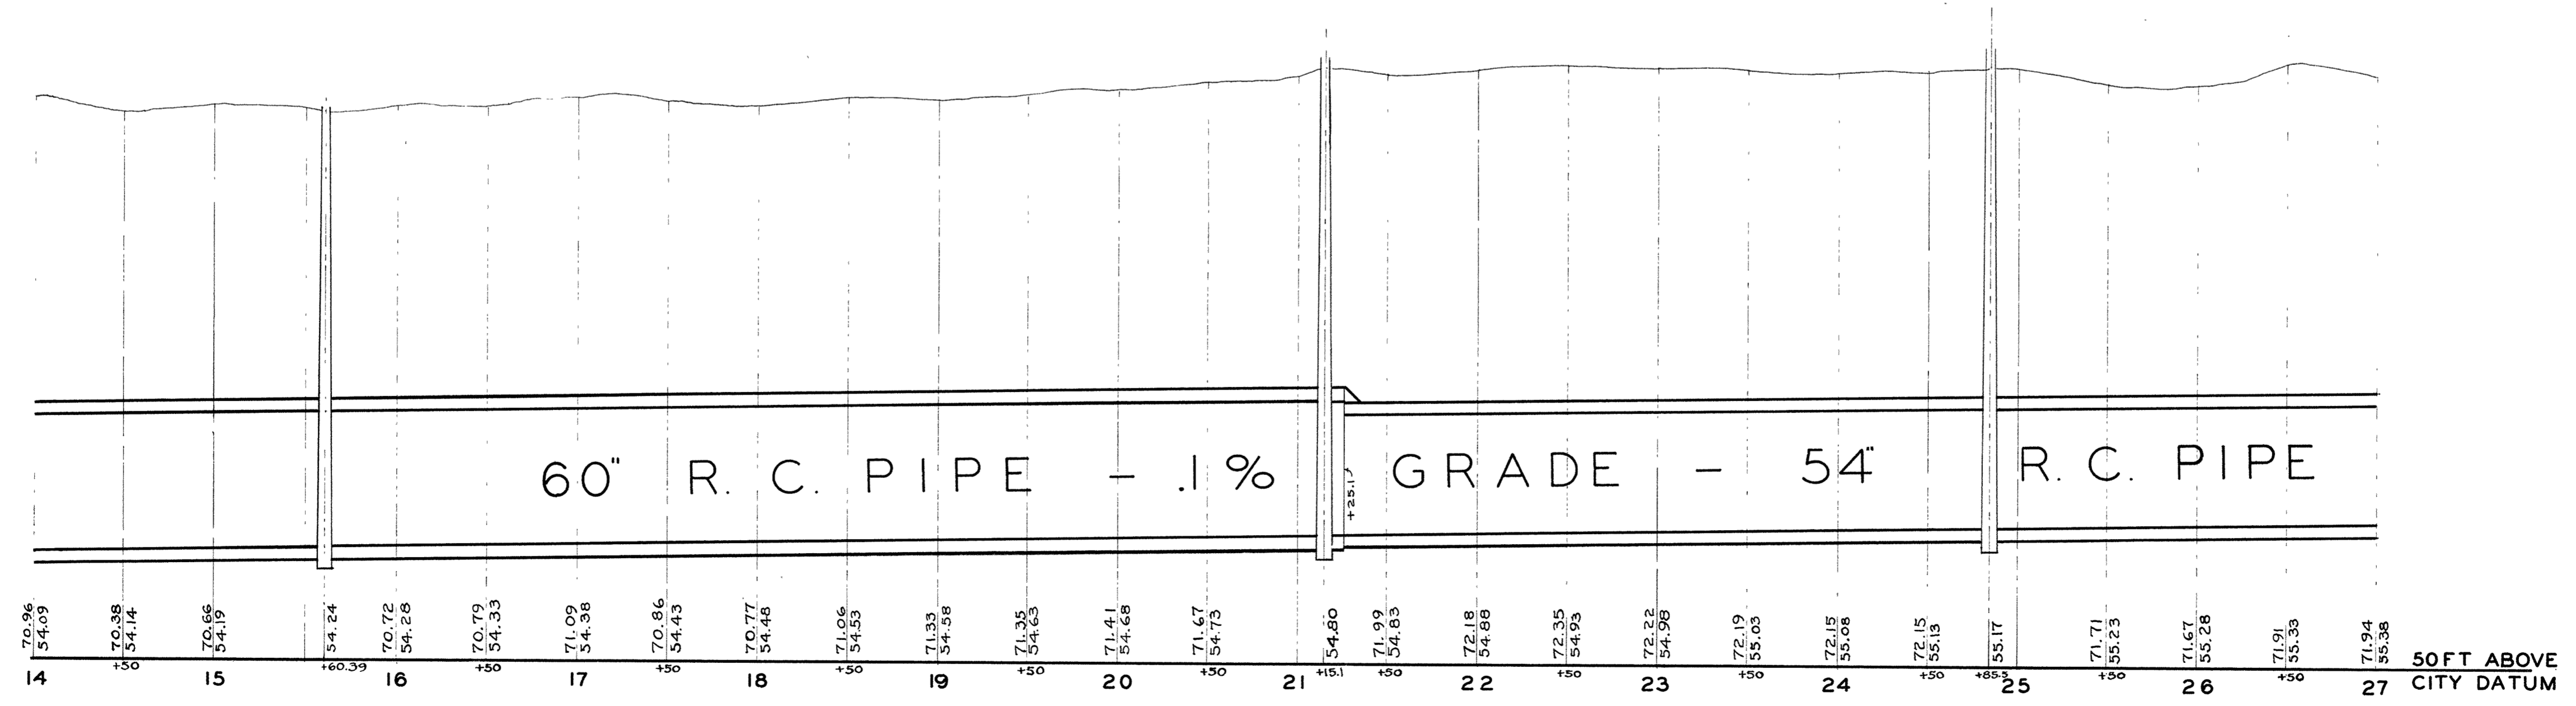

60" R. C. PIPE - .1% GRADE - 54" R. C. PIPE

14	70.96 54.09	15	70.98 54.14	16	70.72 54.28	17	71.09 54.38	18	70.86 54.43	19	71.33 54.58	20	71.41 54.68	21	71.67 54.73	22	72.18 54.88	23	72.35 54.93	24	72.15 55.08	25	72.15 55.13	26	71.71 55.23	27	71.91 55.33
----	----------------	----	----------------	----	----------------	----	----------------	----	----------------	----	----------------	----	----------------	----	----------------	----	----------------	----	----------------	----	----------------	----	----------------	----	----------------	----	----------------

50 FT ABOVE
CITY DATUM