
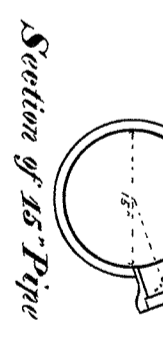


CITY OF SUPERIOR

SEWER PLAN

Contract let May 23, 1892
 completed Nov 1, 1892
 Johnson & Dole, Contractor
 H. A. Carlsson, Inspector
 A. S. Cooper, City Engineer

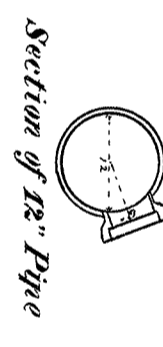

Scale: { Horizontal 60ft. = 1inch
 Vertical 4ft. = 1inch
 Section 2ft. = 1inch

