


58TH STREET

CITY OF SUPERIOR SEWER PLAN

HORIZONTAL SCALE 1" = 60'
VERTICAL SCALE 1" = 4'

JOB STARTED JULY 1937
JOB COMPLETED NOV. 1937

W.P.A. LABOR
M. SKAMSER INSPECTOR
T.M. BASTERASH CITY ENGINEER

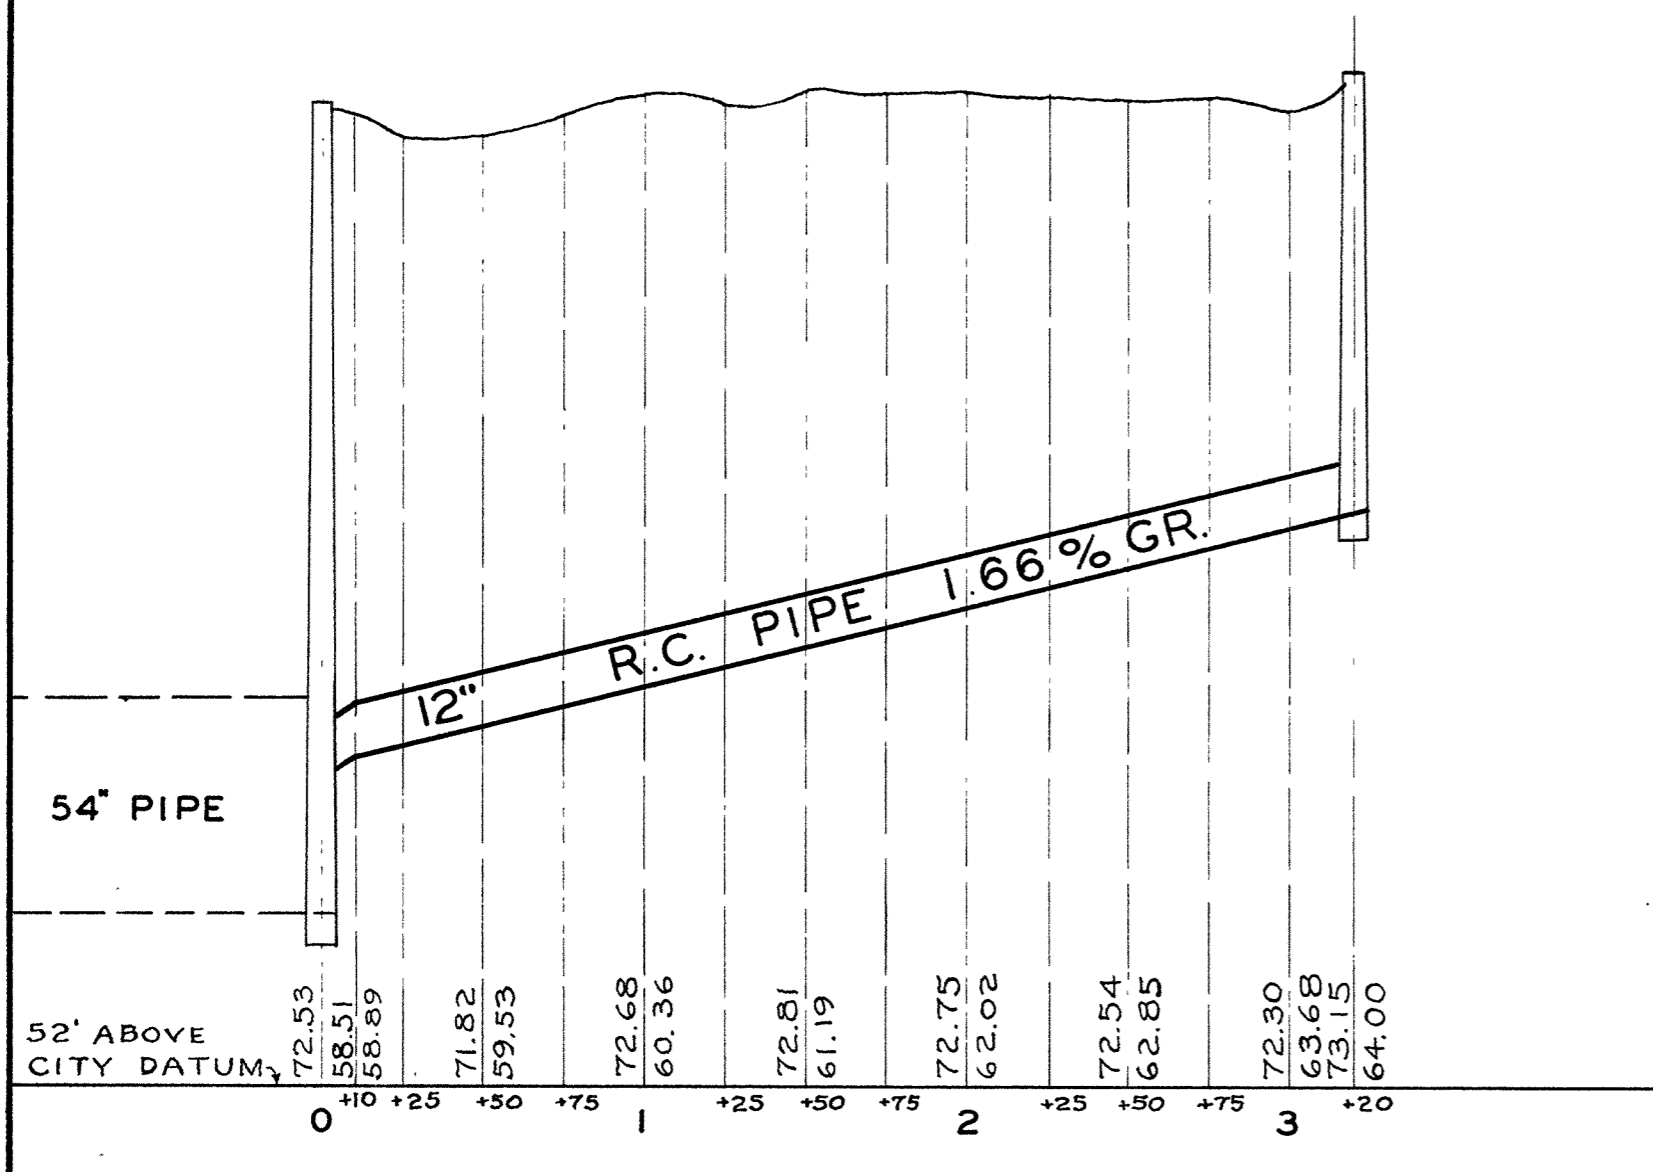

5-41

5-40