


**CITY OF SUPERIOR  
SEWER PLAN**

HORIZONTAL SCALE 1" = 50'  
 VERTICAL SCALE 1" = 4'  
 PUB. WK'S. DIRECTOR L. BARTLETT  
 SEWER COMPLETED 1941  
 FINAL SURVEY OCT. 1946

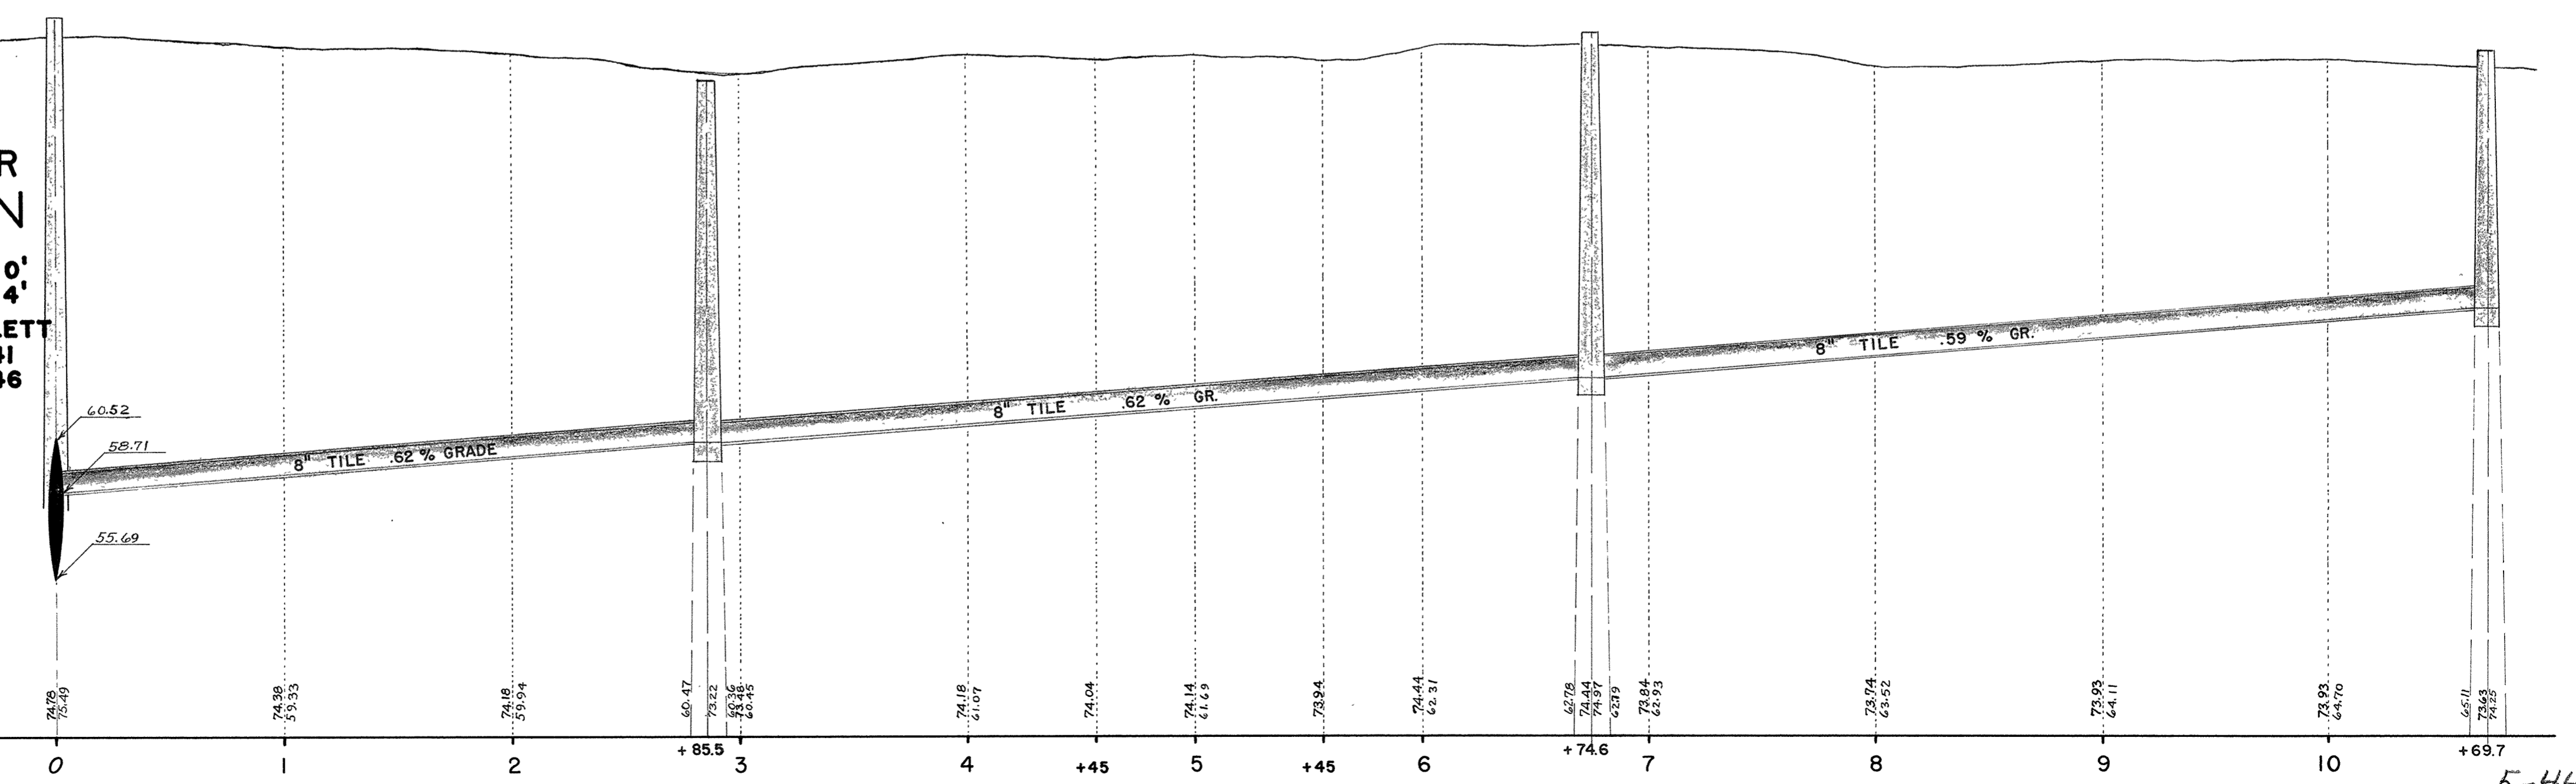

BASE LINE 650 FT. ABOVE -  
CITY GEO. SURVEY DATUM