


CITY OF SUPERIOR  
SEWER PLAN  
HORIZONTAL SCALE 1"=50'  
VERTICAL SCALE 1"=4'  
SEWER COMPLETED 1940  
FINAL SURVEY OCT. 1946  
PUB. WKS. DIRECTOR L. BARTLETT

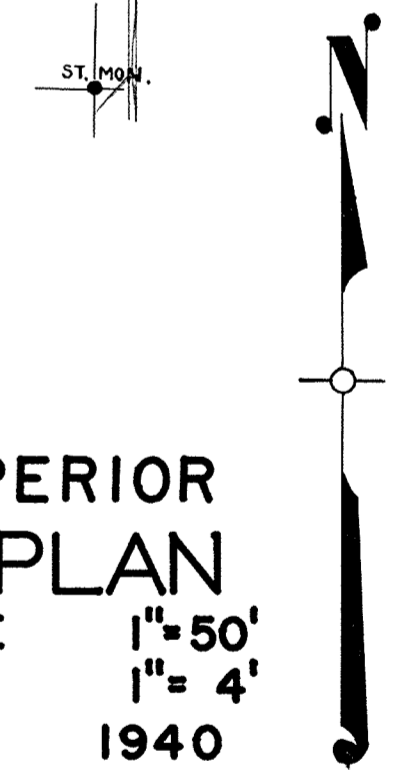

BASE LINE 652 FT. ABOVE  
CITY GEO. SURVEY DATUM