
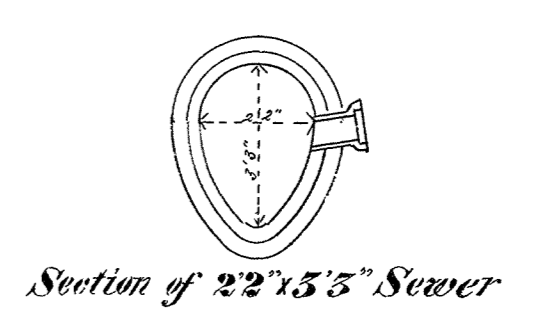
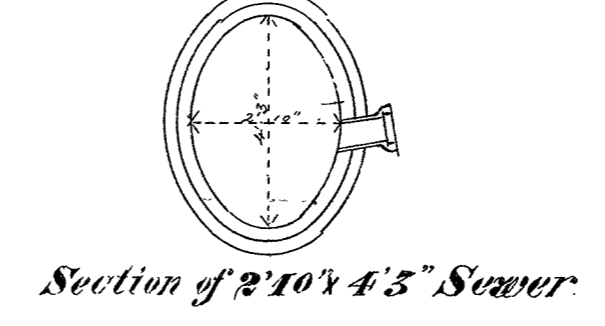
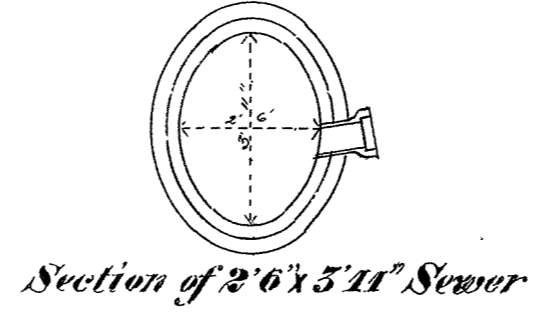


1893


Scale:  $\left\{ \begin{array}{l} \text{Horizontal} \quad 1" = 60' \\ \text{Vertical} \quad 1" = 4' \\ \text{Section} \quad 1" = 4' \end{array} \right.$

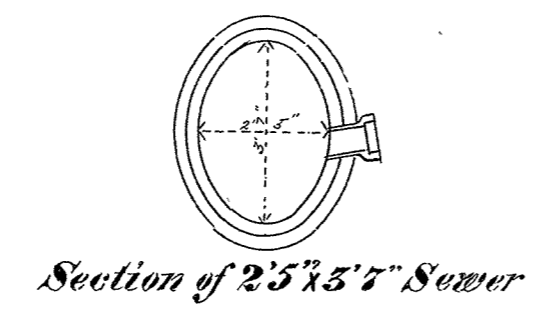

### CITY OF SUPERIOR

### SEWER PLAN

Contract let May 23, 1892  
 completed Oct 12, 1892  
 Wolf & King, Contractor  
 John Daily, Inspector  
 A. S. Cooper, City Engr.

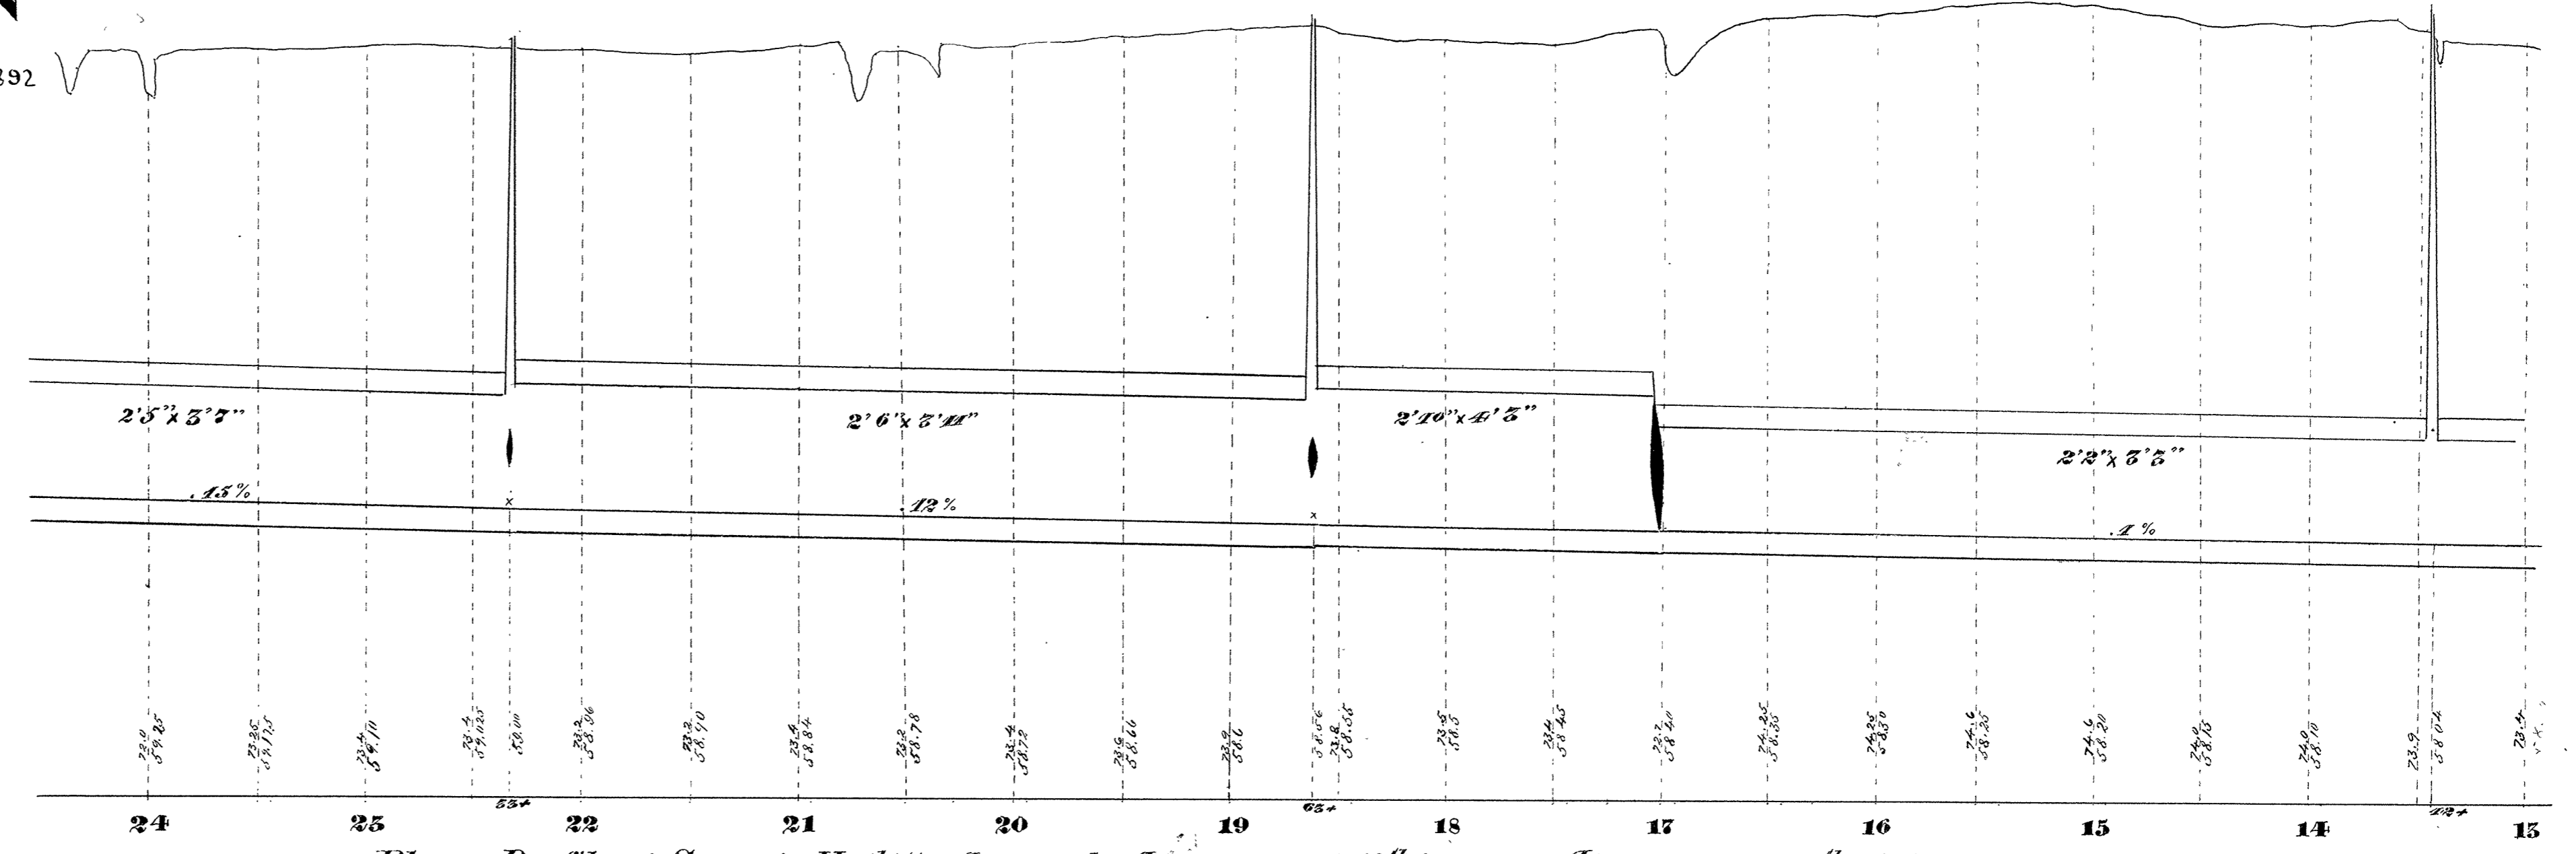

Base line 50' above datum.

Plan & Profile of Sewer in Hughitt Ave. and Alley north of 58<sup>th</sup> St. from Alley south of 58<sup>th</sup> St. to Ogdén Ave.