


INSTALLED DRIVEWAY-TYPE COVER
ON CB3

CB6 (TYPE 3A) IS FREE STANDING;
DOES NOT LIE ON TOP OF EXISTING 18 IN. SS

CONCRETE COLLAR CONNECTION
12 IN. RCPSS TO EXISTING 8 IN. PVC

STA. 479+25, 41' LT.
EXISTING INLET LEFT IN PLACE
REBUILT AS MH WITH TYPE K COVER
(MH 3A)

STATE PROJECT NUMBER
8010-13-71
SHEET NO.
2.14
TOWER AVENUE, CITY OF SUPERIOR
STORM SEWER PLAN
S.T.H. 35 DOUGLAS COUNTY

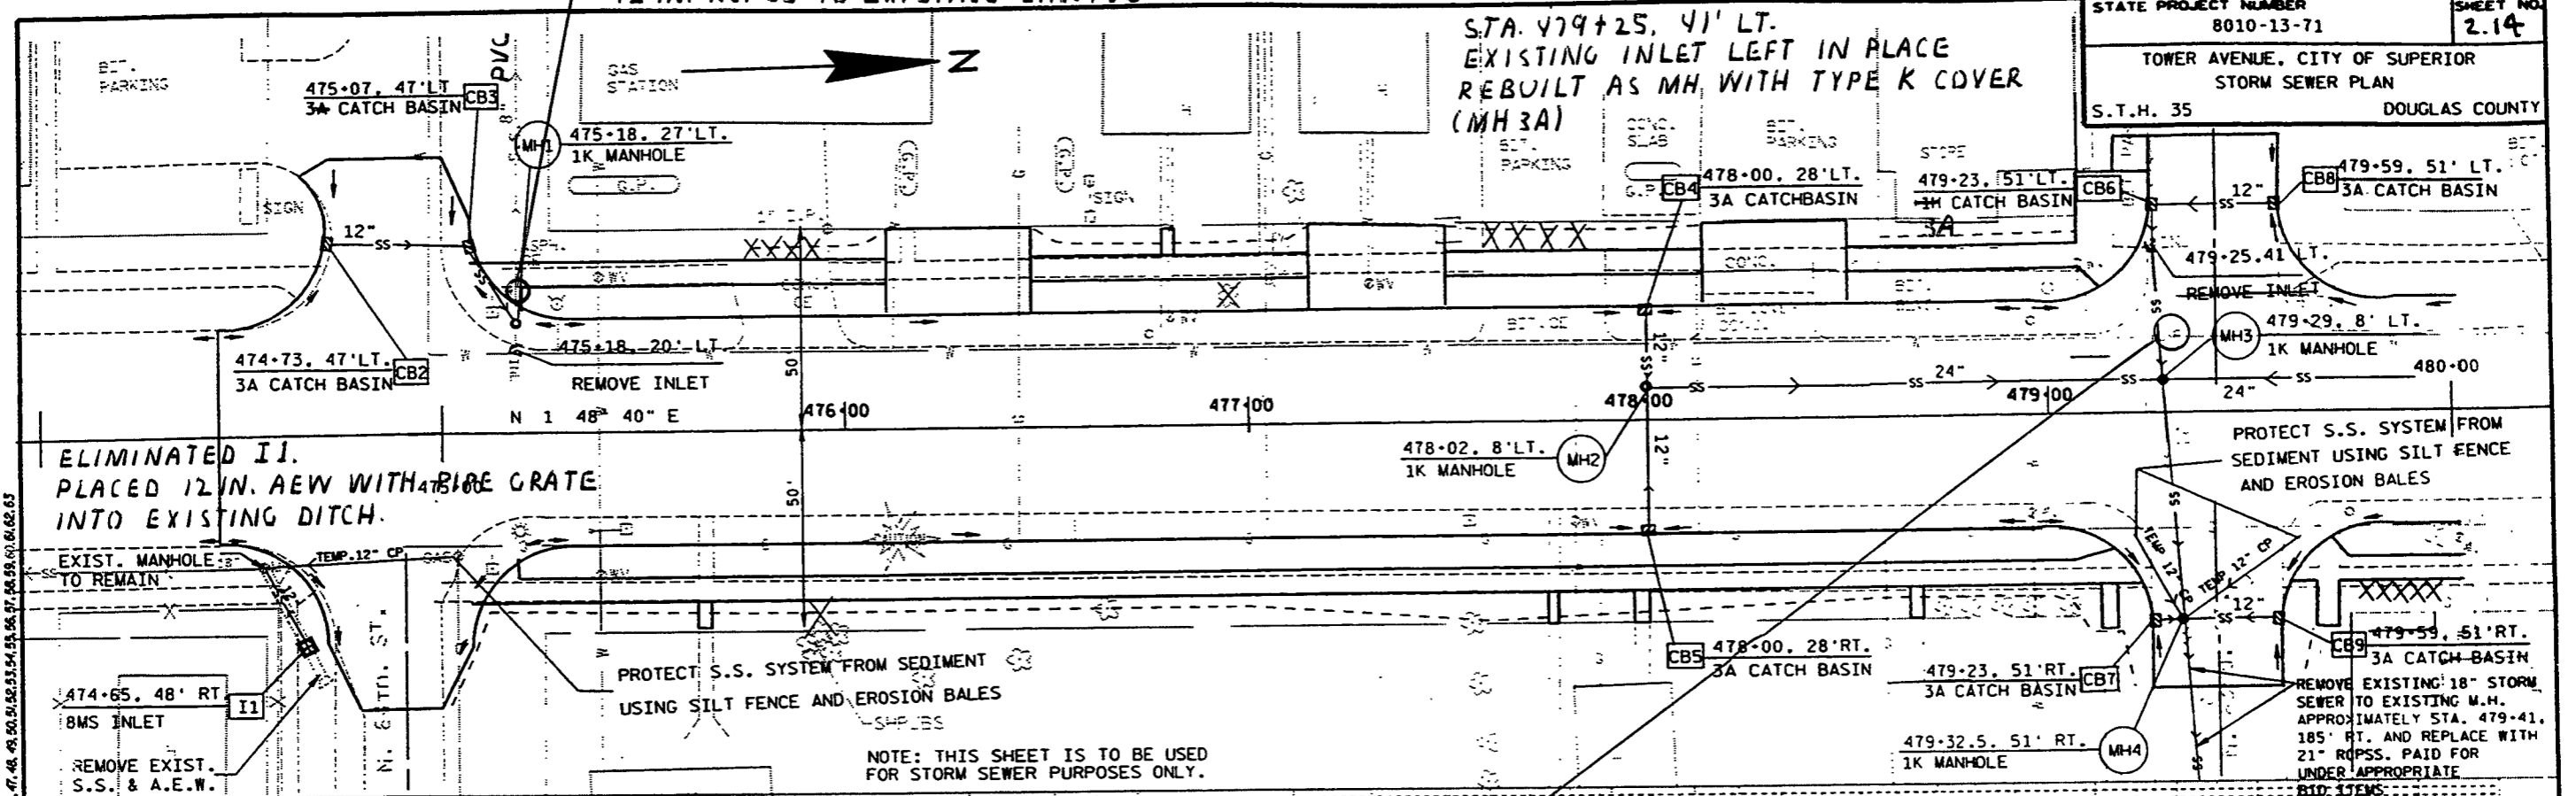

LEVELS ON 1, 2, 3, 62, 63

