




HAMMOND AVENUE

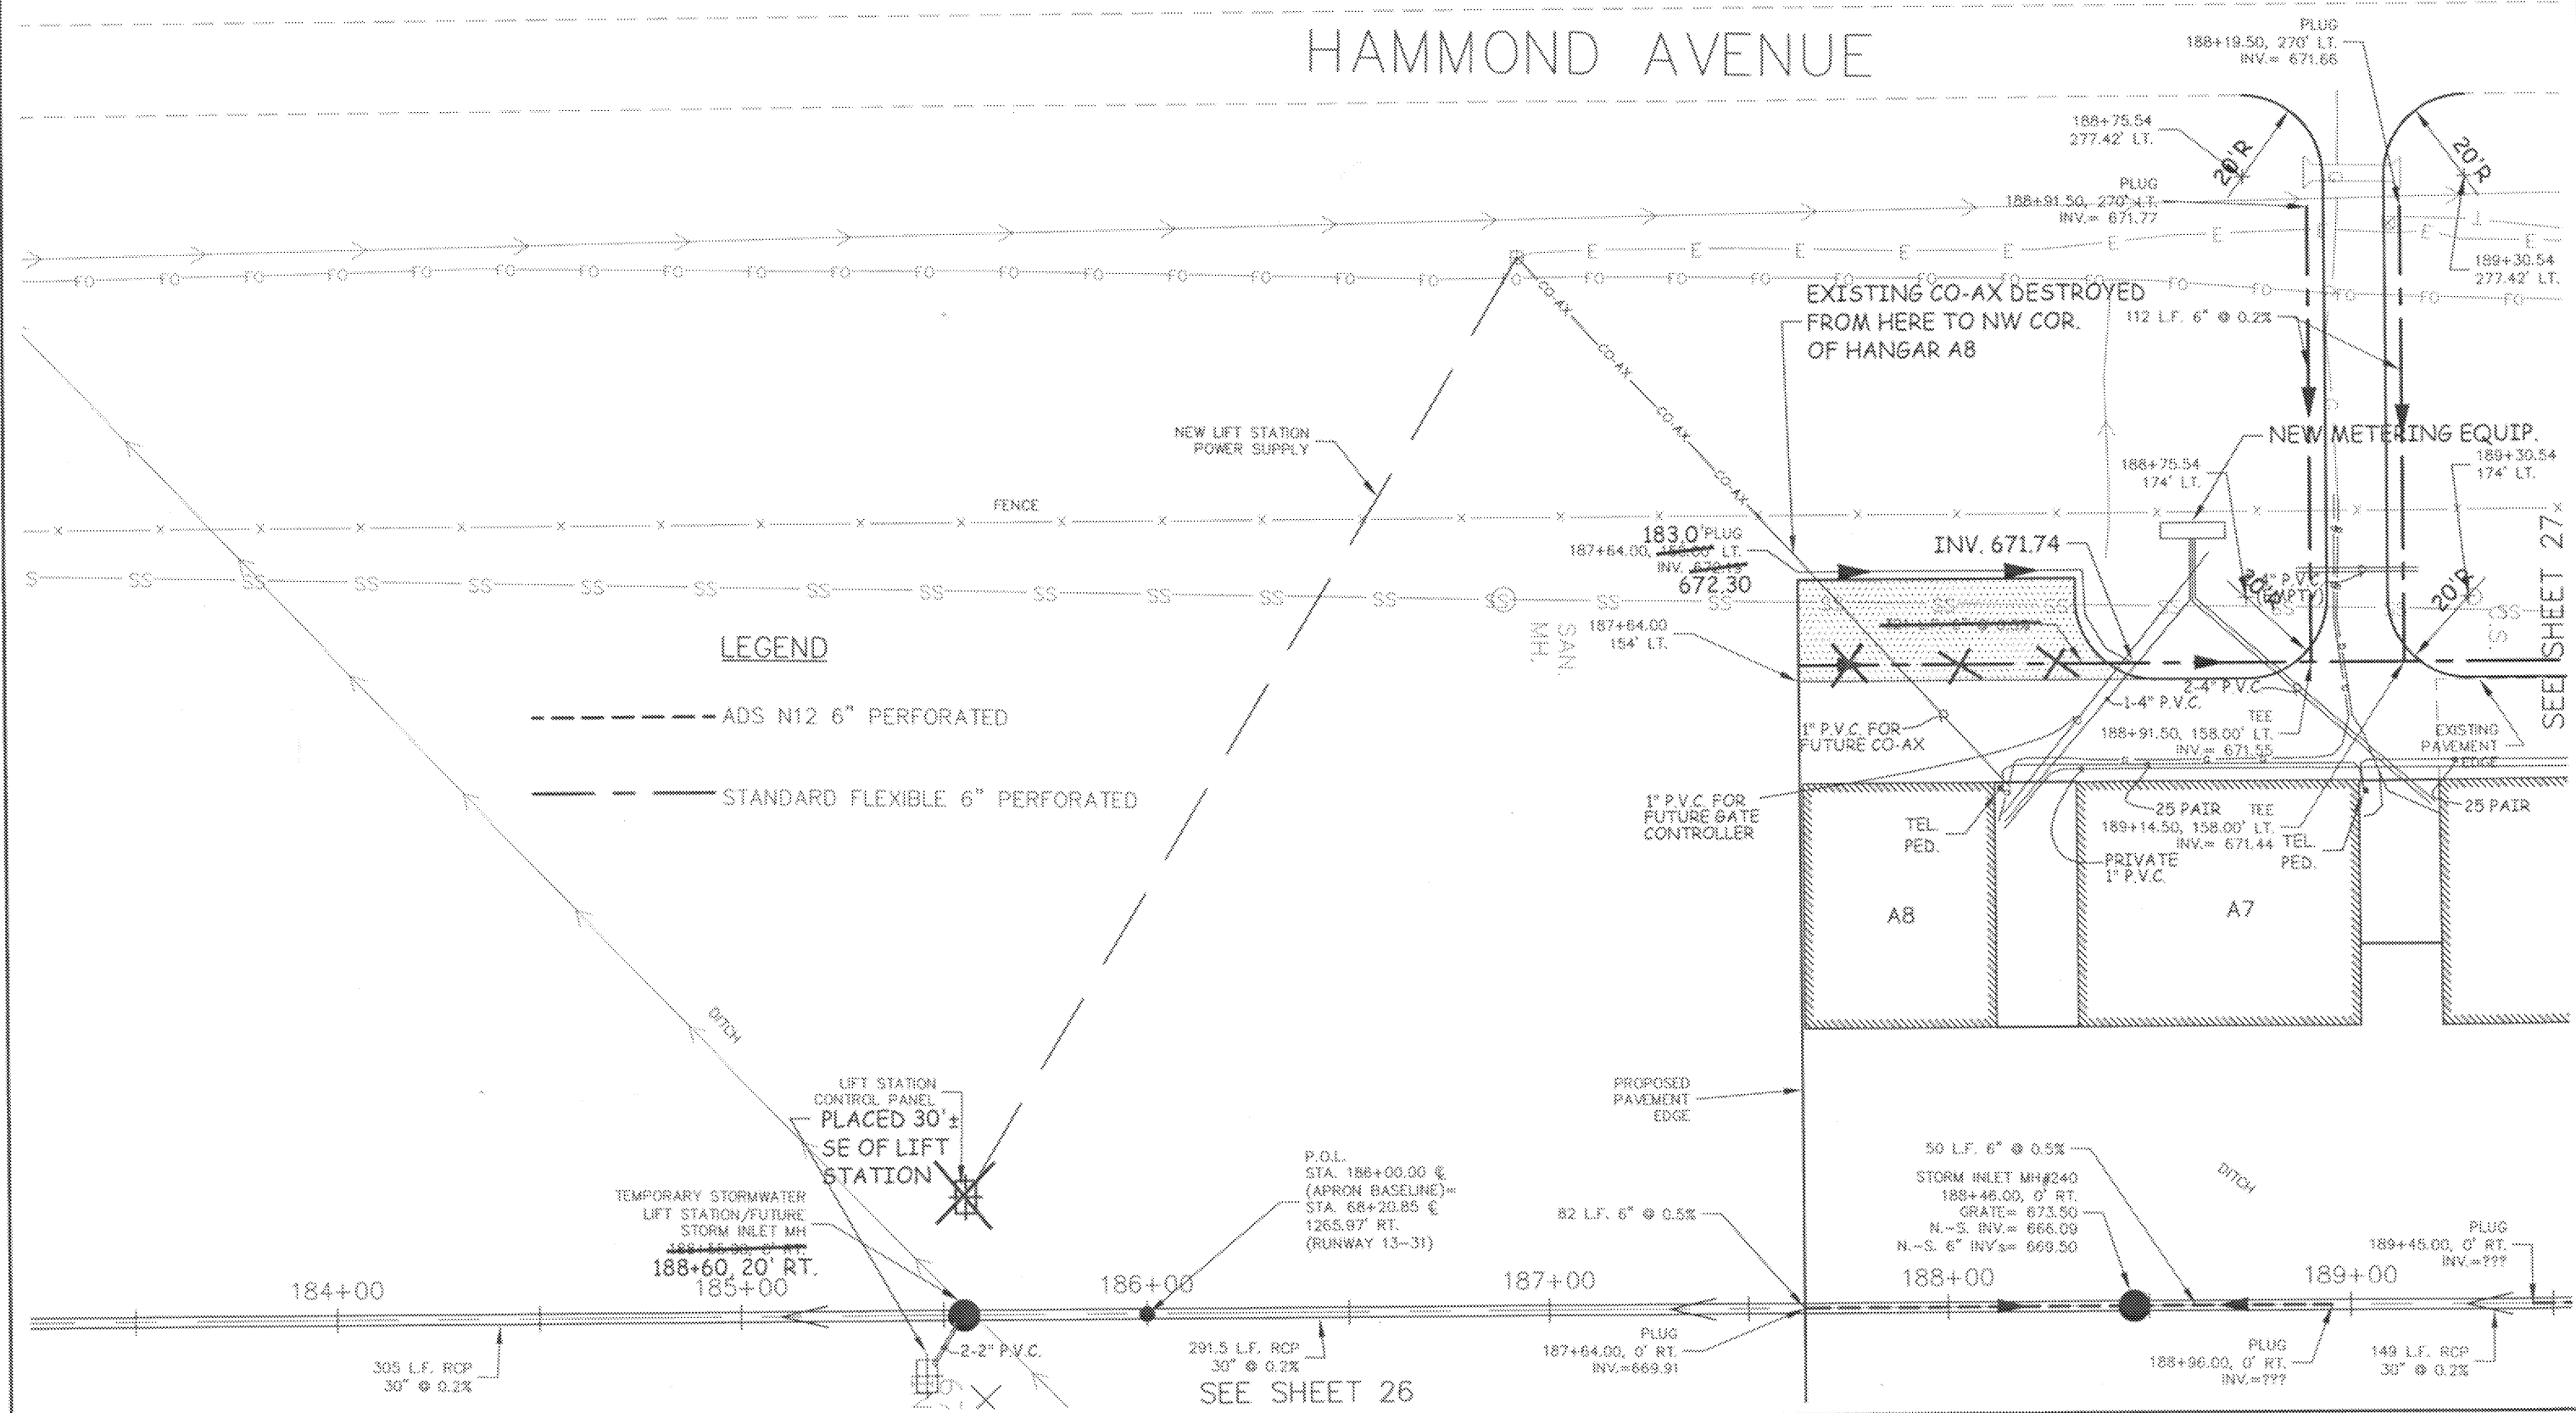

- LEGEND**
- ADS N12 6" PERFORATED
 - STANDARD FLEXIBLE 6" PERFORATED

SEE SHEET 26

SEE SHEET 27

PROJECT MANAGER: BRAD VOLKER CHECKED BY: W.R. APPROVED BY: B.R.M.		310 WEST SOUTH STREET, P.O. BOX 230 RICE LAKE, WISCONSIN 54988-0230 TELEPHONE: (715) 234-7008 FAX: (715) 234-1925		RICHARD I. BONG MEMORIAL AIRPORT SUPERIOR, WISCONSIN		SHEET DESCRIPTION: PLAN SHEETS 3-55-0083-07		DATE: 05-03 SCALE: AS NOTED		DRAWN BY: J.T.D. PROJECT NO.: 00552090 SHEET NO.: 25	
---	--	--	--	---	--	---	--	--------------------------------	--	--	--