


SEE SHEET 25

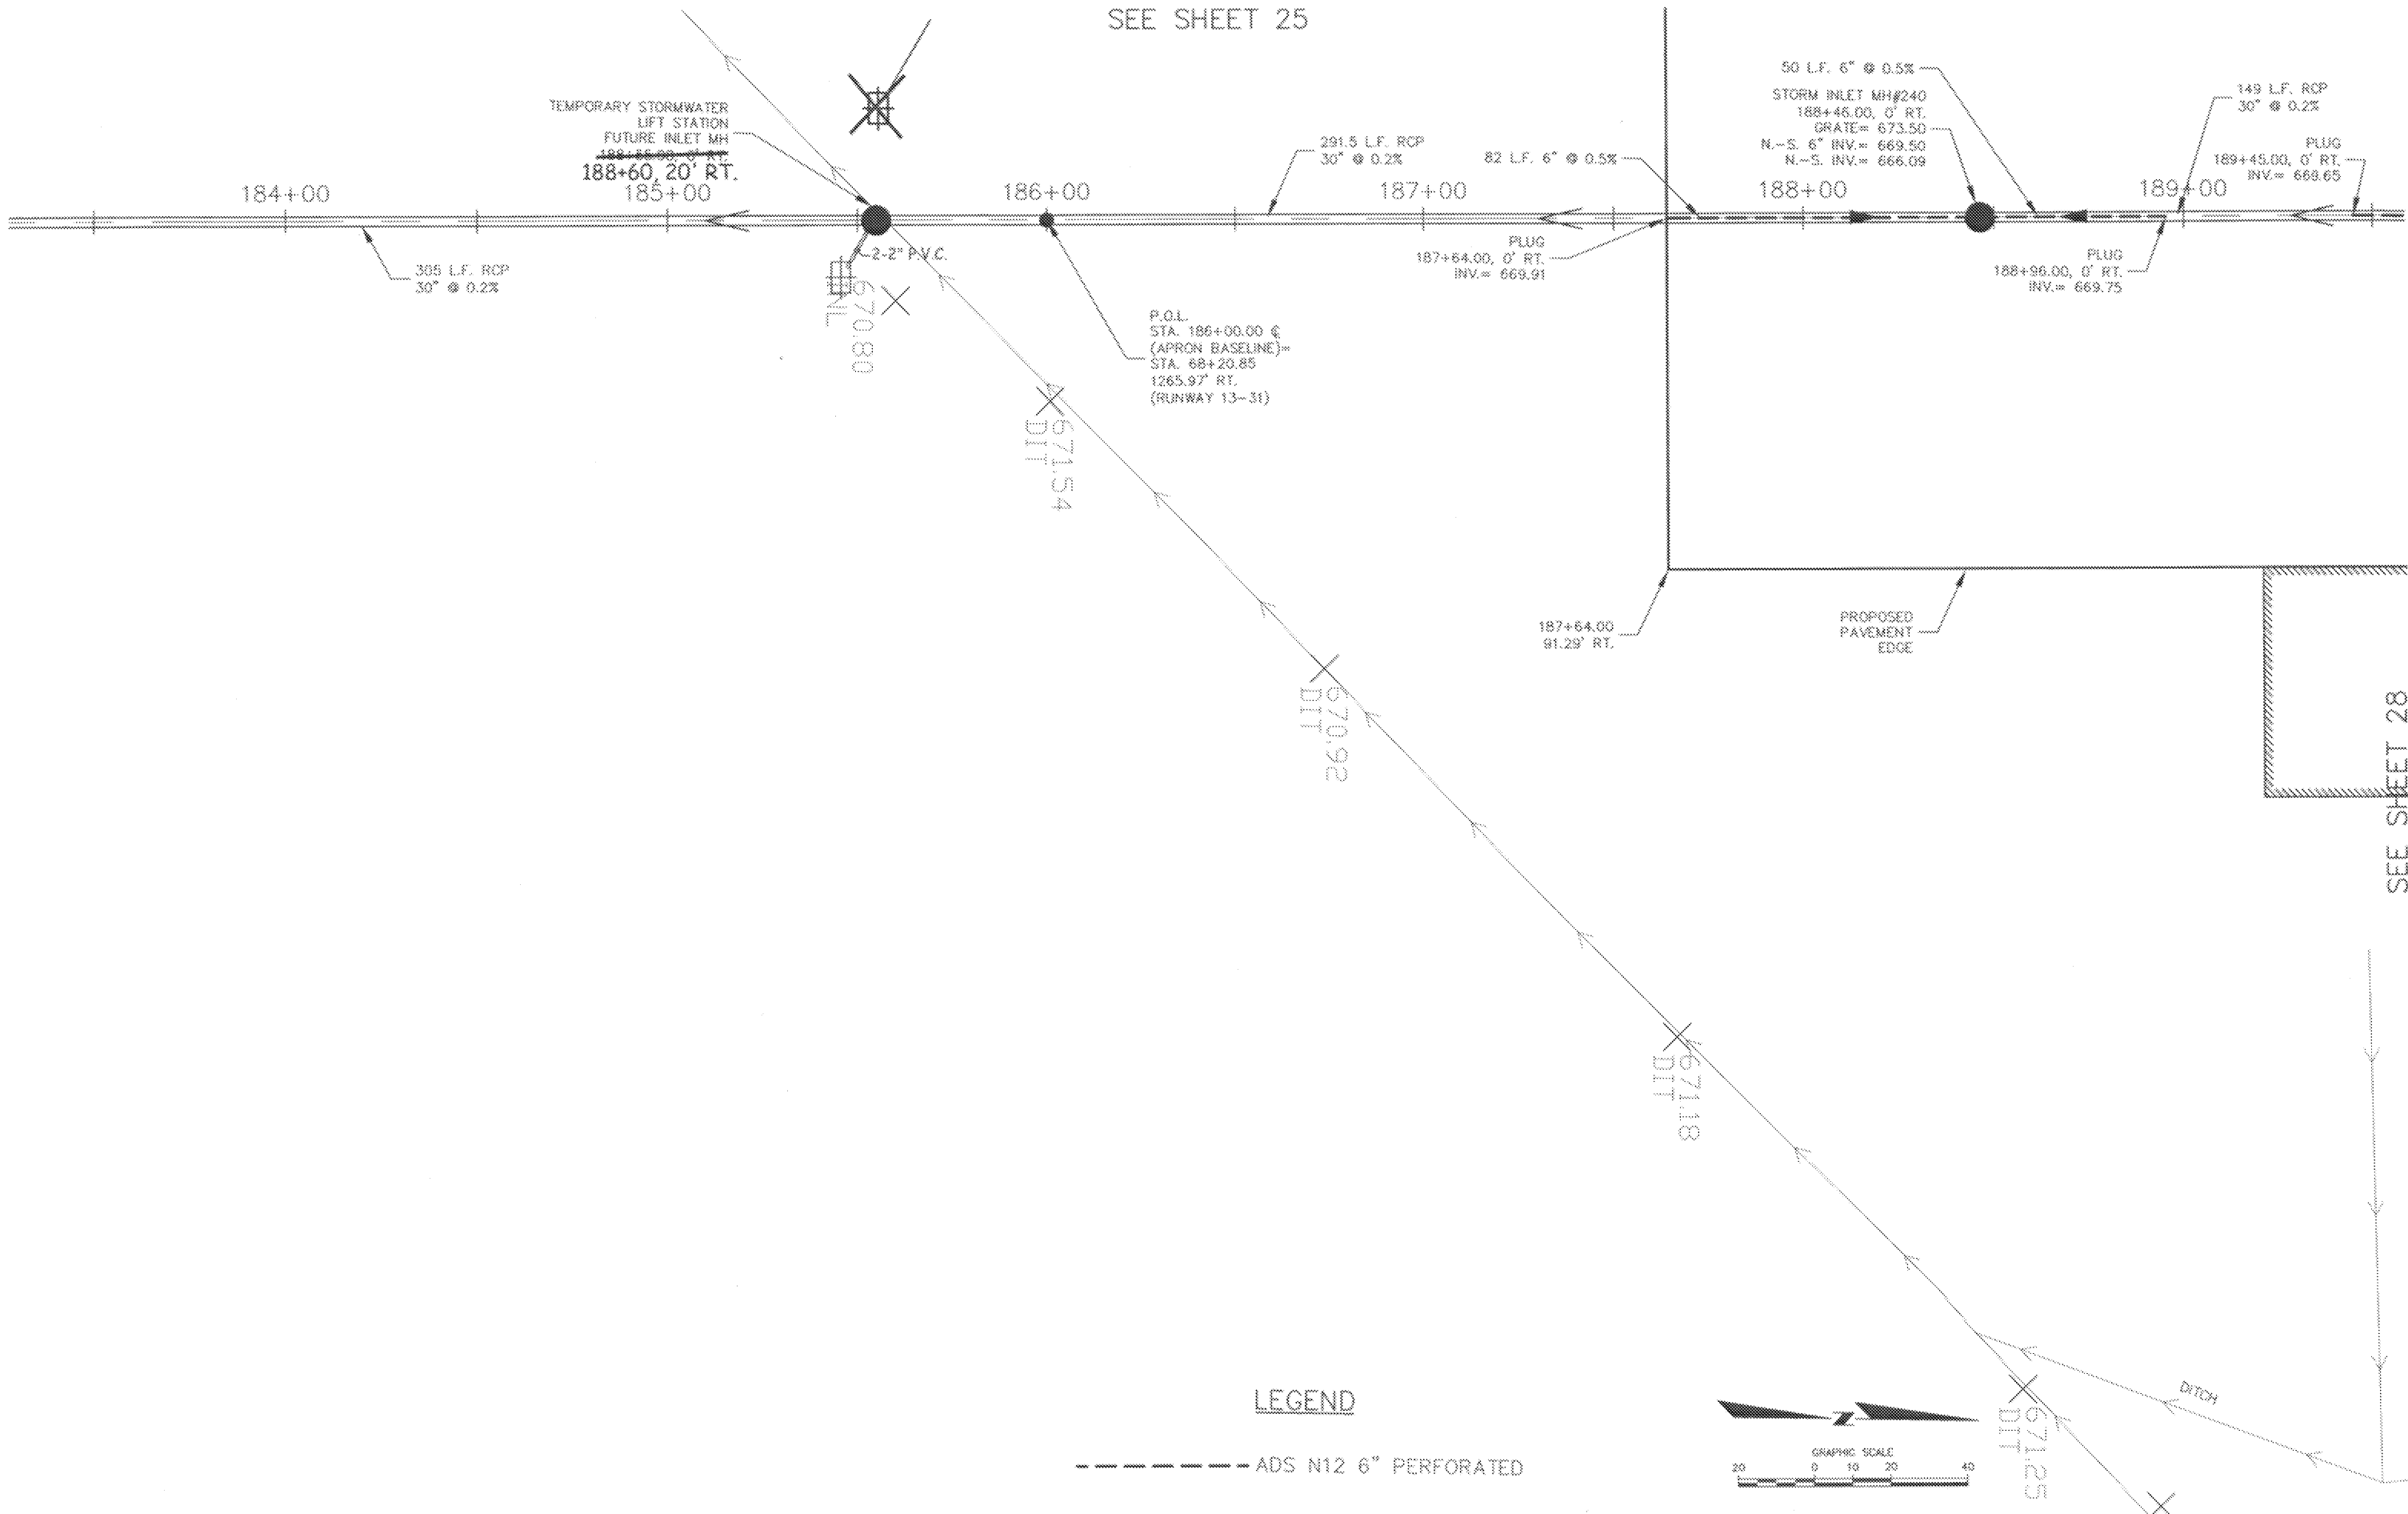

SEE SHEET 28

LEGEND

----- ADS N12 6" PERFORATED



PROJECT MANAGER	BRAD VOLKER
CHECKED BY	W.B.
APPROVED BY	B.R.M.

**COOPER ENGINEERING**  
 310 WEST SOUTH STREET, P.O. BOX 230  
 RICE LAKE, WISCONSIN 54869-0230  
 TELEPHONE (715) 234-7008  
 FAX (715) 234-1025

RICHARD I. BONG MEMORIAL AIRPORT  
 SUPERIOR, WISCONSIN

SHEET DESCRIPTION  
 PLAN SHEETS  
 3-55-0083-07

DATE 5-03  
 SCALE AS NOTED

DRAWN BY J.T.D.  
 PROJECT NO. 00552080  
 SHEET NO. 26