


G:\2000PRO\10055209\Drawings\Apron\Record Drawings\Apron-Plan-Sheets-Plot.DWG, 6/27/2005 2:51:12 PM, M.R.E.

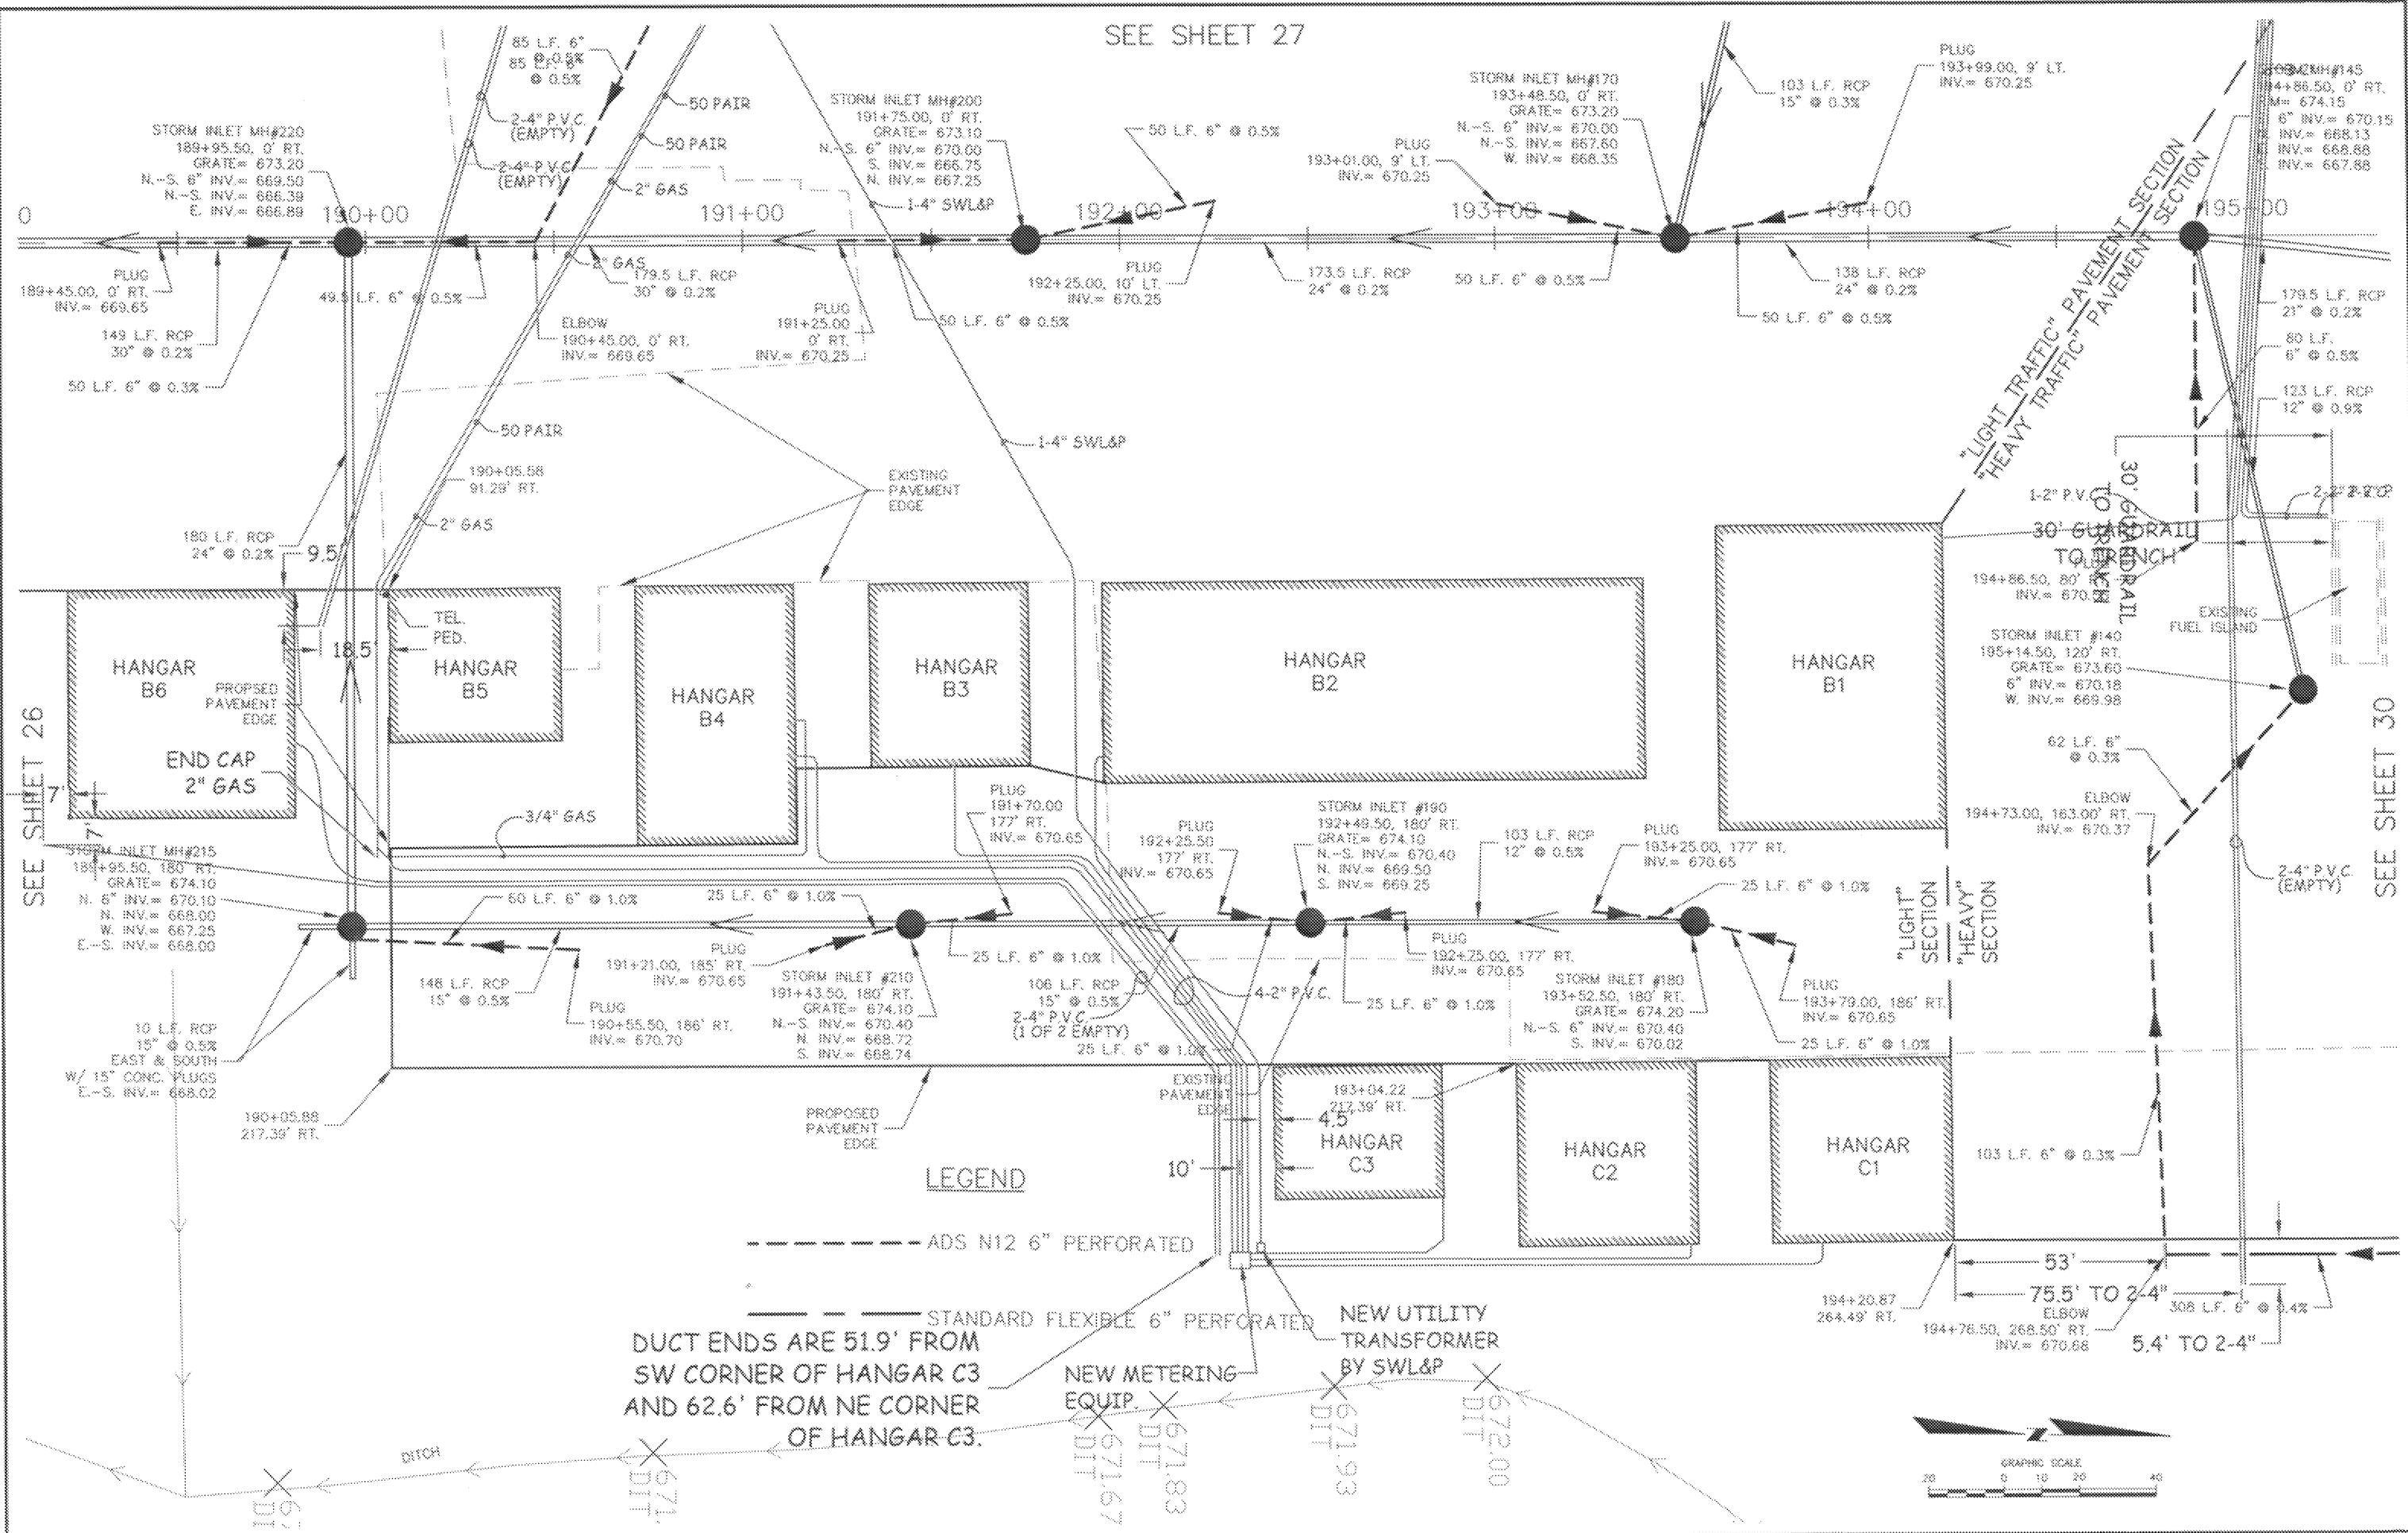

NO.	BY	DATE	REVISIONS

PROJECT MANAGER: BRAD VOLKER  
 CHECKED BY: W.R.  
 APPROVED BY: B.R.M.

**COOPER ENGINEERING**  
 310 WEST SIXTH STREET, P.O. BOX 230  
 RICE LAKE, WISCONSIN 54888-0230  
 TELEPHONE: (715) 234-7000  
 FAX: (715) 234-1005

**RICHARD I. BONG MEMORIAL AIRPORT**  
 SUPERIOR, WISCONSIN

SHEET DESCRIPTION: PLAN SHEETS  
 3-55-0083-07

DATE: 5/02	DRAWN BY: J.T.O.
SCALE: AS NOTED	PROJECT NO: 00552090
	SHEET NO: 28