



LEGEND

EXISTING SANITARY SEWER	
SANITARY SEWER TO INSTALL	
EXISTING WATER LINE	
WATER LINE TO INSTALL	
EXISTING MANHOLE	
MANHOLE TO INSTALL	
GATE VALVE TO INSTALL	
HYDRANT TO INSTALL	
EXISTING OIL LINE	
OIL LINE TO INSTALL	

I hereby certify that this plan, specification, or report was prepared by me or under my direct supervision and that I am a duly Registered Professional Engineer under the laws of the State of Wisconsin.

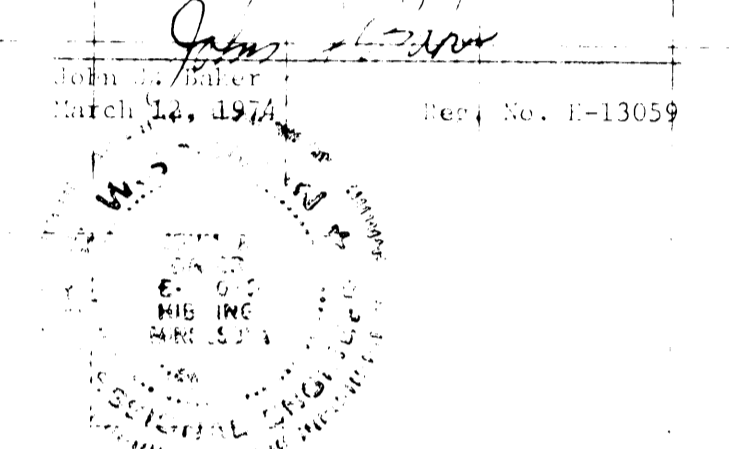

8+23.5  
6+01  
2+22.5

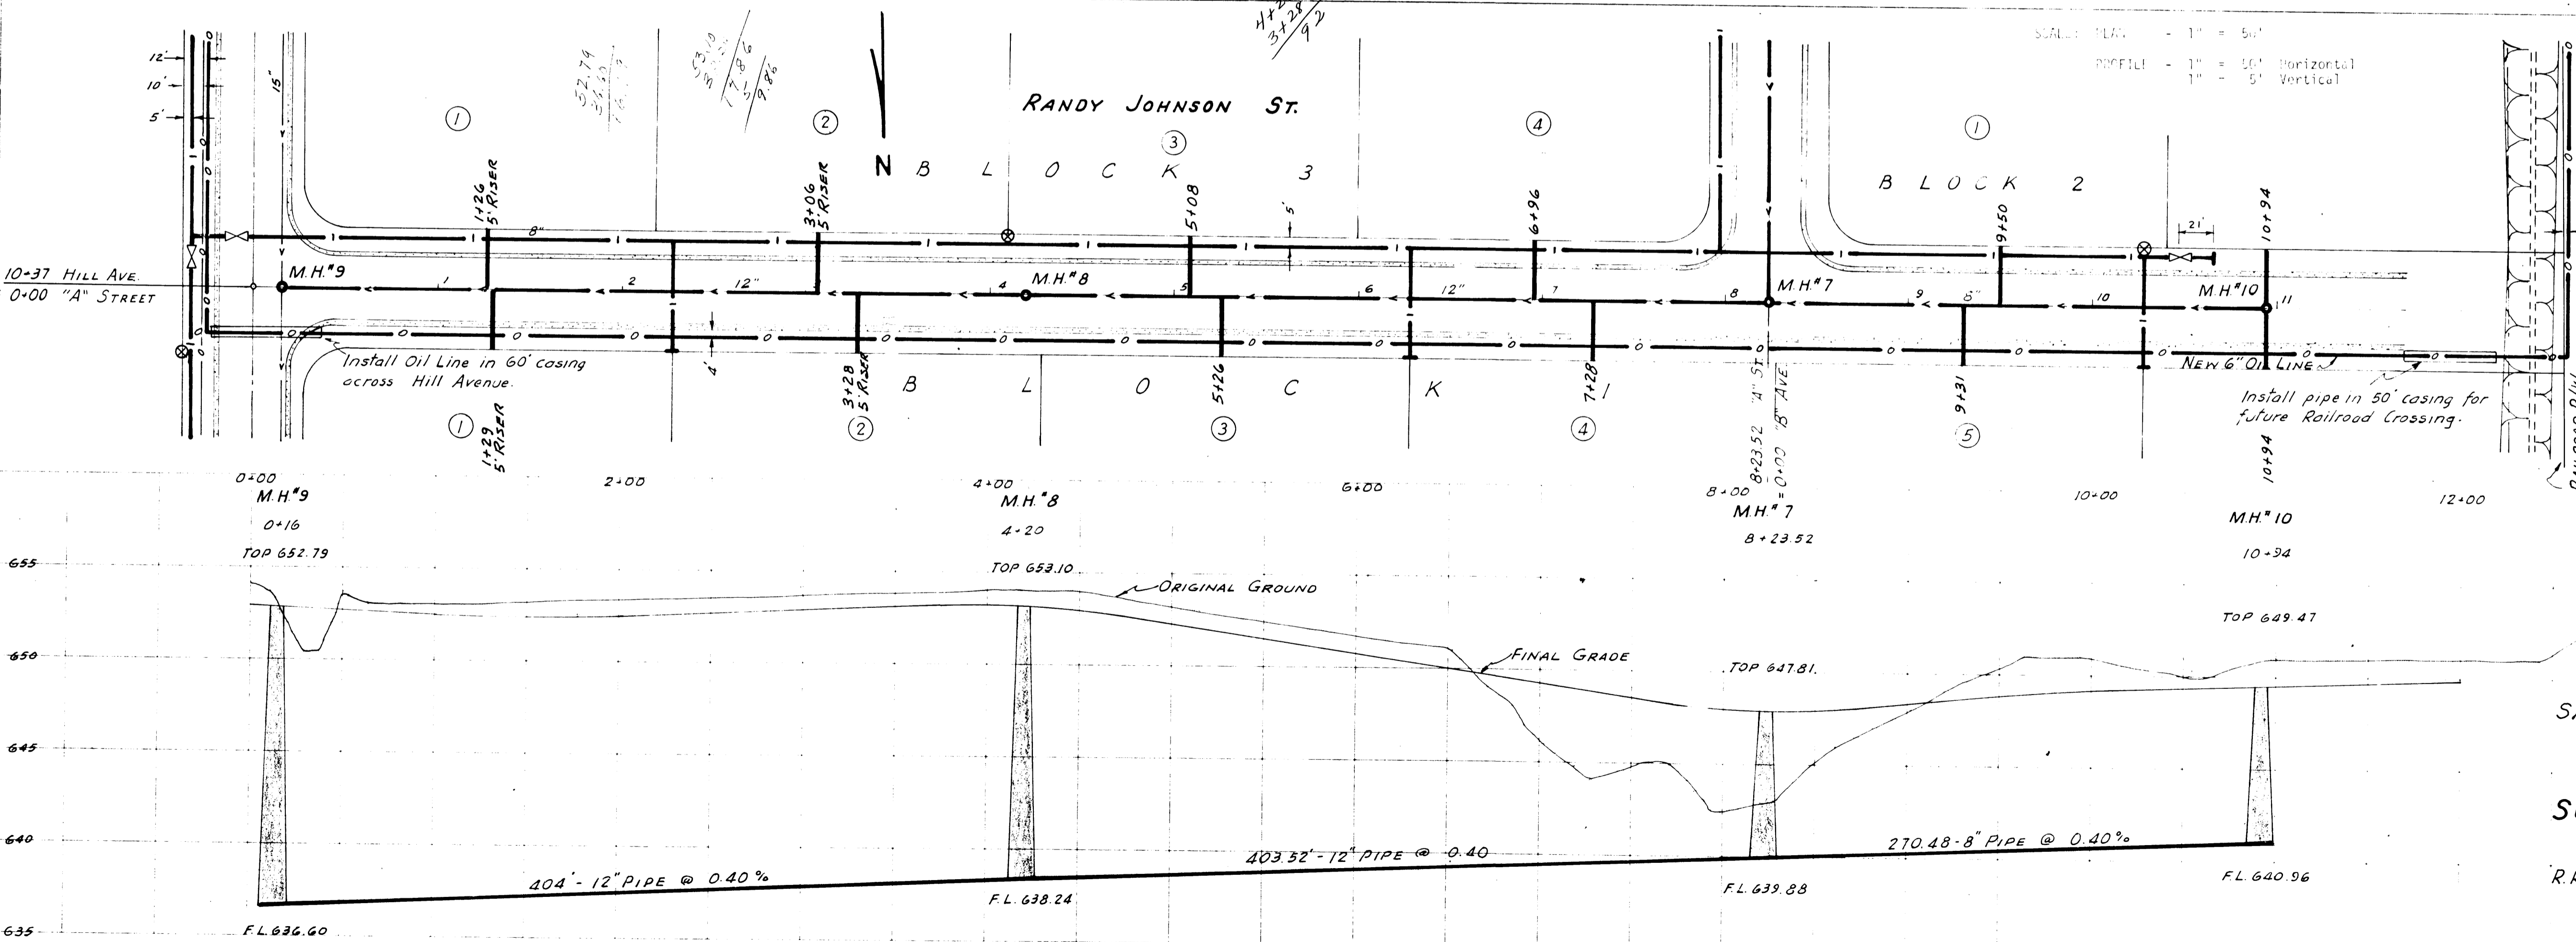

Extend New Oil Line South to tie into existing Line.

AS BUILT NOV. 1975  
SANITARY SEWER, WATER AND OIL LINE  
PLAN - PROFILES  
SUPERIOR INDUSTRIAL PARK

R.R. WALLACE & ASSOC. HIBBING, MINN.

SHEET NO. 14 OF 29

PLAN

NO.	DATE	BY	REVISION

PROFILE

NO.	DATE	BY	REVISION