
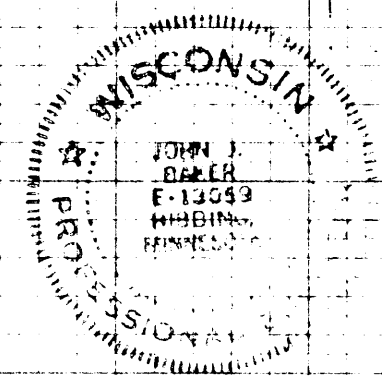


HILL AVE.  
LOOKING SOUTH

HILL AVE.  
LOOKING SOUTH

FINAL SURVEY  
BY \_\_\_\_\_ DATE \_\_\_\_\_  
SURVEYED \_\_\_\_\_  
PLOTTED \_\_\_\_\_  
NOTE BOOK \_\_\_\_\_  
NO. \_\_\_\_\_  
AREAS CHECKED \_\_\_\_\_

ORIGINAL SURVEY  
BY \_\_\_\_\_ DATE \_\_\_\_\_  
SURVEYED \_\_\_\_\_  
PLOTTED \_\_\_\_\_  
NOTE BOOK \_\_\_\_\_  
NO. \_\_\_\_\_  
AREAS CHECKED \_\_\_\_\_

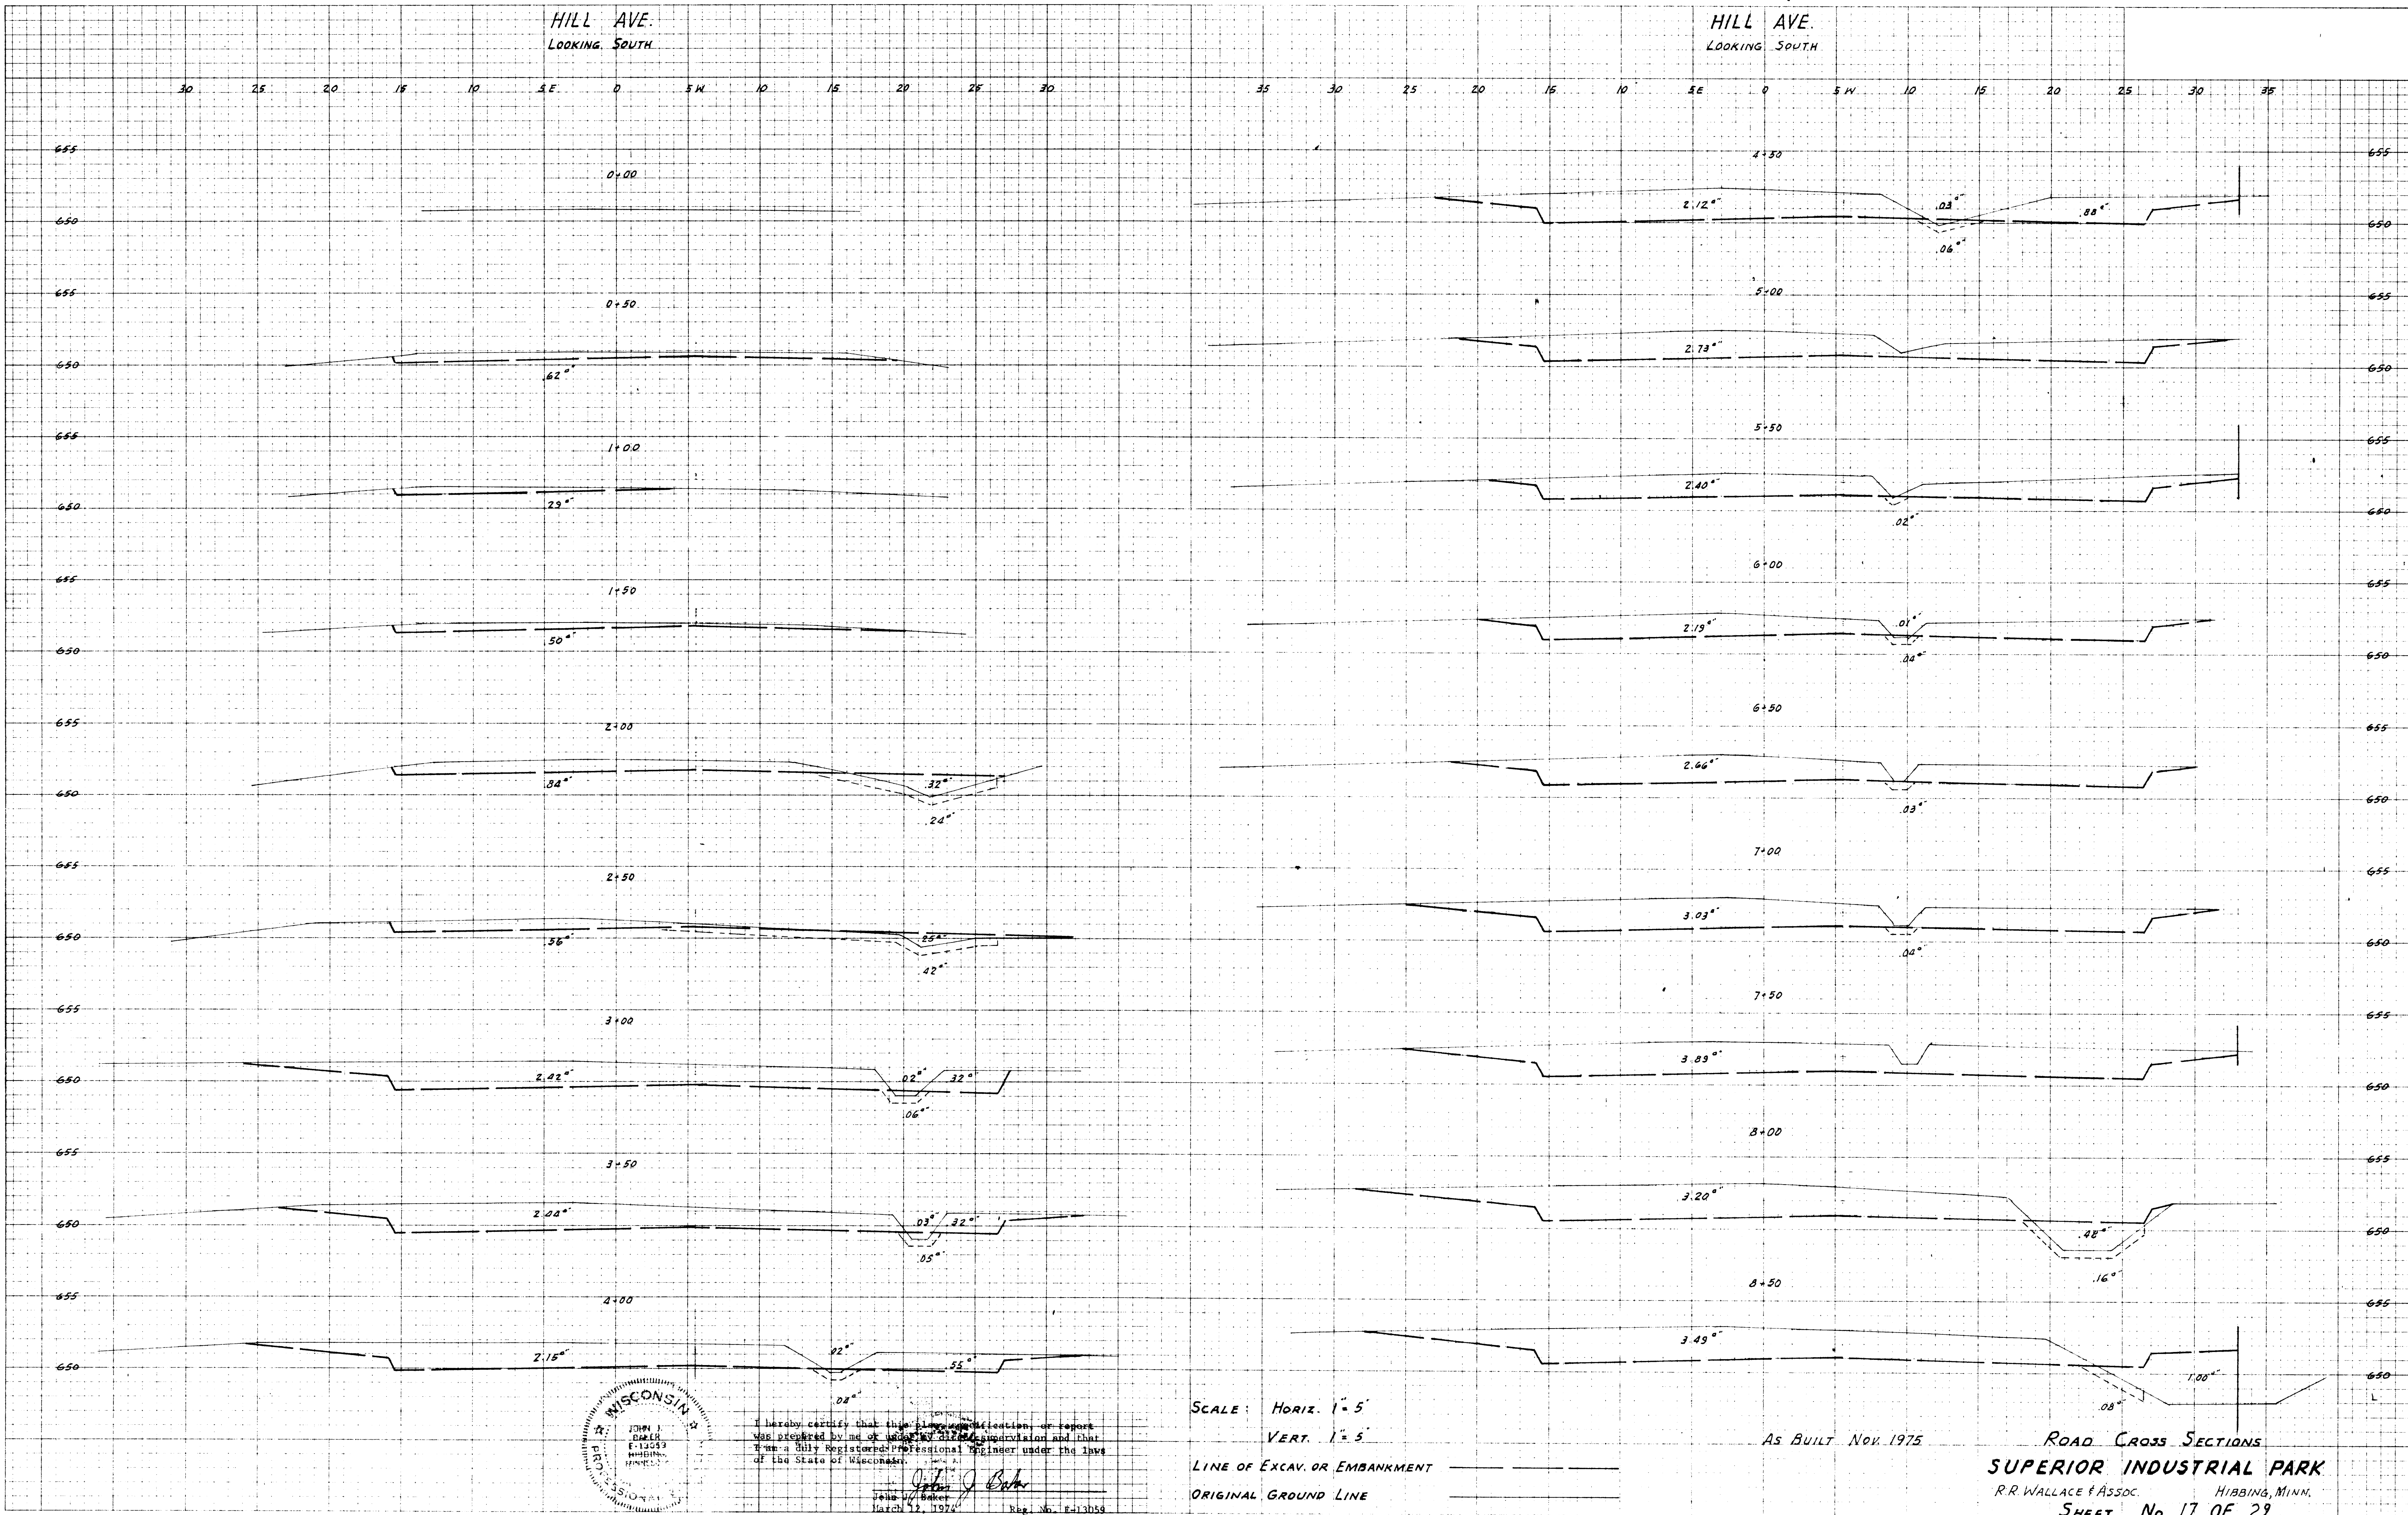

I hereby certify that the plan, specification, or report was prepared by me or under my direct supervision and that I am a duly Registered Professional Engineer under the laws of the State of Wisconsin.

*John J. Baker*  
John J. Baker  
March 22, 1974 Reg. No. F-13589

SCALE: Horiz. 1" = 5'  
VERT. 1" = 5'

LINE OF EXCAV. OR EMBANKMENT \_\_\_\_\_  
ORIGINAL GROUND LINE \_\_\_\_\_

As BUILT Nov. 1975

ROAD CROSS SECTIONS  
SUPERIOR INDUSTRIAL PARK  
R.R. WALLACE & ASSOC. HIBBING, MINN.  
SHEET No. 17 OF 29