

HILL AVE.
LOOKING SOUTH

HILL AVE.
LOOKING SOUTH

30 25 20 15 10 5 E 0 5 W 10 15 20 25 30 30 25 20 15 10 5 E 0 5 W 10 15 20 25 30

9+00

13+50

9+50

14+00

10+00

14+50

10+50

15+00

11+00

15+50

11+50

16+00

12+00

16+50

12+50

17+00

13+00


17+50

2.65"

AS BUILT Nov. 1975

FINAL SURVEY BY DATE
SURVEYED PLOTTED
NOTE BOOK AREAS
NO. CHECKED

ORIGINAL SURVEY BY DATE
SURVEYED PLOTTED
NOTE BOOK AREAS
NO. CHECKED

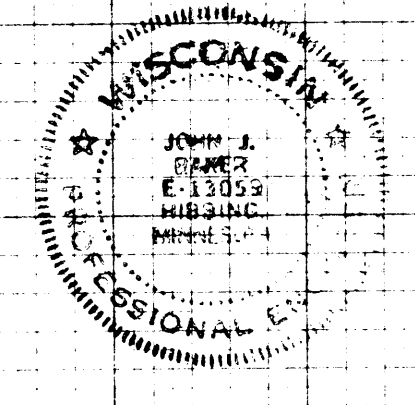

I hereby certify that this plan, specification, or report was prepared by me or under my direct supervision and that I am a duly Registered Professional Engineer under the laws of the State of Wisconsin.

John J. Baker
March 22, 1974 Reg. No. E-13059

SCALE: HORIZ. 1" = 5'
VERT. 1" = 5'

LINE OF EXCAV. OR EMBANKMENT
ORIGINAL GROUND LINE

ROAD CROSS SECTIONS
SUPERIOR INDUSTRIAL PARK

R. R. WALLACE & ASSOC. HIBBING, MINN.

SHEET NO. 18 OF 29

EDA PROJ. NO. 06-01-01127

PLATE 1 CROSS SECTION FOR THE STANDARD NATIONAL TRACING PAPER DIVISION