


HILL AVE.
LOOKING SOUTH

30 25 20 15 10 5E 0 5W 10 15 20 25 30

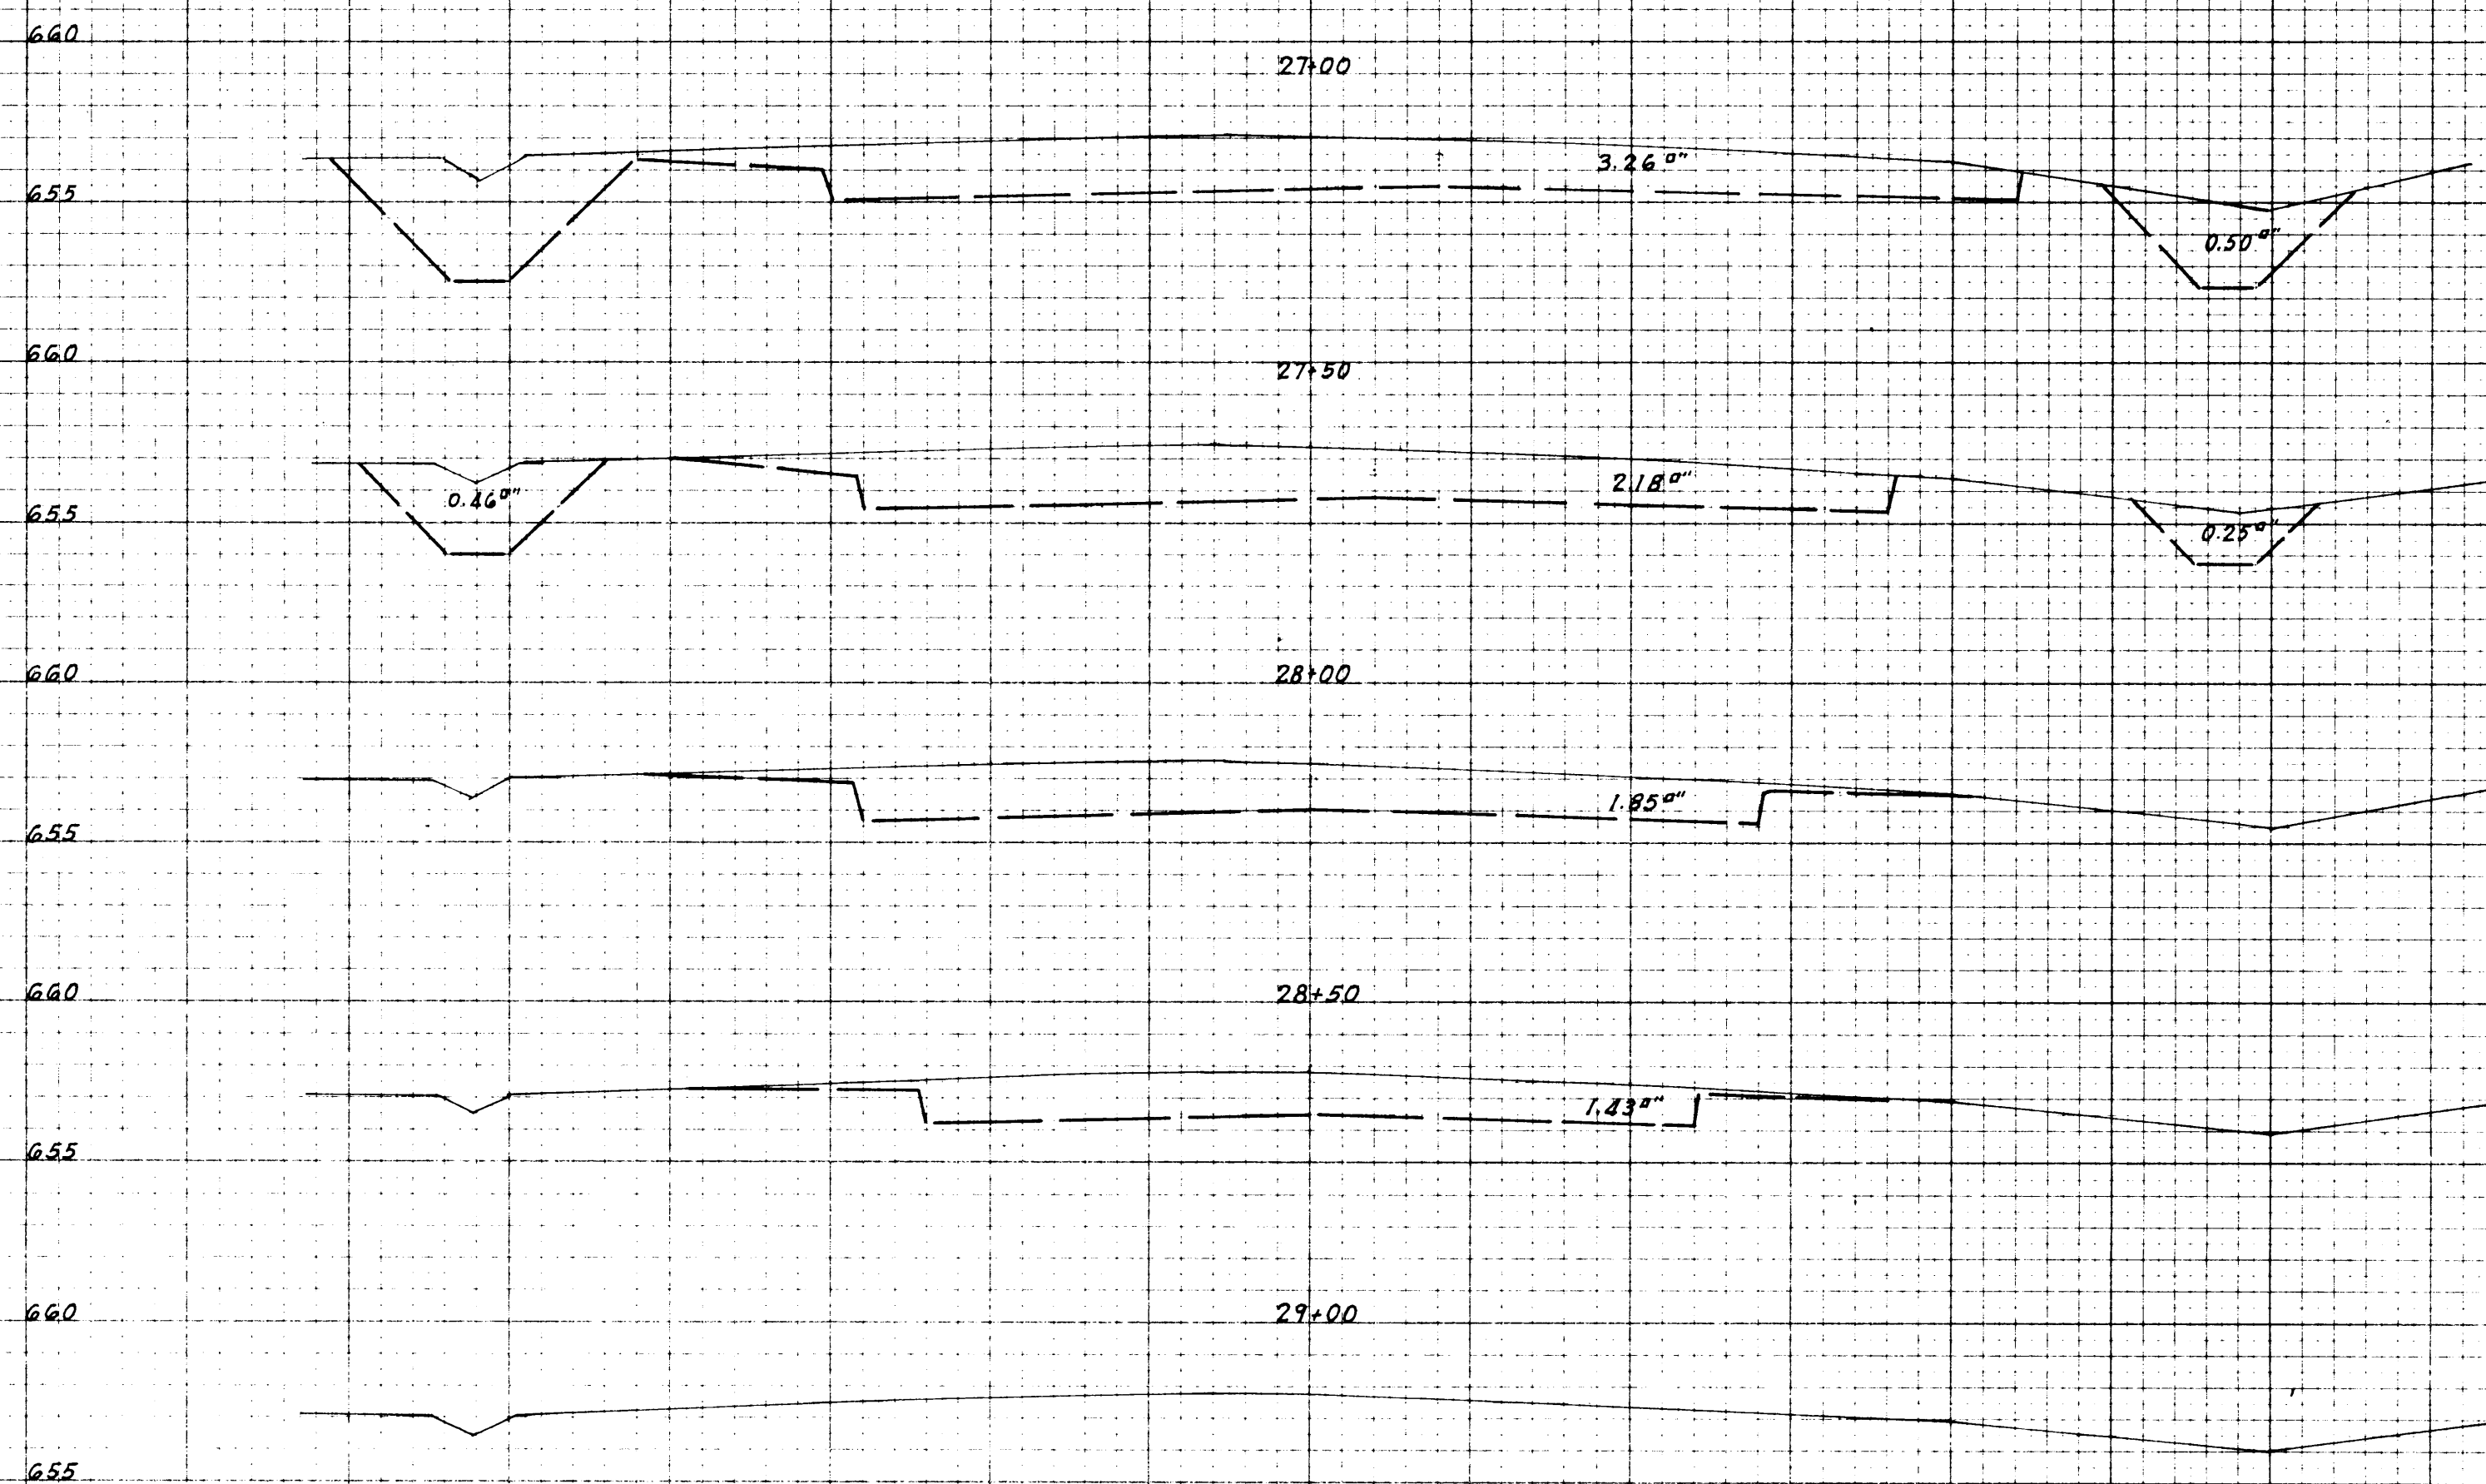


DATE: _____ BY: _____
FINAL SURVEY ENTIRELY PLOTTED FROM ORIGINAL SURVEY DATA
NOTE BOOK, AREA, NO. _____
INSTRUMENTS USED: _____

DATE: _____ BY: _____
ORIGINAL SURVEY ENTIRELY PLOTTED FROM ORIGINAL SURVEY DATA
NOTE BOOK, AREA, NO. _____
INSTRUMENTS USED: _____

SCALE: HORIZ. 1" = 5'
VERT. 1" = 5'

LINE OF EXCAV. OR EMBANKMENT ————
ORIGINAL GROUND LINE ————
As BUILT Nov. 1975

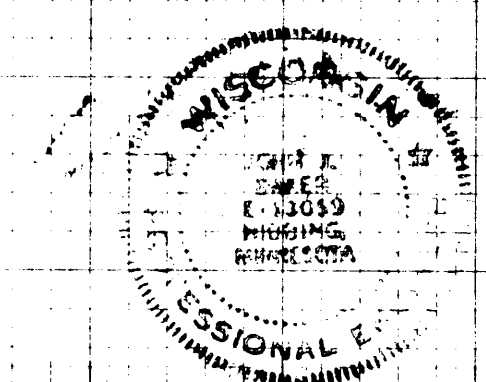

I hereby certify that this plan, specification, or report was prepared by me or under my direct supervision and that I am a duly Registered Professional Engineer under the laws of the State of Wisconsin.
John A. Baker
John A. Baker
March 12, 1970 Reg. No. 113059

ROAD CROSS SECTIONS
SUPERIOR INDUSTRIAL PARK
R.R. WALLACE & ASSOC. HIBBING, MINN.

SHEET No. 20 OF 29