


RANDY JOHNSON ST.  
LOOKING EAST

RANDY JOHNSON ST.  
LOOKING EAST

FINAL SURVEY  
BY: \_\_\_\_\_  
DATE: \_\_\_\_\_  
SURVEYED: \_\_\_\_\_  
PLOTTED: \_\_\_\_\_  
NOTE BOOK: \_\_\_\_\_  
AREA NO.: \_\_\_\_\_  
AREAS CHECKED: \_\_\_\_\_


ORIGINAL SURVEY  
BY: \_\_\_\_\_  
DATE: \_\_\_\_\_  
SURVEYED: \_\_\_\_\_  
PLOTTED: \_\_\_\_\_  
NOTE BOOK: \_\_\_\_\_  
AREA NO.: \_\_\_\_\_  
AREAS CHECKED: \_\_\_\_\_

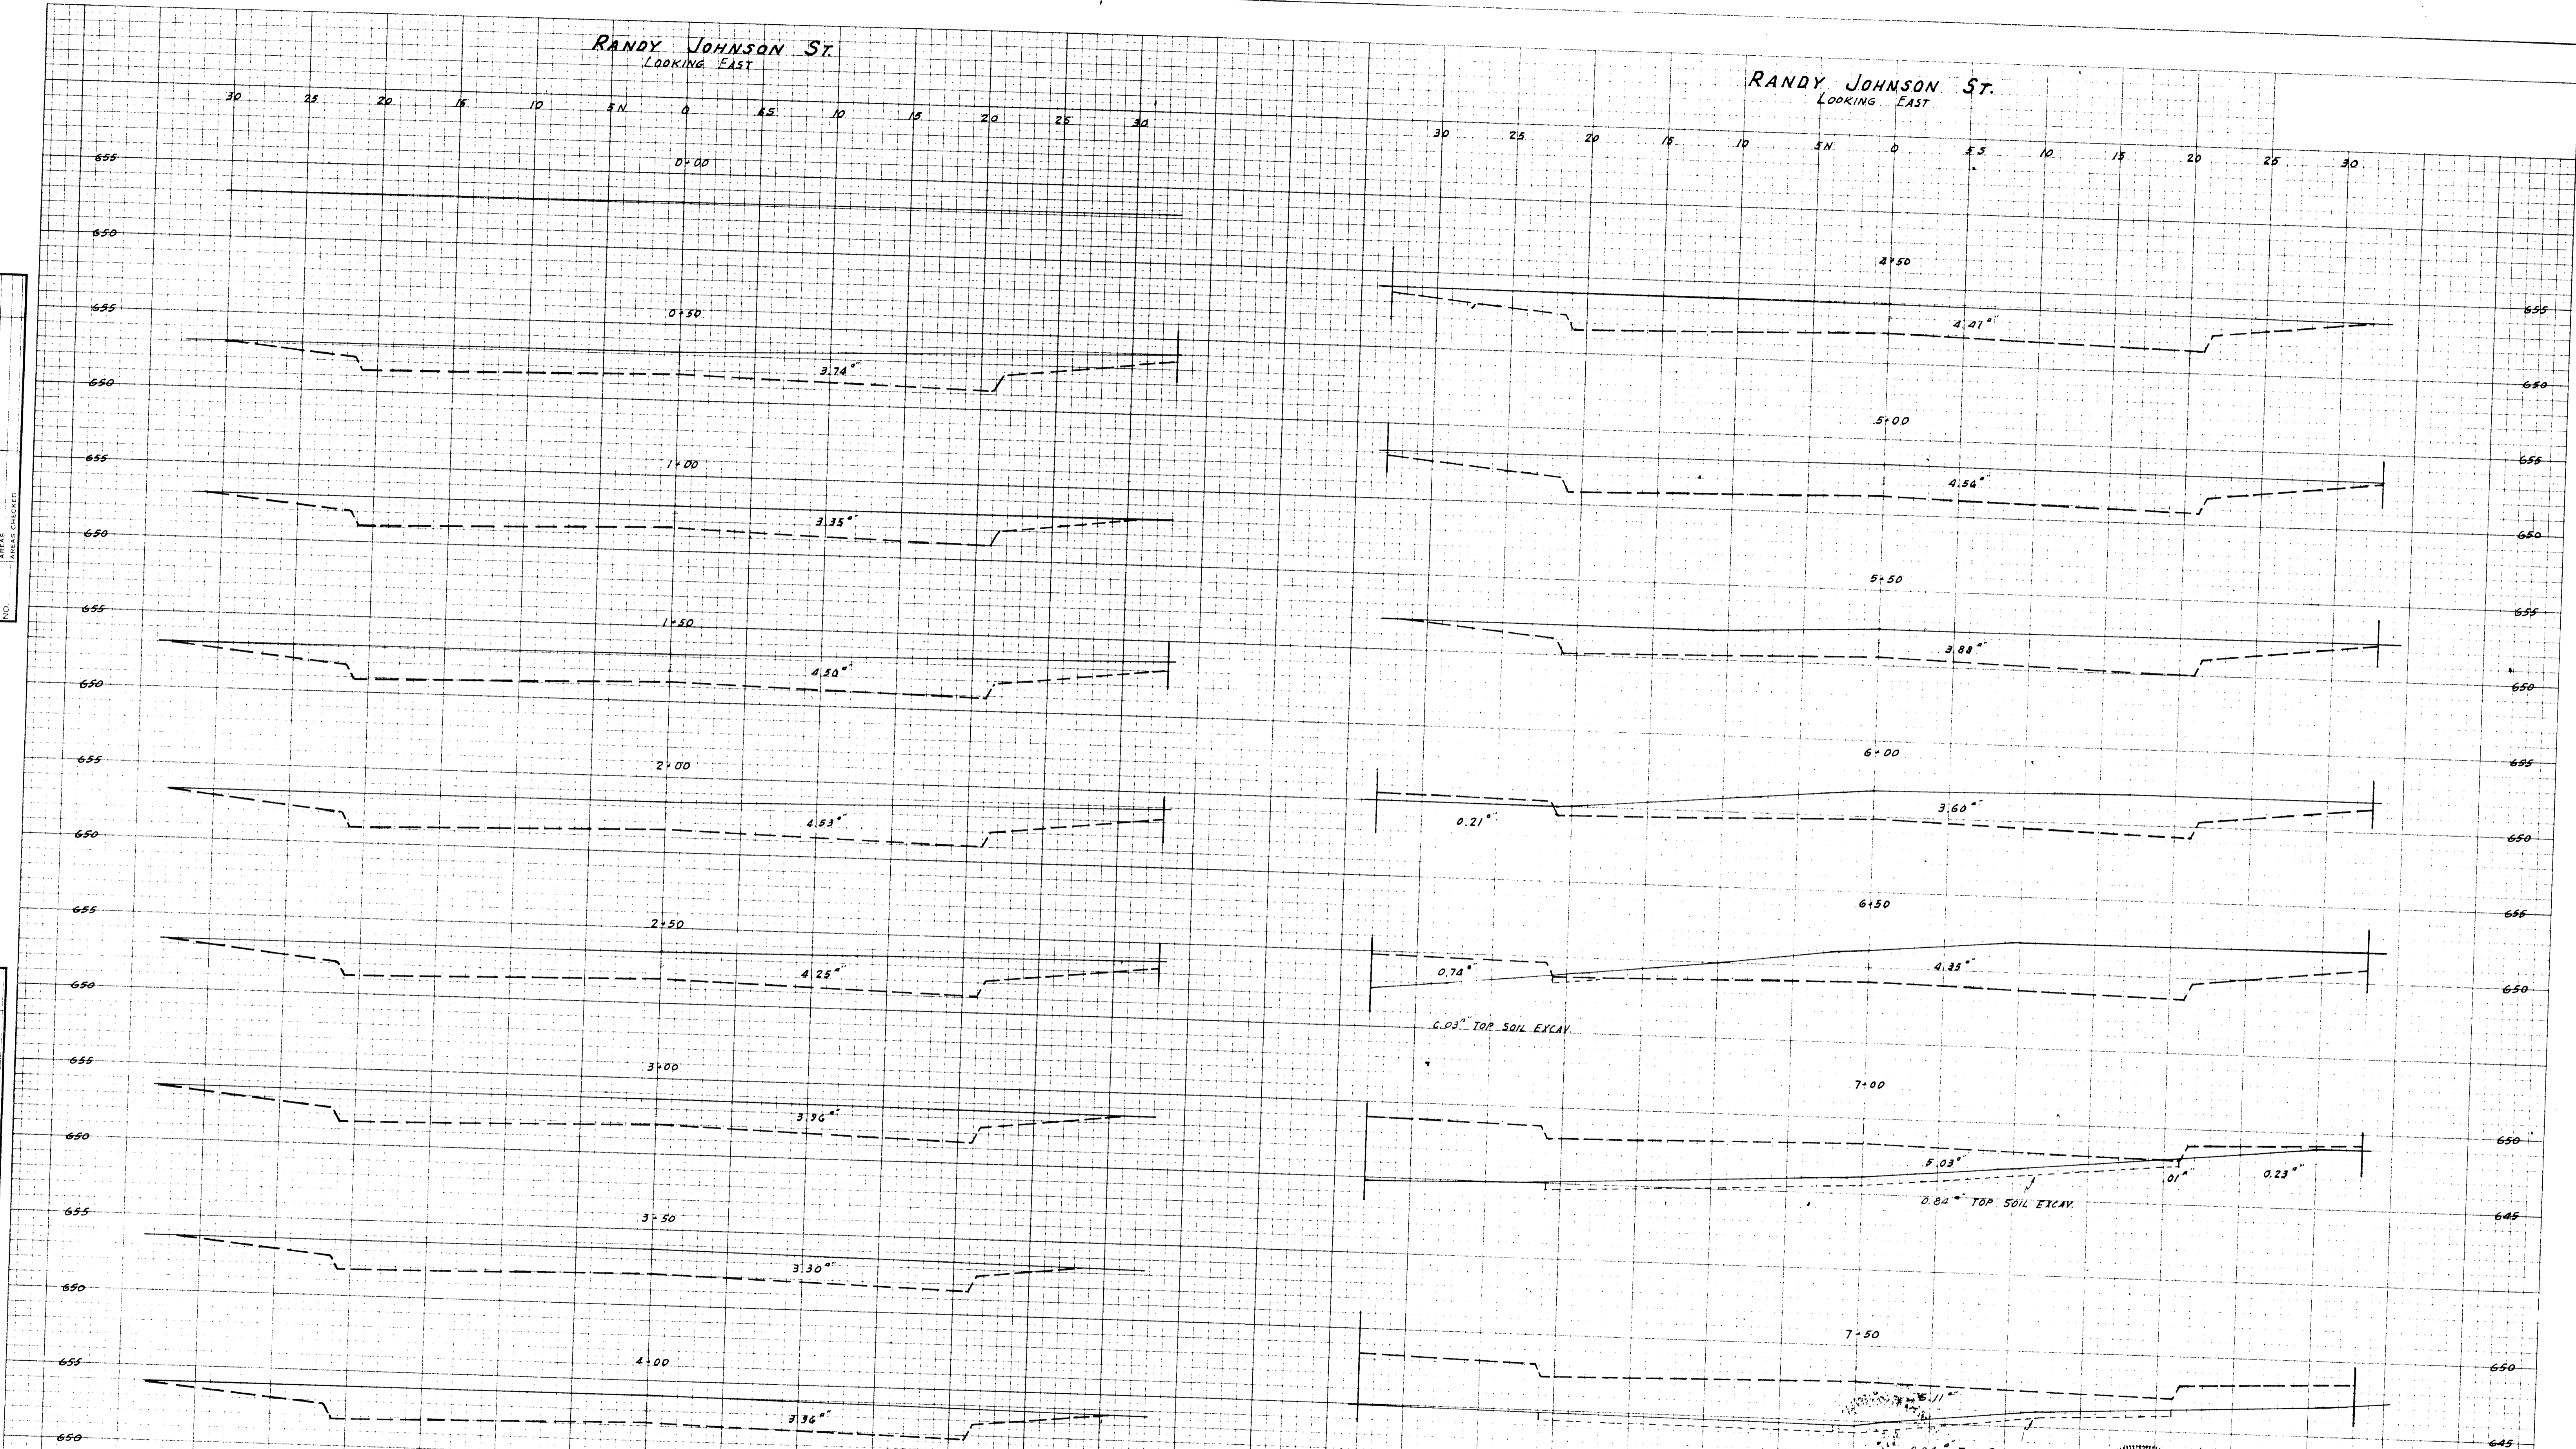

SCALE: HORIZ. 1" = 5'  
VERT. 1" = 5'

LINE OF EXCAV. OR EMBANKMENT  
ORIGINAL GROUND LINE

I hereby certify that this plan, specification, or report was prepared by me or under my direct supervision and that I am a duly Registered Professional Engineer under the laws of the State of Wisconsin.  
John J. Baker  
March 12, 1978  
Reg. No. 1-11059

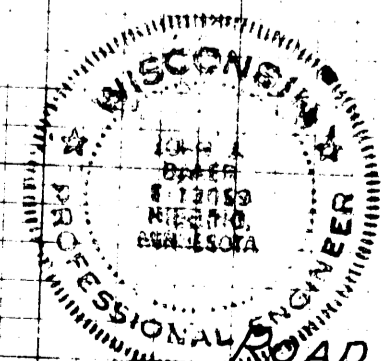

As BUILT Nov. 1975.

ROAD CROSS SECTIONS  
SUPERIOR INDUSTRIAL PARK  
R.R. WALLACE & Assoc. HIBBING, MINN.  
SHEET No. 21 OF 29