
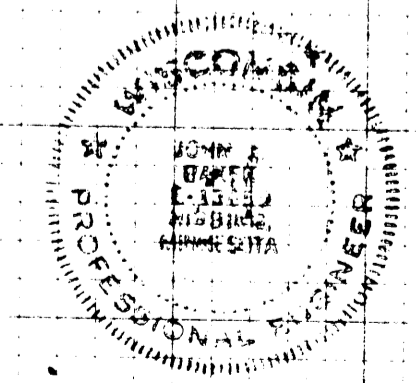


RANDY JOHNSON ST  
LOOKING EAST

30 25 20 15 10 5 N 0 5 S 10 15 20 25 30

FINAL SURVEY BY DATE  
SURVEYED BY DATE  
PLOTTED BY DATE  
NOTE BOOK NO. AREA CHECKED

ORIGINAL SURVEY BY DATE  
SURVEYED BY DATE  
PLOTTED BY DATE  
NOTE BOOK NO. AREA CHECKED

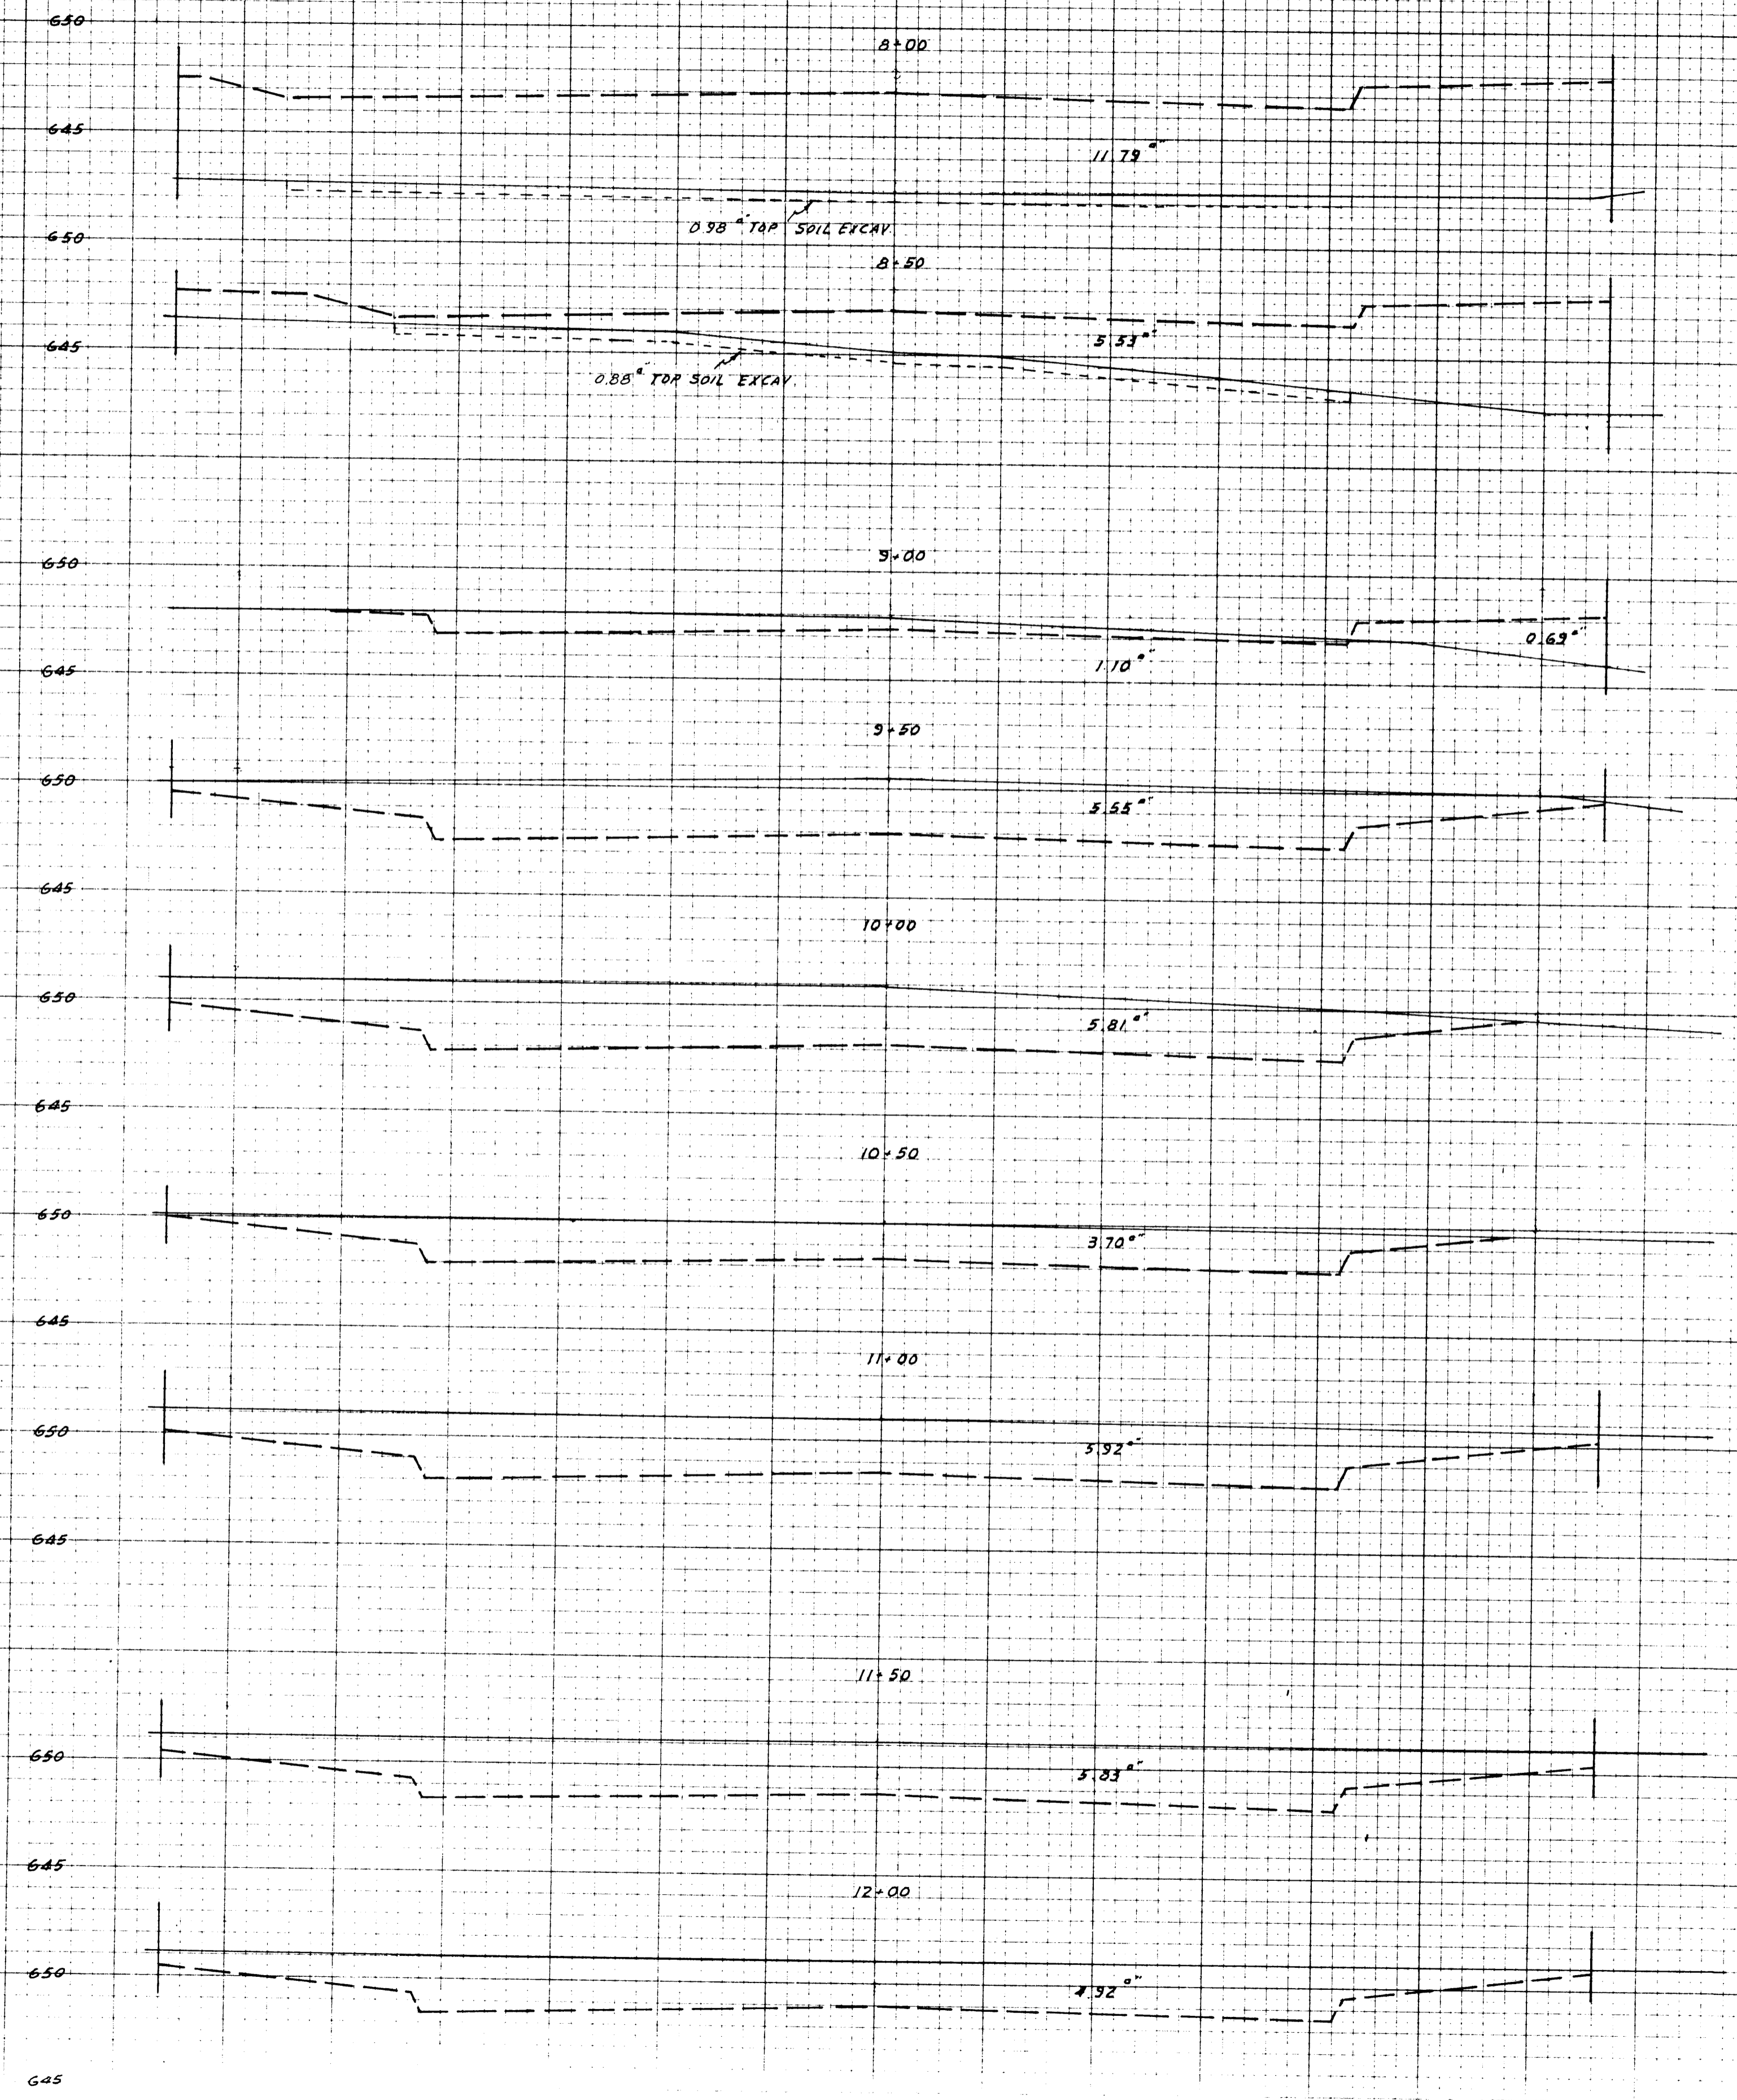

I hereby certify that this plan, specification, or report was prepared by me or under my direct supervision and that I am a duly Registered Professional Engineer under the laws of the State of Wisconsin.  
John J. Baker  
March 22, 1974 Reg. No. 2-13059

As BUILT Nov. 1975

SCALE: HORIZ. 1" = 5'  
VERT. 1" = 5'

LINE OF EXCAV. OR EMBANKMENT  
ORIGINAL GROUND LINE

ROAD CROSS SECTIONS  
SUPERIOR INDUSTRIAL PARK  
R.R. WALLACE & ASSOC. HIBBING, MINN.  
SHEET No. 22 OF 29