

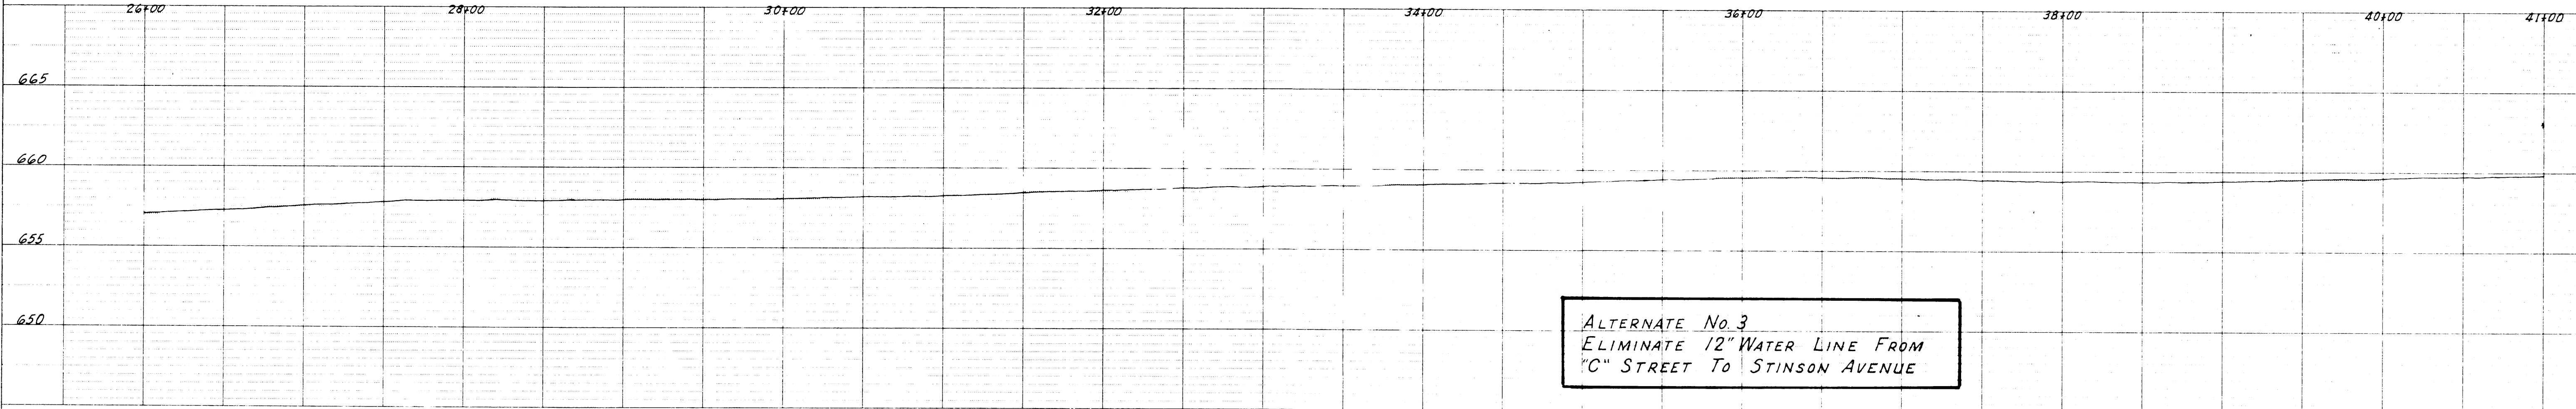
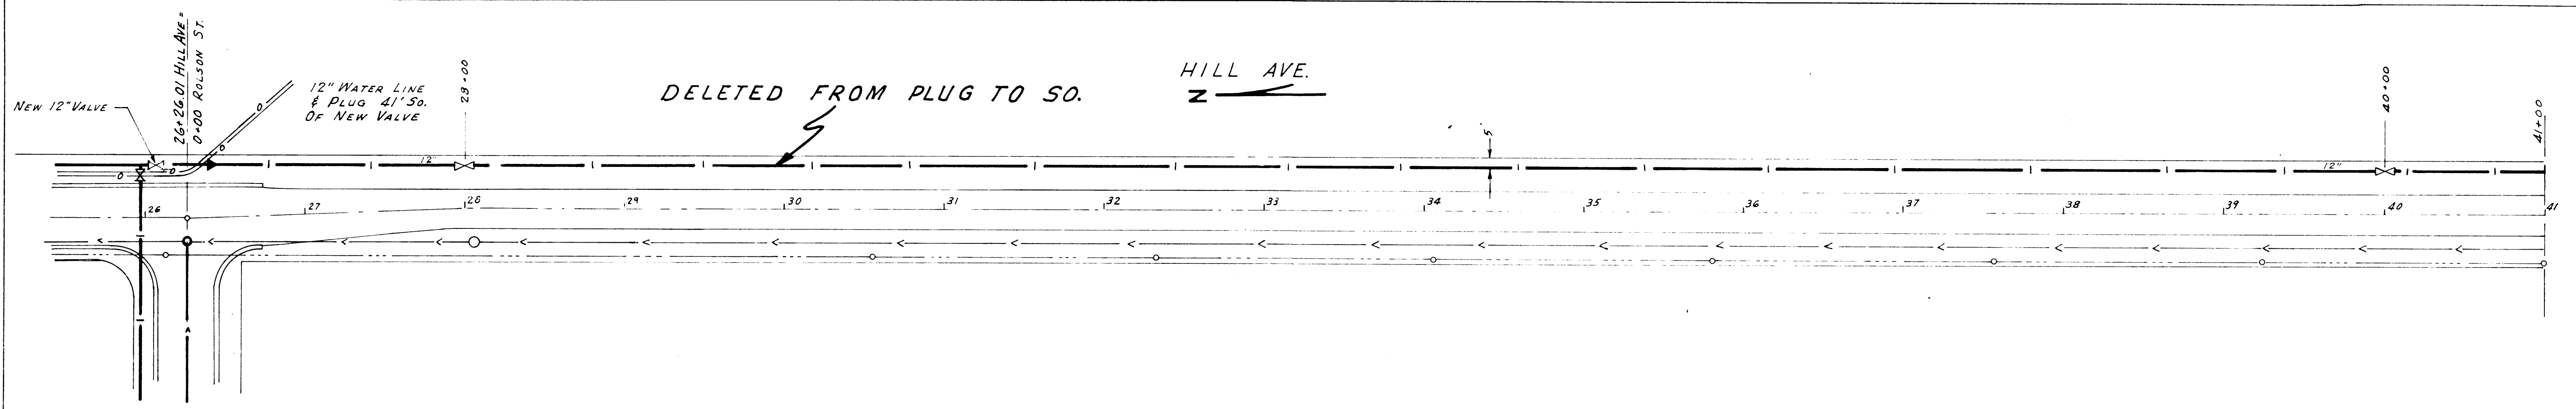


PLAN
 SURVEYED
 PLOTTED
 CHECKED
 BY
 DATE


PROFILE
 SURVEYED
 PLOTTED
 CHECKED
 BY
 DATE

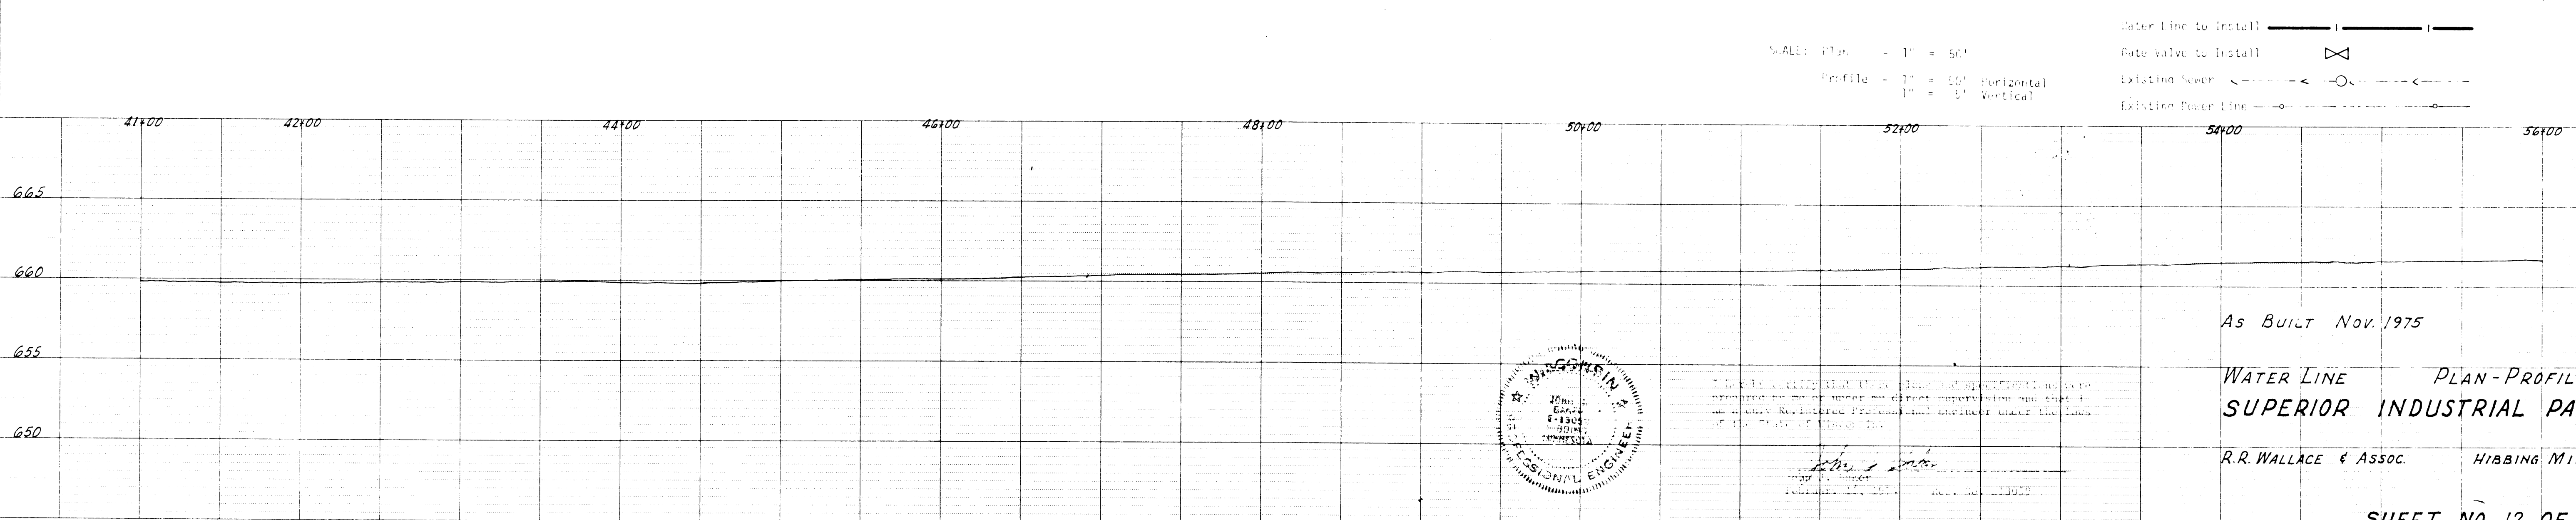

ALTERNATE No. 3
 ELIMINATE 12" WATER LINE FROM
 "C" STREET TO STINSON AVENUE

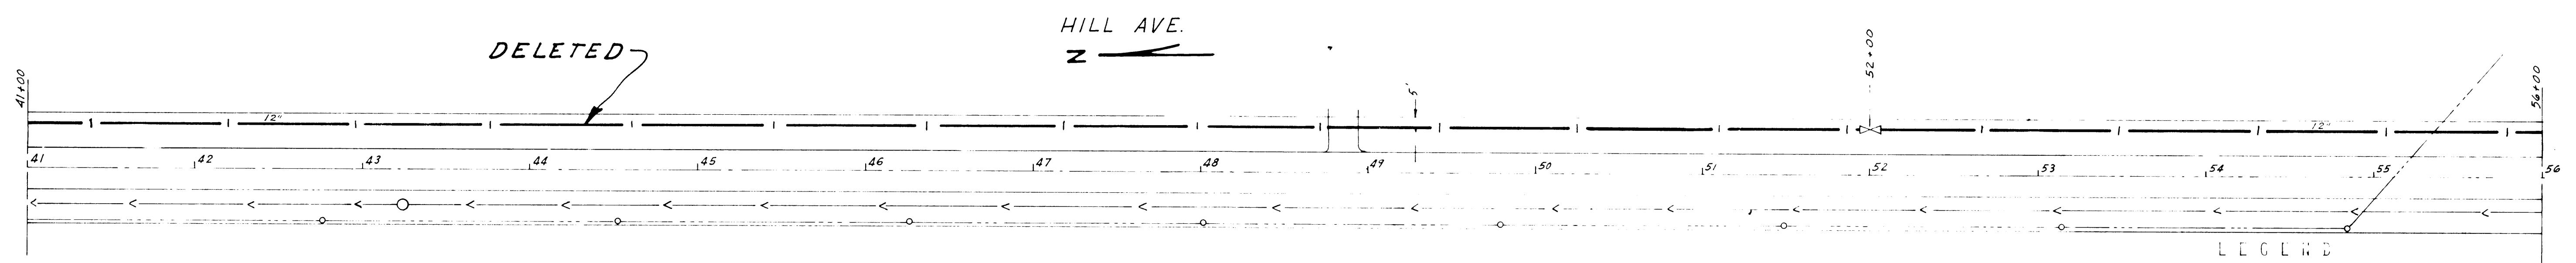

LEGEND
 Water Line to Install ————
 Gate Valve to Install ⊠
 Existing Sewer ————
 Existing Water Line ————
 SCALE: Plan - 1" = 50'
 Profile - 1" = 10' Horizontal
 1" = 5' Vertical

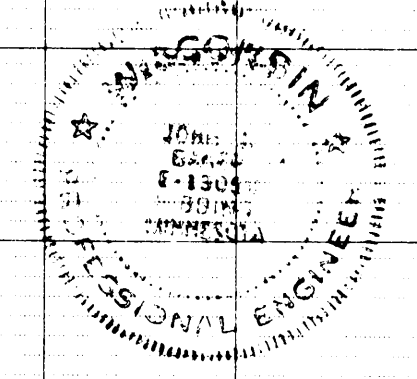

As Built Nov. 1975
 WATER LINE PLAN-PROFILES
 SUPERIOR INDUSTRIAL PARK
 R.R. WALLACE & ASSOC. HIBBING MINN.

SHEET NO. 12 OF 29