



NOTE: SEE SHEET NO 17 FOR SCHEDULE OF HILL AVE SANITARY MANHOLE COVER REPLACEMENT & HILL AVE SANITARY MANHOLE REPAIRS

CLEAN SANITARY SEWER LINE AND TELEVISION REMOVE EXISTING COVERS AND REPLACE WITH SOLID COVERS REPAIR AS REQUIRED

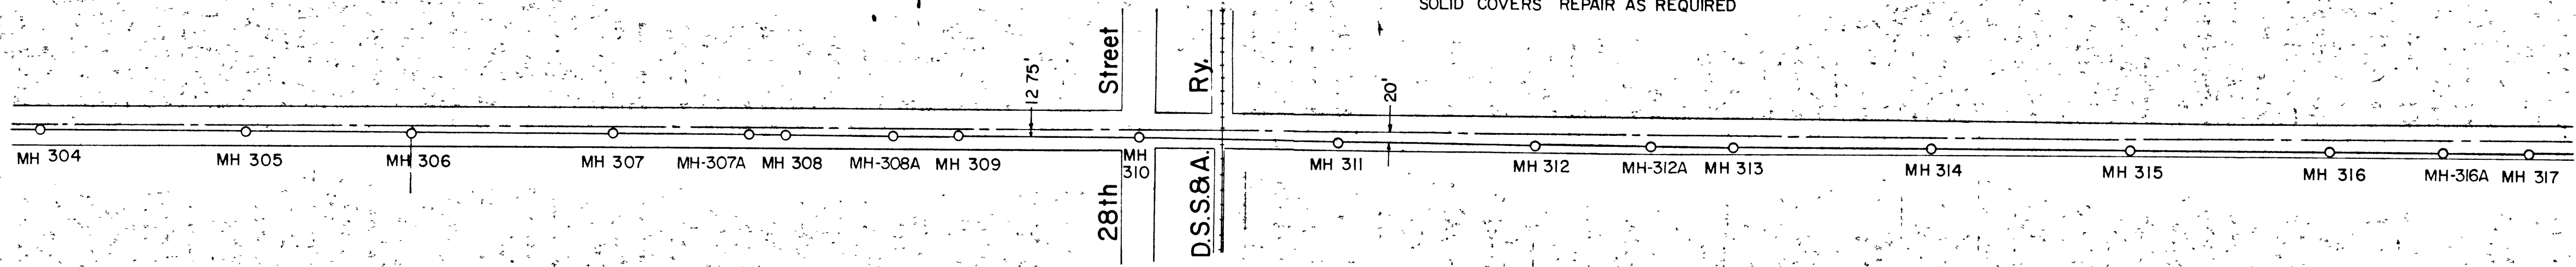


HILL AVENUE

Scale 1" = 200' Horiz
1" = 10' Vert.

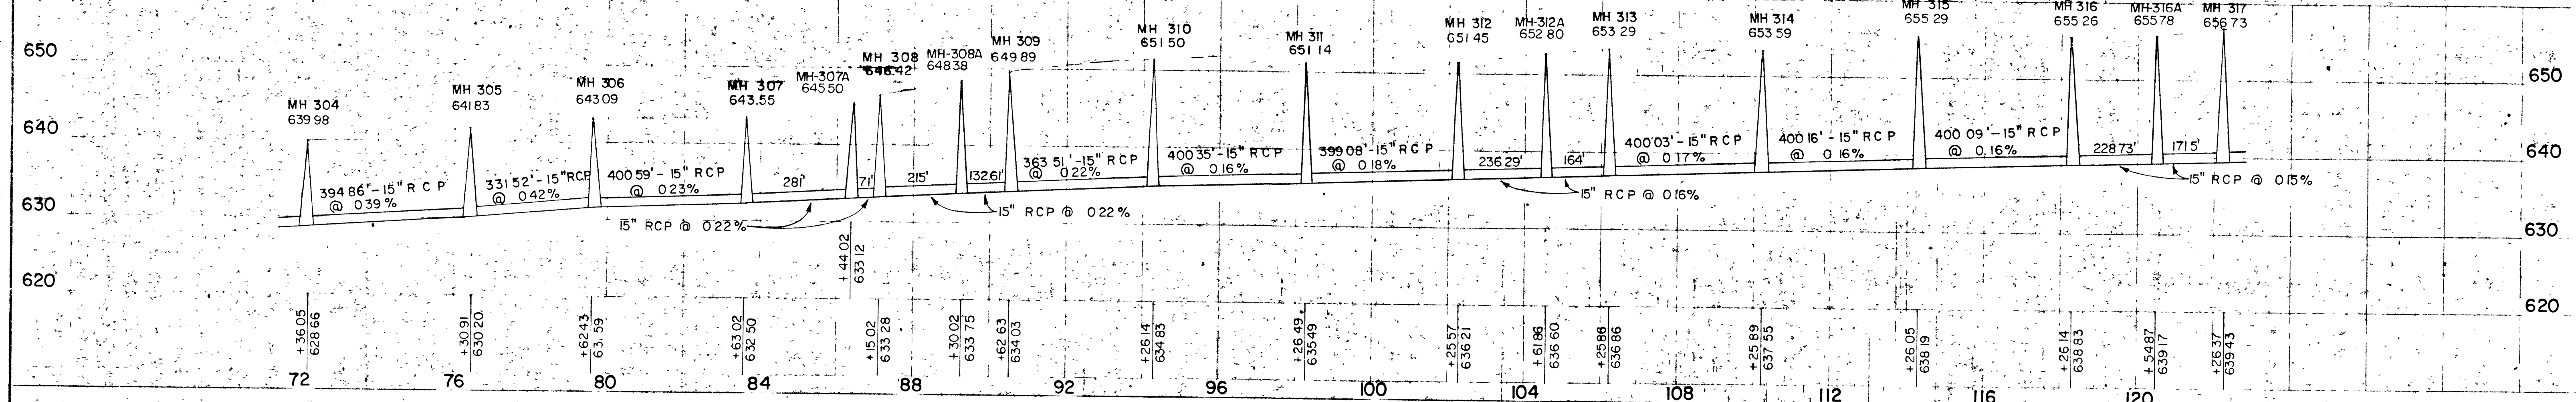


CLEAN SANITARY SEWER LINE AND TELEVISION REMOVE EXISTING COVERS AND REPLACE WITH SOLID COVERS REPAIR AS REQUIRED

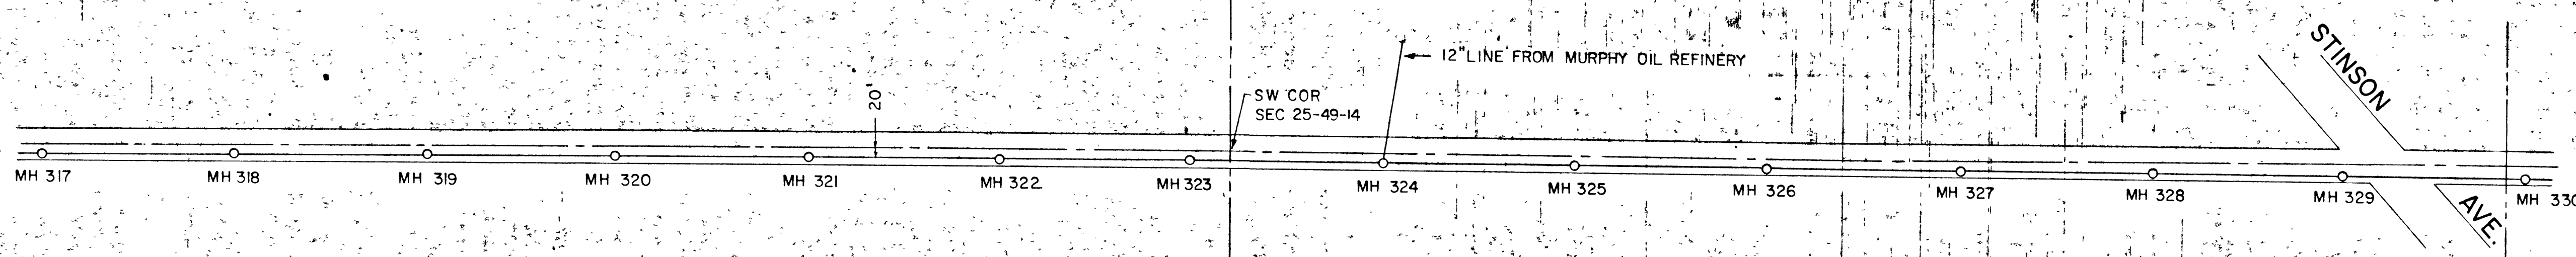

HILL AVENUE

Scale 1" = 200' Hor
1" = 10' Vert.

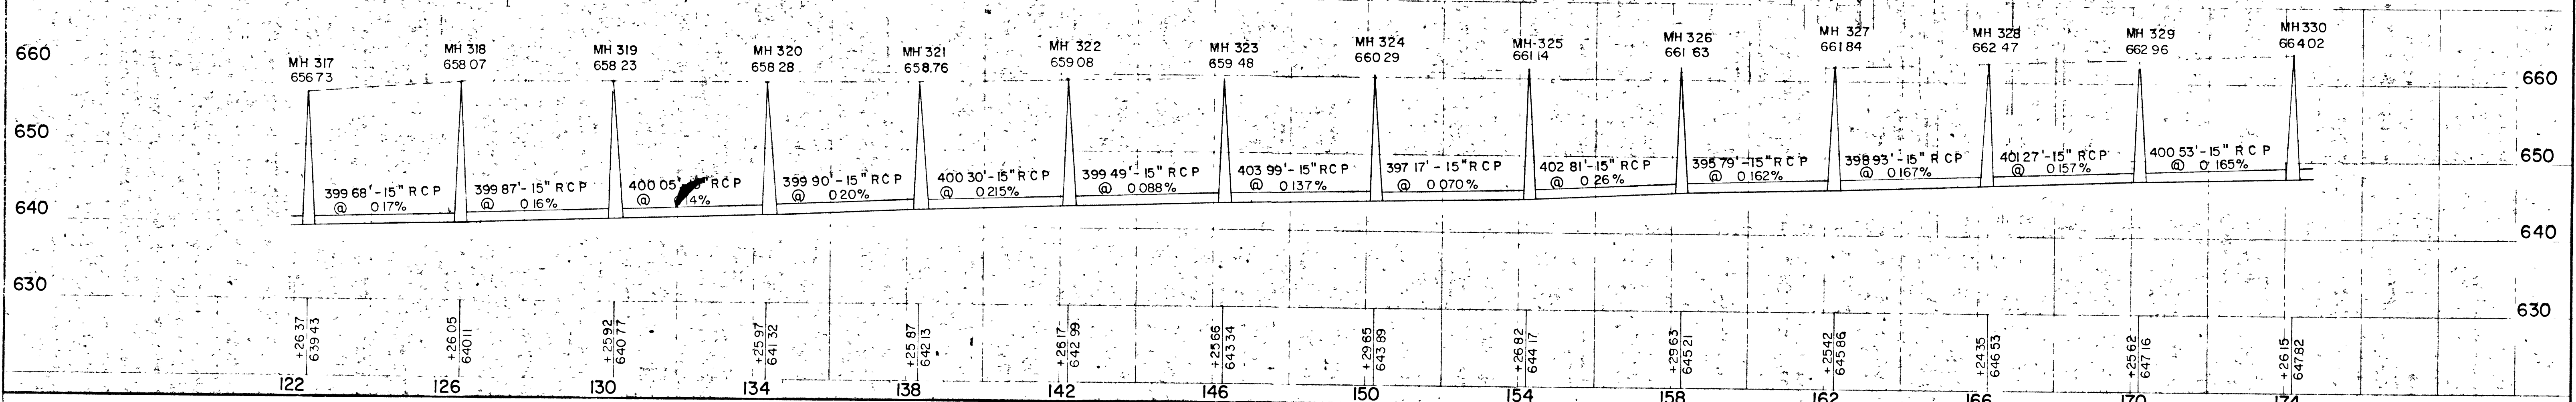

SURVEY		REVISIONS		BONESTROO, ROSENE, ANDERLIK & ASSOC., INC.		SUPERIOR, WISCONSIN		SOUTH SUPERIOR - DISTRICT 5	
DESIGN	LTS	RECORD	PLAN	ST. PAUL MINNESOTA		DATE JAN 15, 1976		TELEVISION	
APPROV D	GRC	3/15/79	HBR			COMM 6888 N		HILL AVE	