


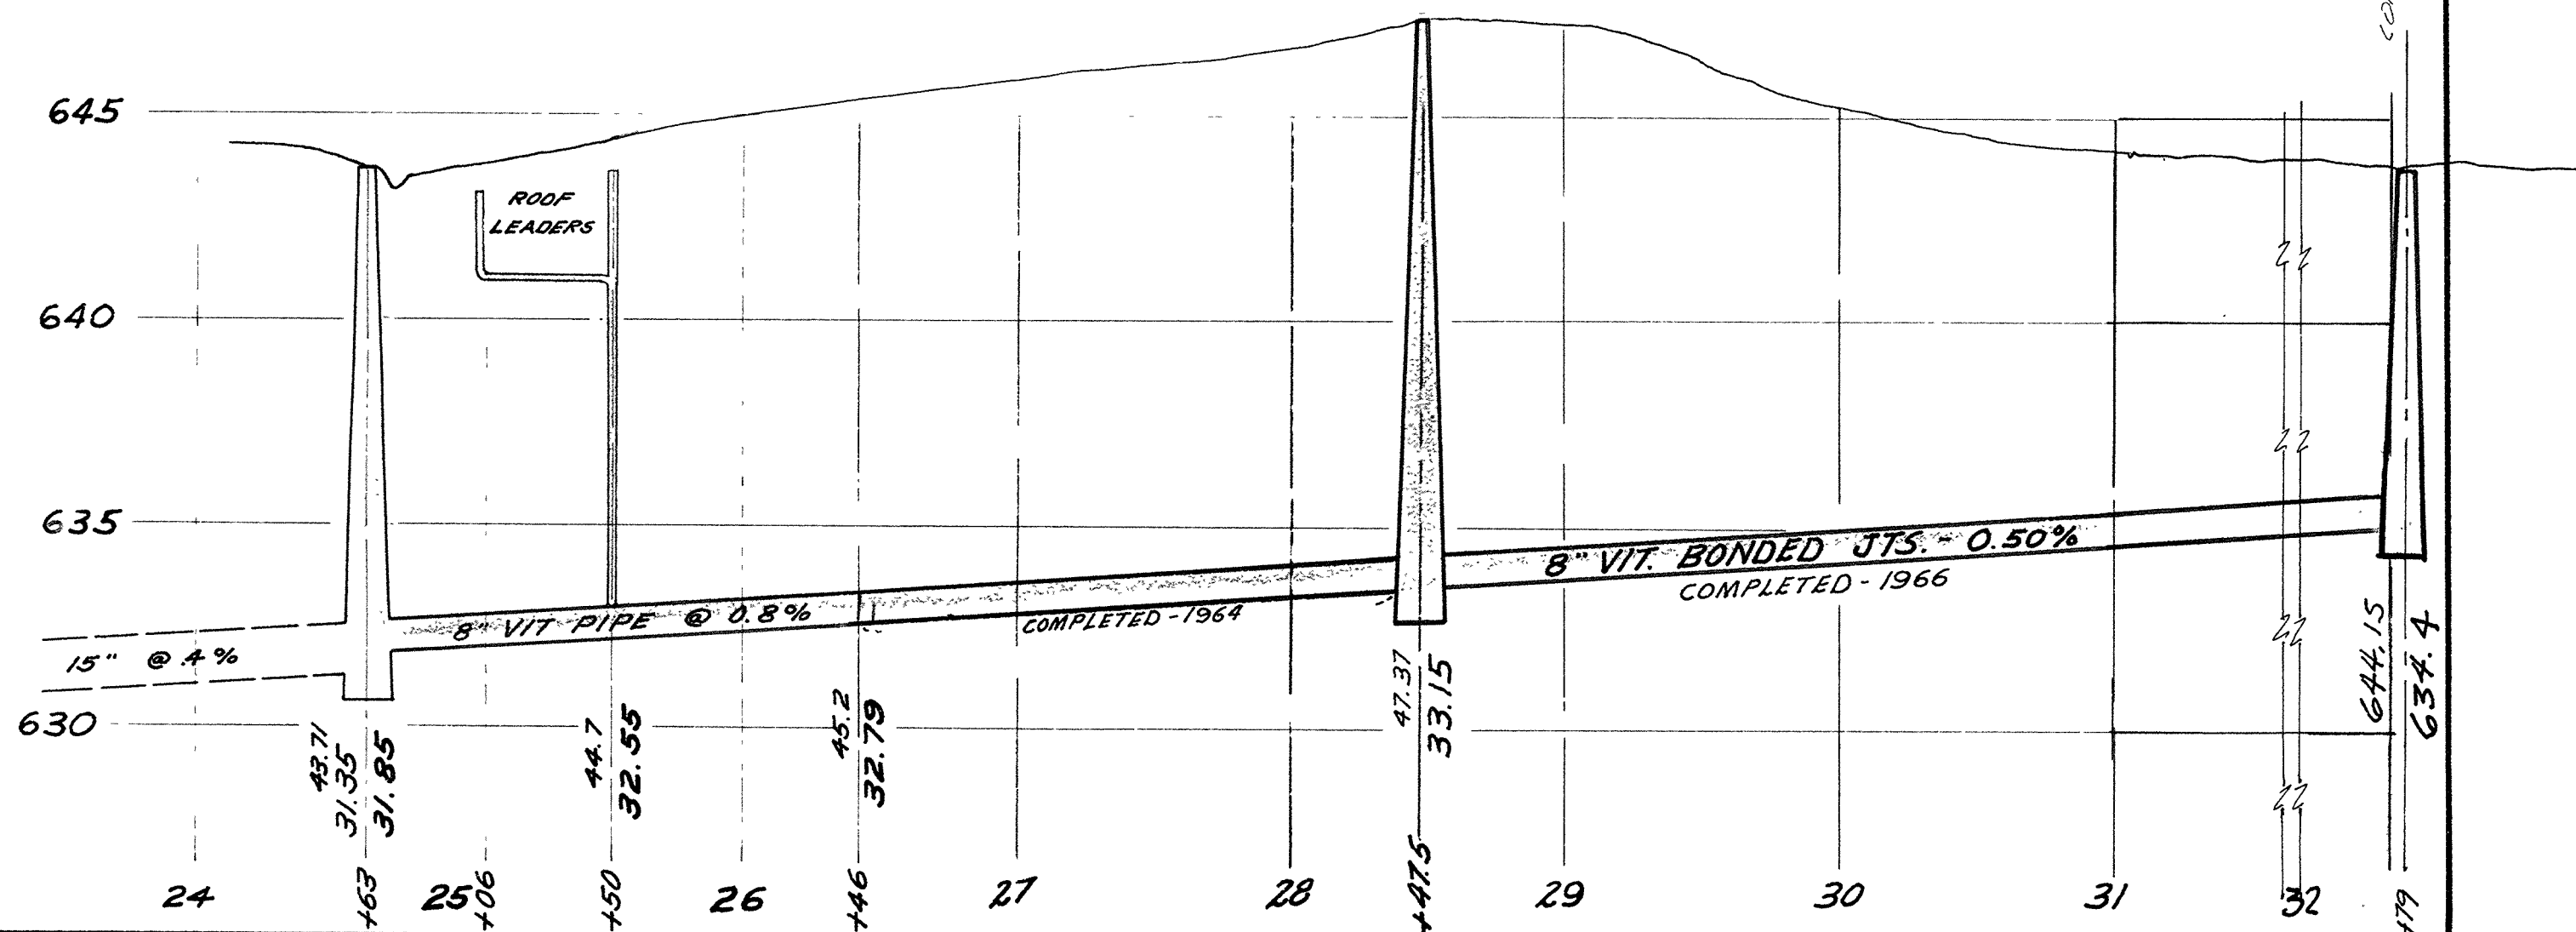

**CITY OF SUPERIOR  
SANITARY SEWER PLAN & PROFILE**

JOB STARTED OCT. 1959  
 JOB COMPLETED OCT. 1959  
 HORIZONTAL SCALE 1" = 60'  
 VERTICAL SCALE 1" = 4'  
 CITY ENGINEER E. W. BERG  
 CONTRACTOR BUILDERS SUPPLY



6-15

6-15

L.M.P.