
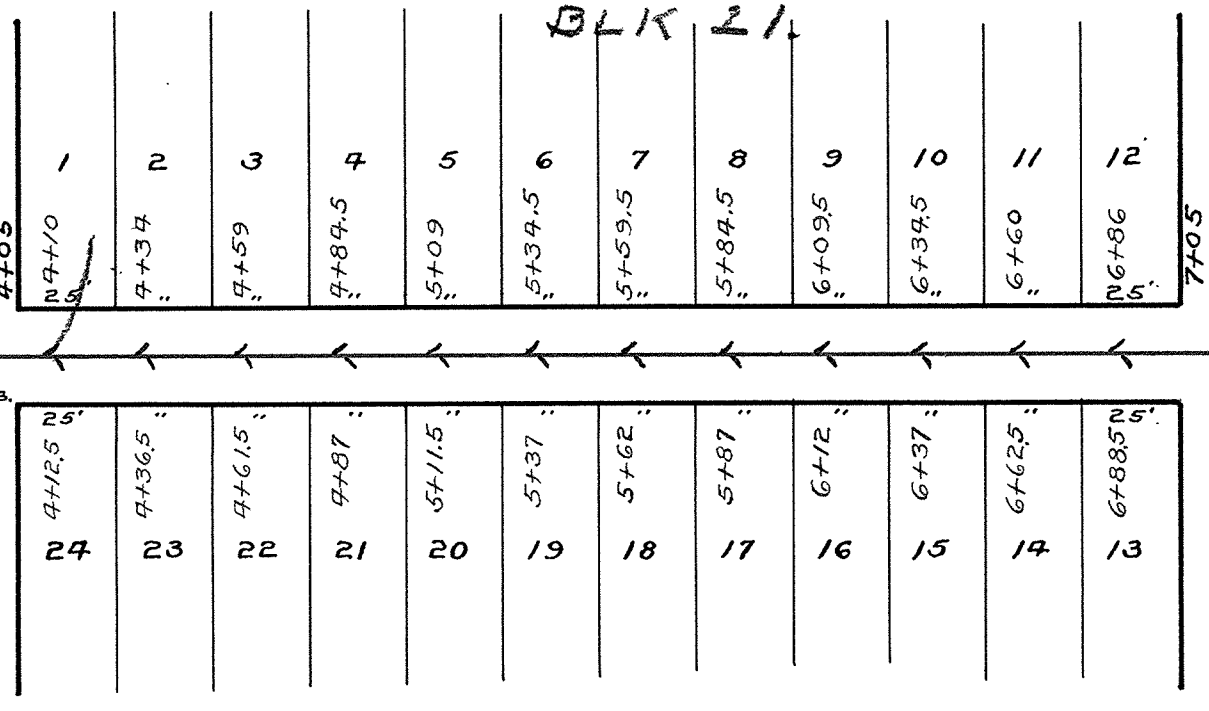


WELLINGTON


STREET

BLK 21

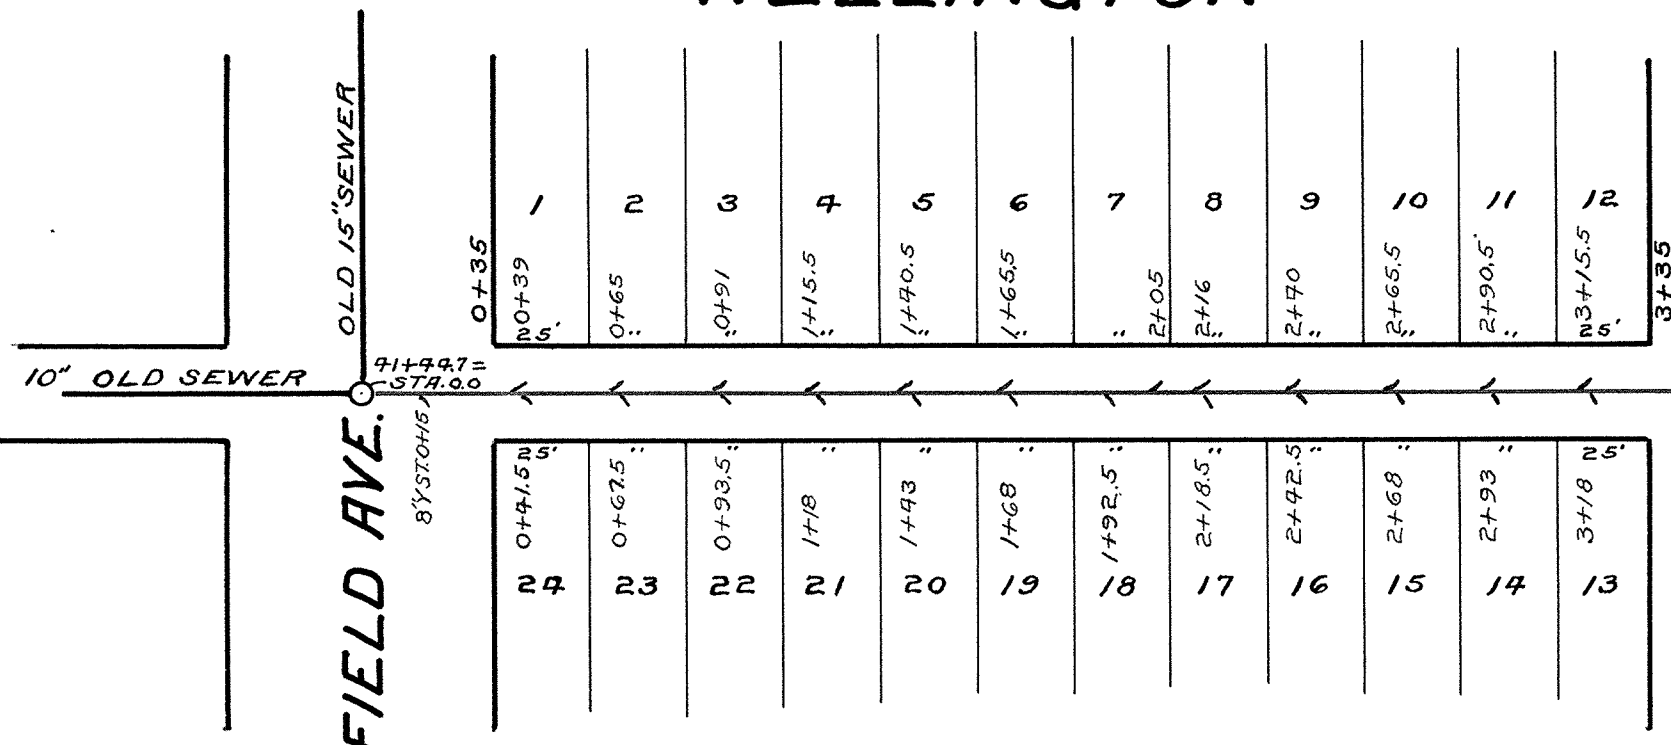

FELLOWS

STREET

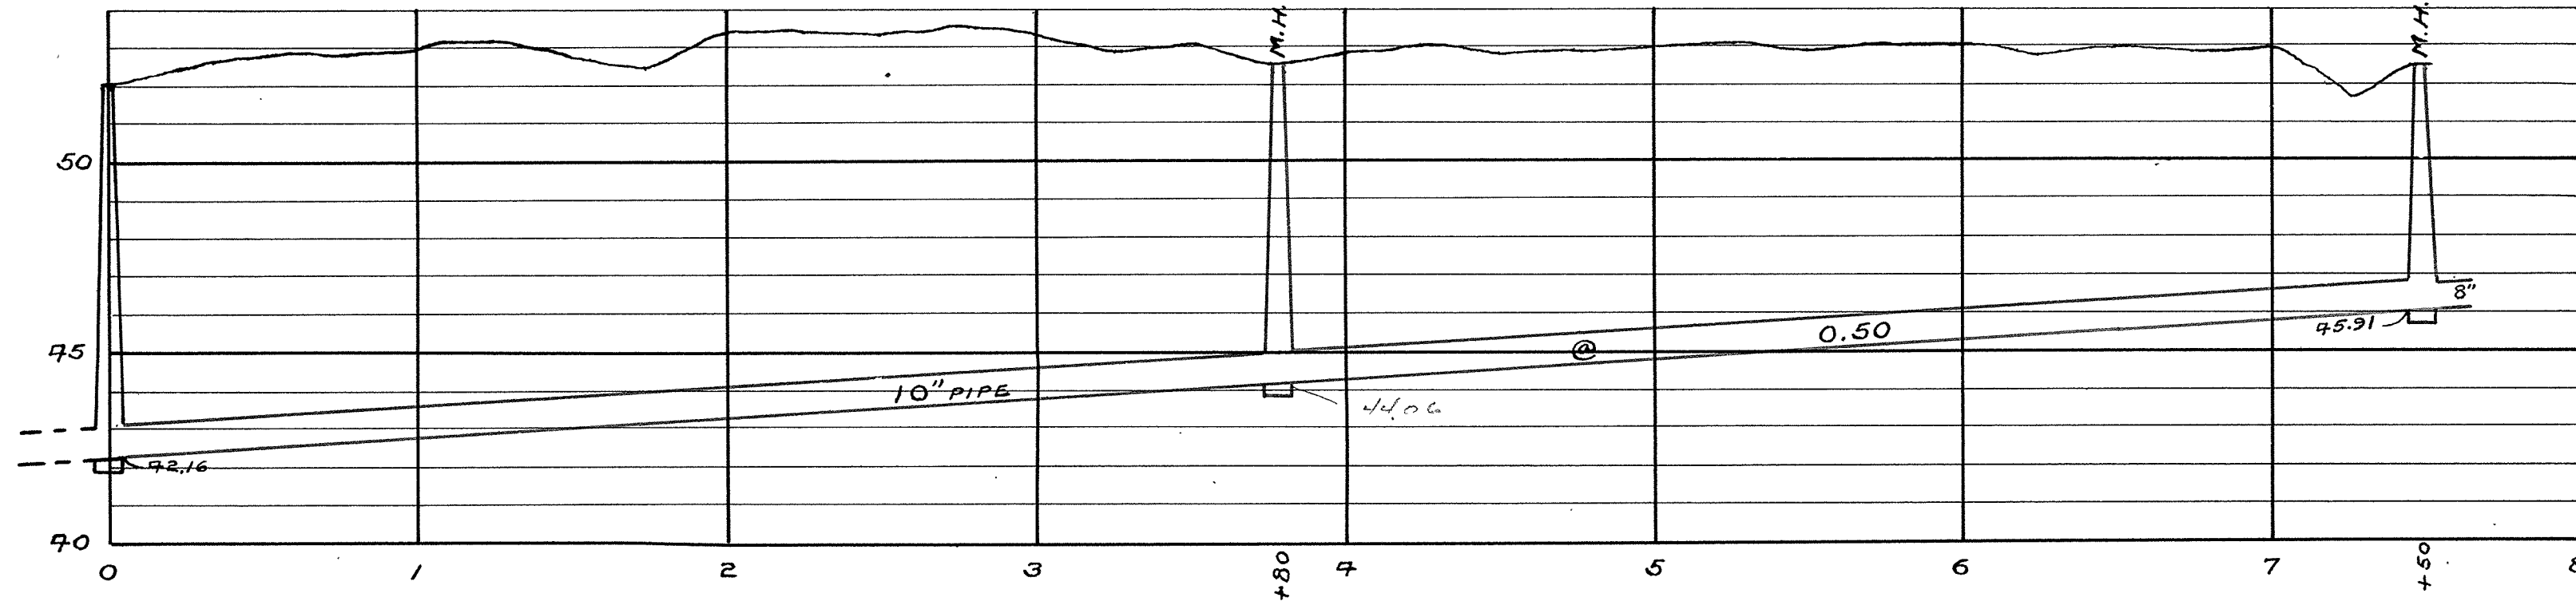

MAP AND PROFILE
 OF SEWER IN THE ALLEY BETWEEN WELLINGTON
 AND FELLOWS STREETS FROM GARFIELD AVENUE
 TO ELMIRA AVENUE IN THE CITY OF SUPERIOR WIS.
 CONTRACT NO 1743 CONTRACT LET DECEMBER 5TH 1927
 CONTRACT COMPLETED FEBRUARY 15TH 1928
 CONTRACTOR MAGNUS PETERSON
 HORIZONTAL SCALE:-1"=50' VERTICAL SCALE:-1"=5'
 E.B. BANKS CITY ENGR.

6-23B