

# CITY OF SUPERIOR SEWER PLAN

Horizontal Scale: 1 in. = 60 ft.  
Vertical Scale: 1 in. = 4 ft.

CONTRACT N° 1414



Contract let June 18-14.

Contract completed

Riches & Anderson Contractors

W. E. Kealy Inspector

E. B. Banks City Engineer.

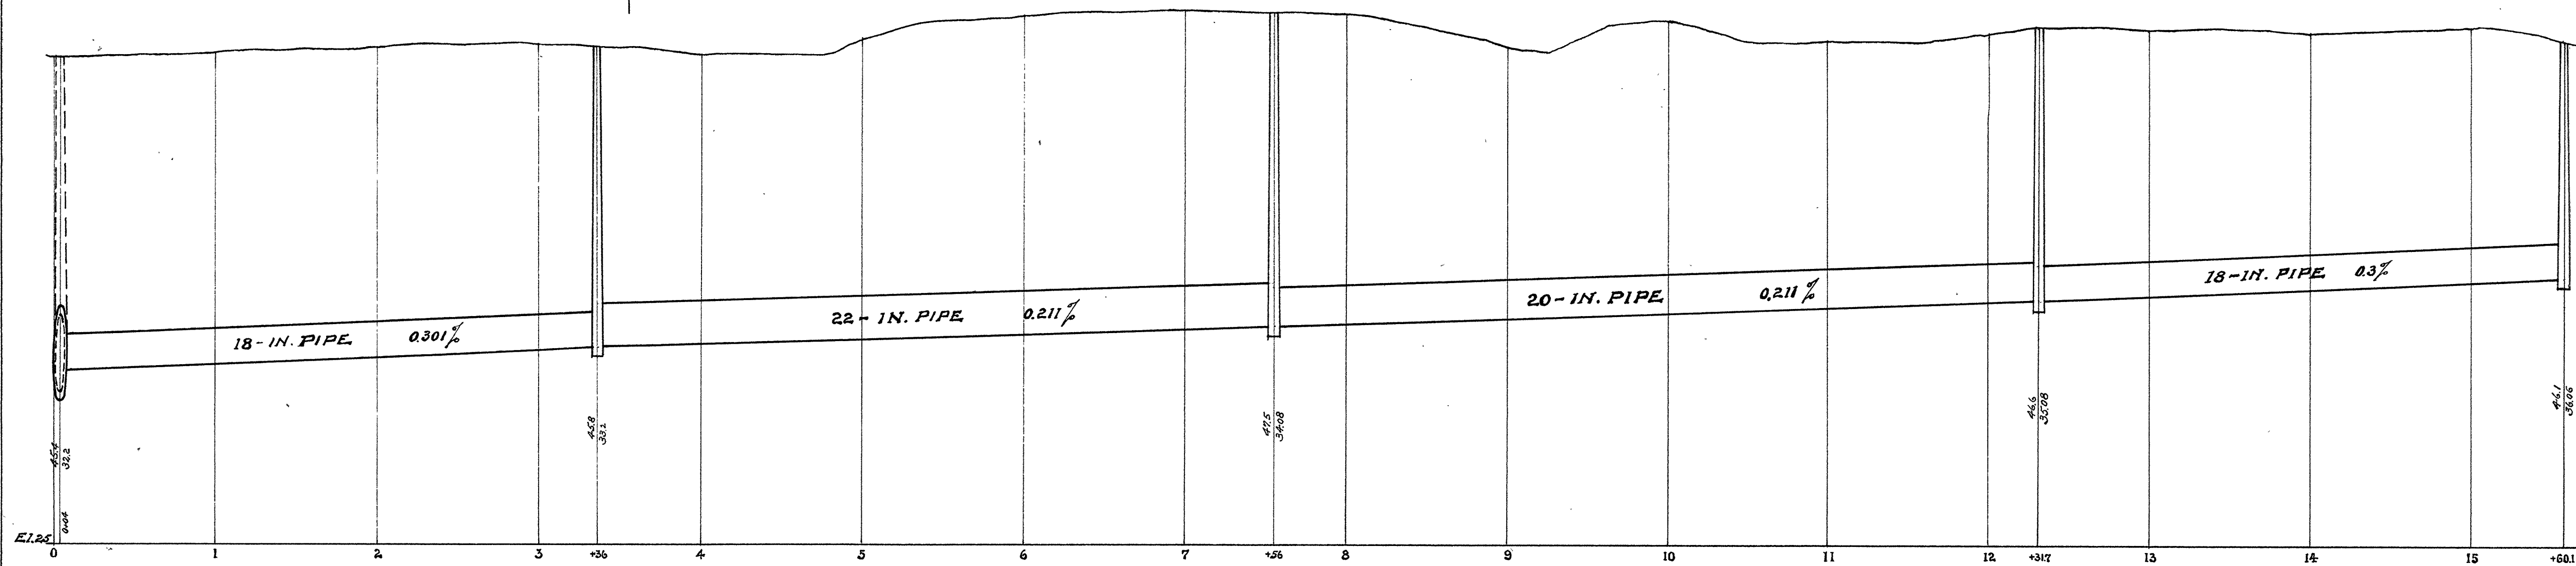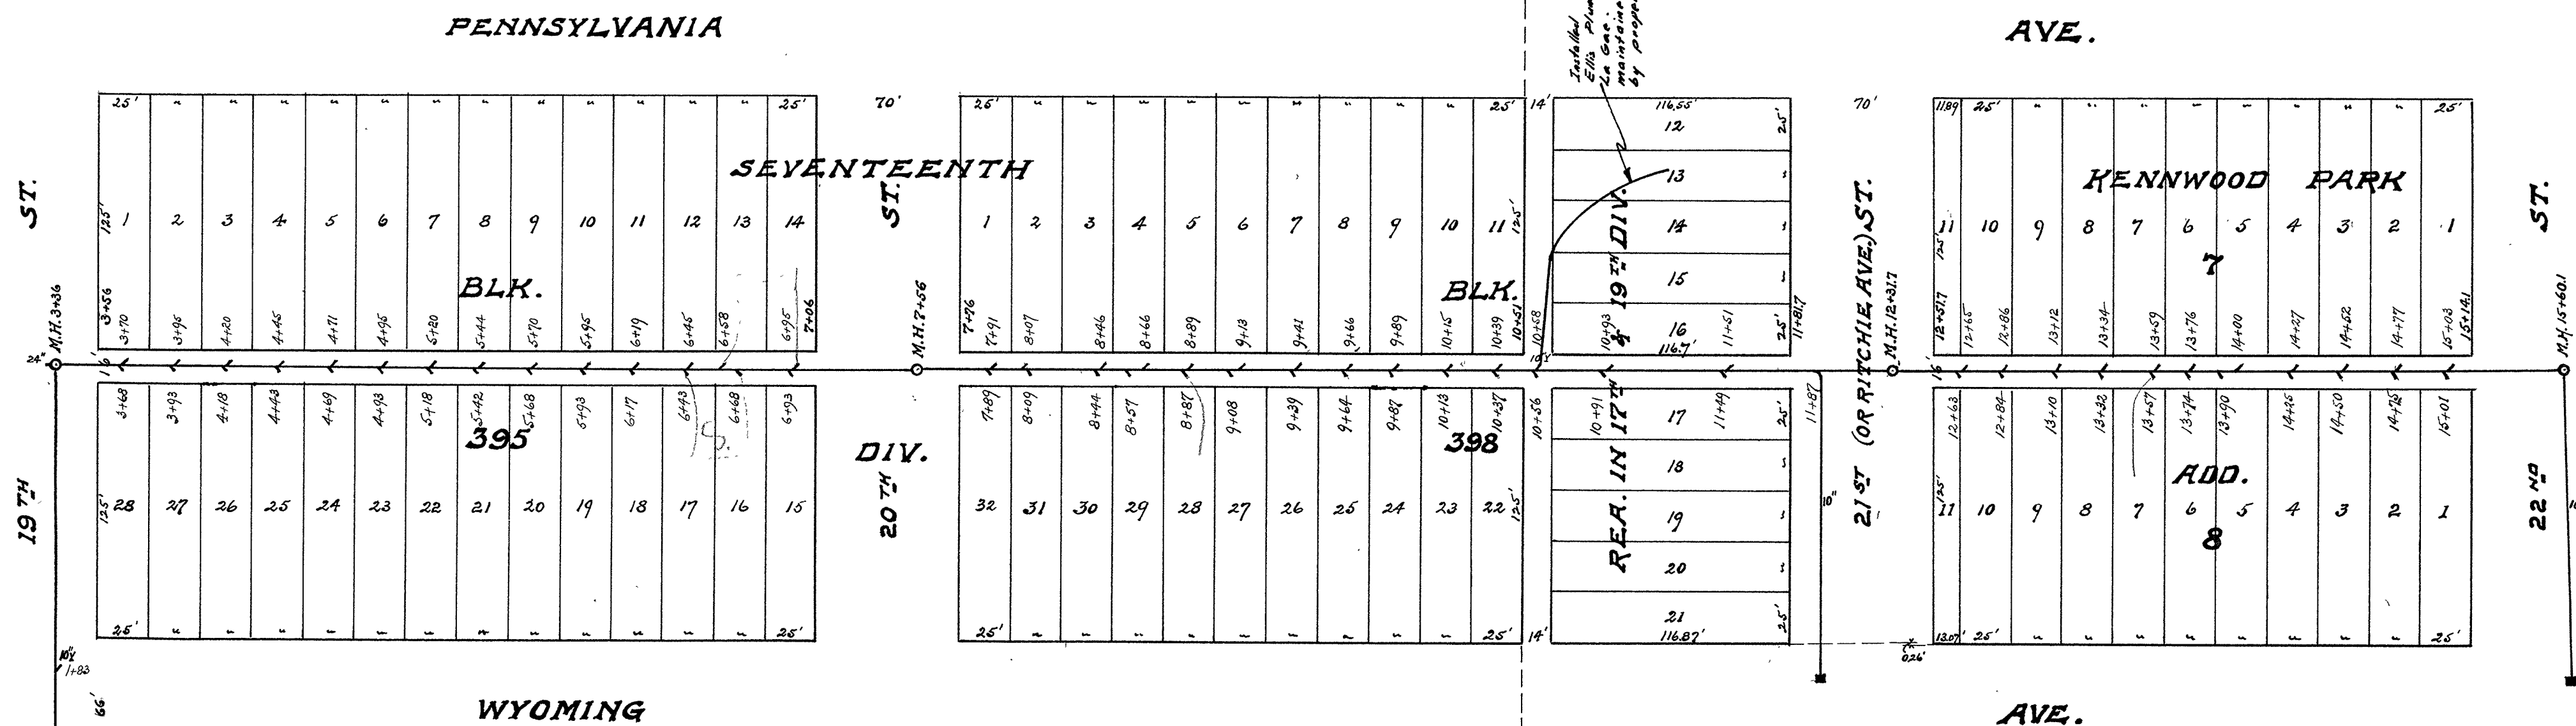

6-29