


NOTE: ALL JOINTS HOT POURED (ASPHALTIC BASE)

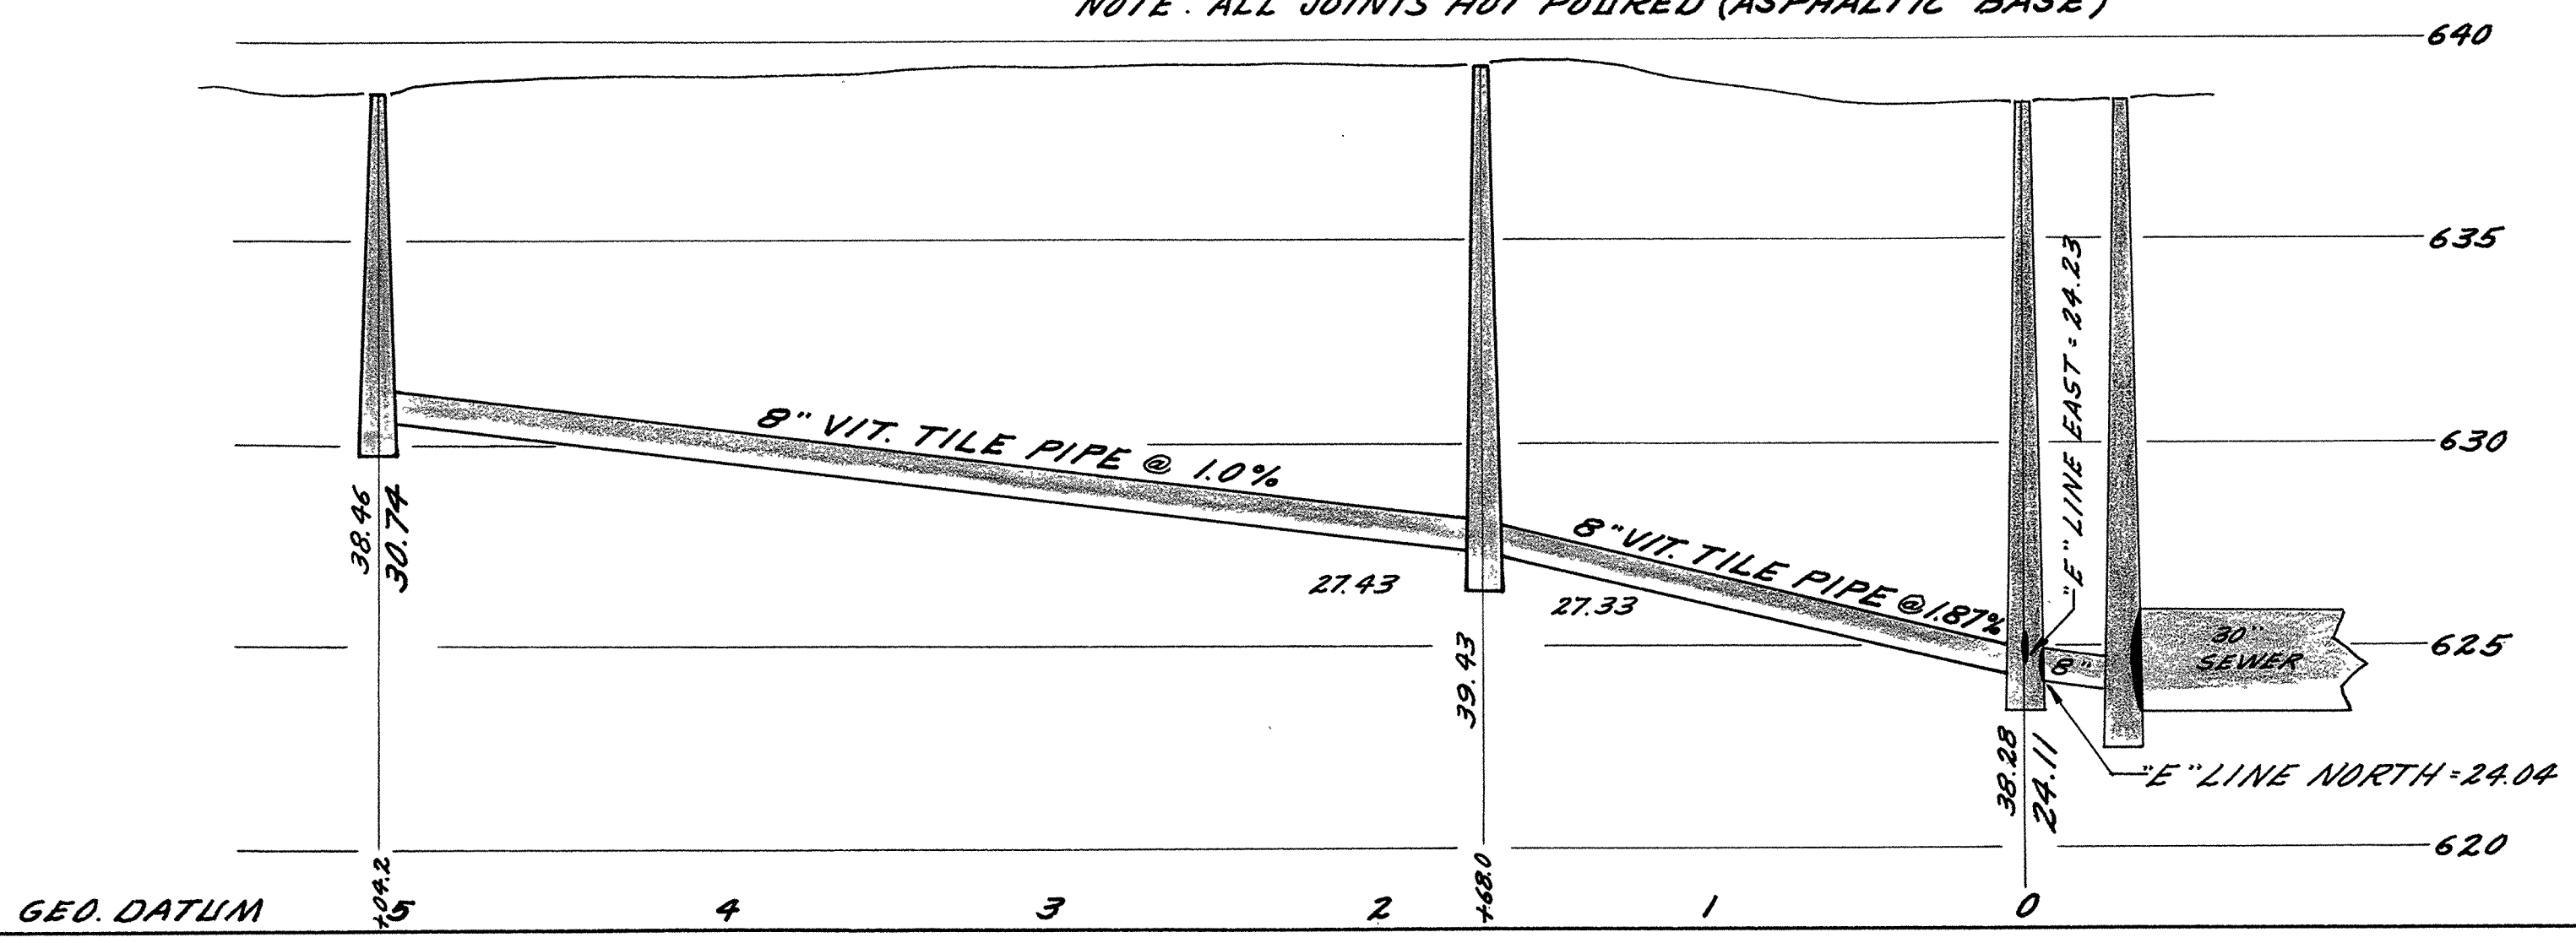

CITY OF SUPERIOR
SANITARY SEWER DIST. NO. 6

JOB STARTED - AUGUST 1960
 JOB COMPLETED - SEPTEMBER 1960
 HORIZONTAL SCALE - 1"=50'
 VERTICAL SCALE - 1"=4'
 CITY ENGINEER - E.W. BERG
 CONTRACTOR - BUILDERS SUPPLY CO.