
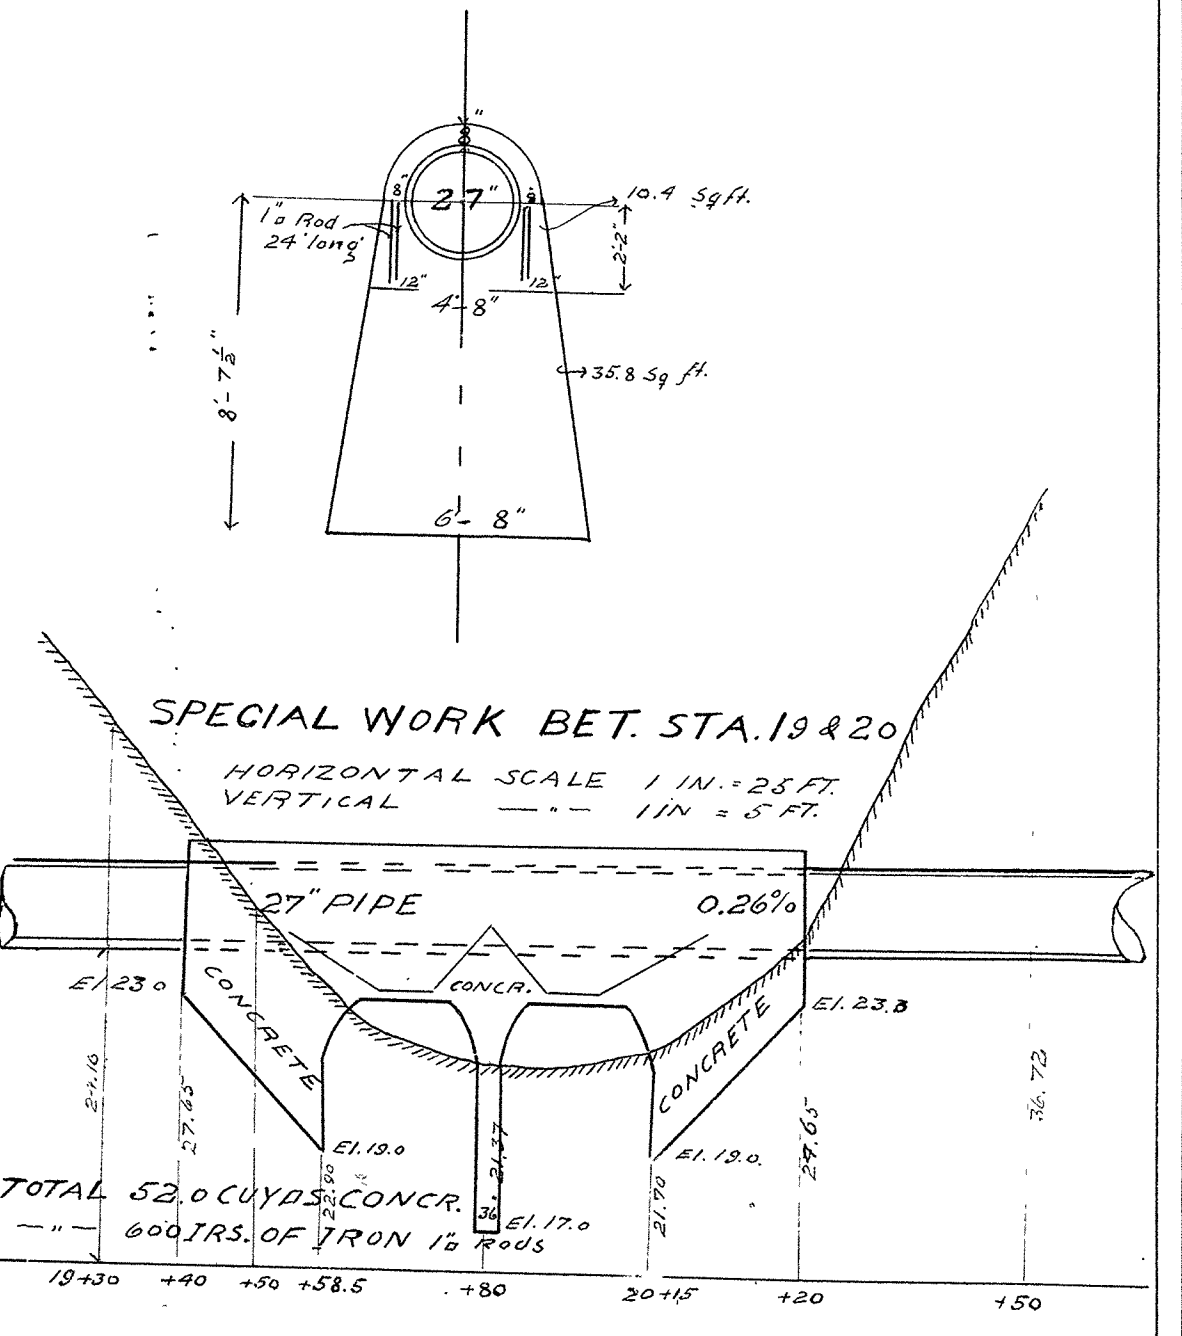


TO ROYALTON MANOR

HORIZONTAL SCALE 1 IN. = 80 FT.  
 VERTICAL SCALE 1 IN. = 60 FT.

CONTRACT NO 1545

Contract let September 27<sup>th</sup> 1916  
 Contract completed RICHES CEMENT PIPE USED  
 Riches & Sons Contractor  
 J.B. Graham  
 E.M. Steffenson } Inspectors  
 Andrew Solin }  
 E.B. Banks City Engineer.

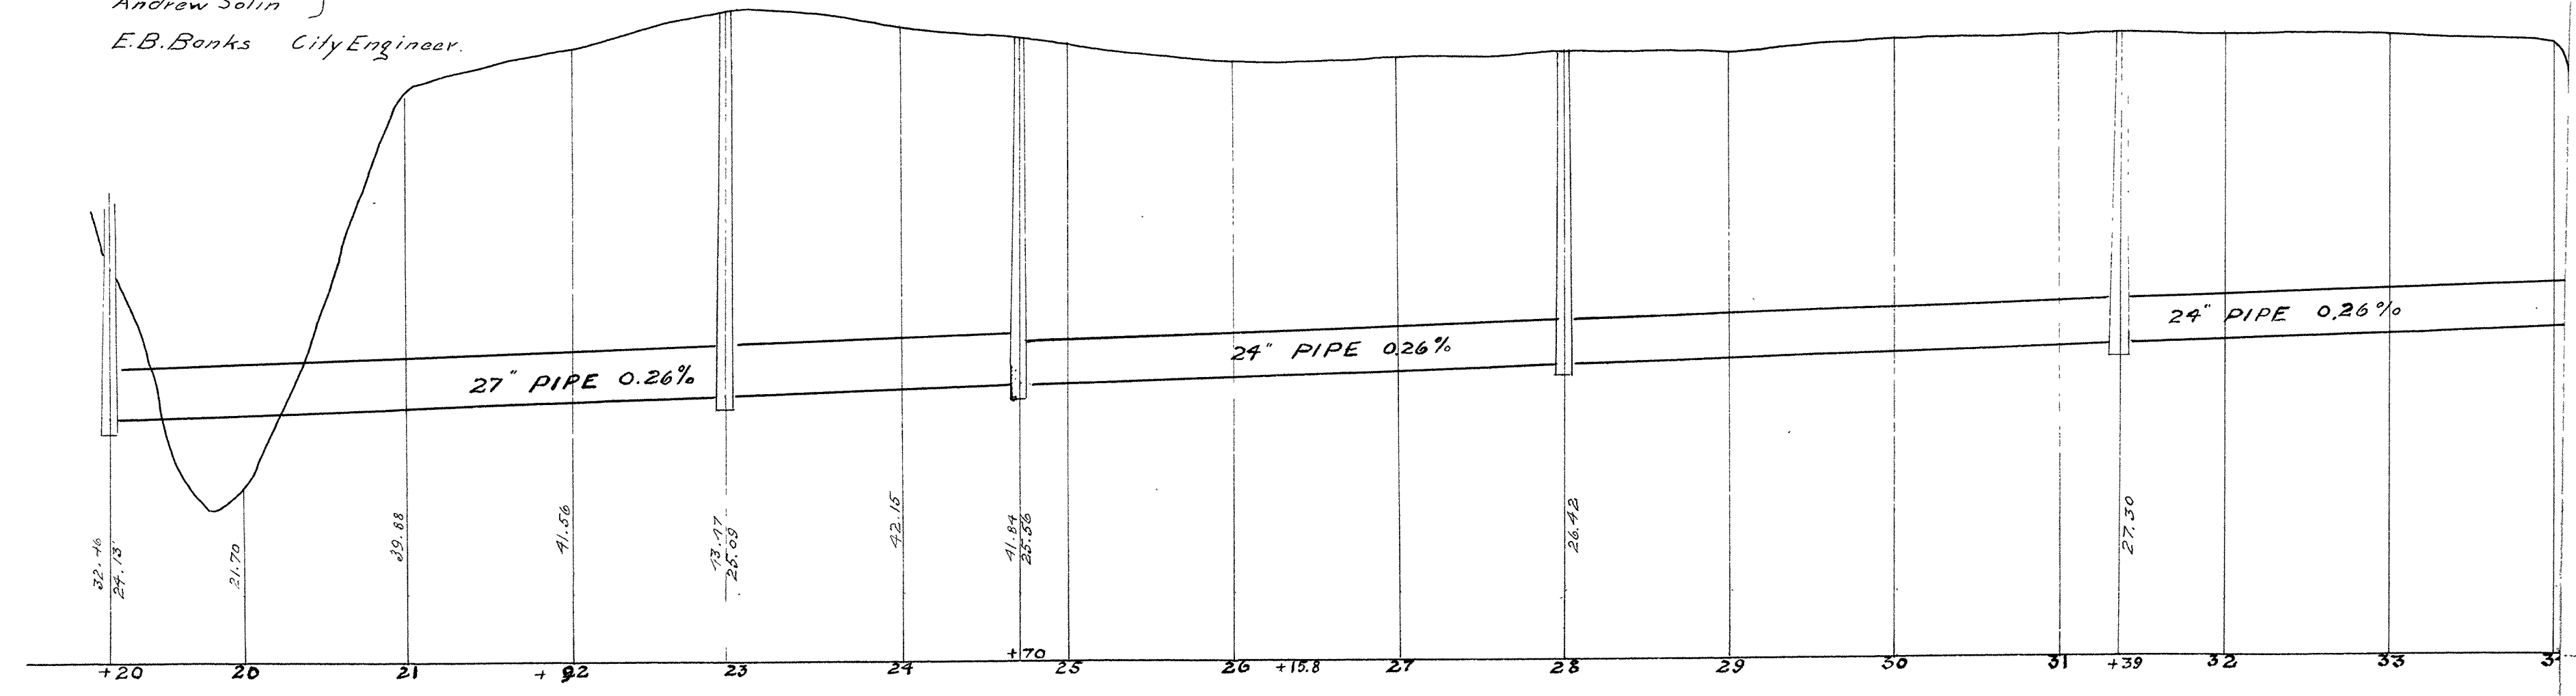

L-37