


CITY OF SUPERIOR
SANITARY SEWER DIST. NO 6
 JOB STARTED MAY 1960
 JOB COMPLETED JULY 1960
 HORIZONTAL SCALE 1"=50'
 VERTICAL SCALE 1"=4'
 CITY ENGINEER E.W. BERG
 CONTRACTOR BUILDERS SUPPLY CO.

NOTE: ALL JOINTS HOT POURED (ASPHALTIC BASE)

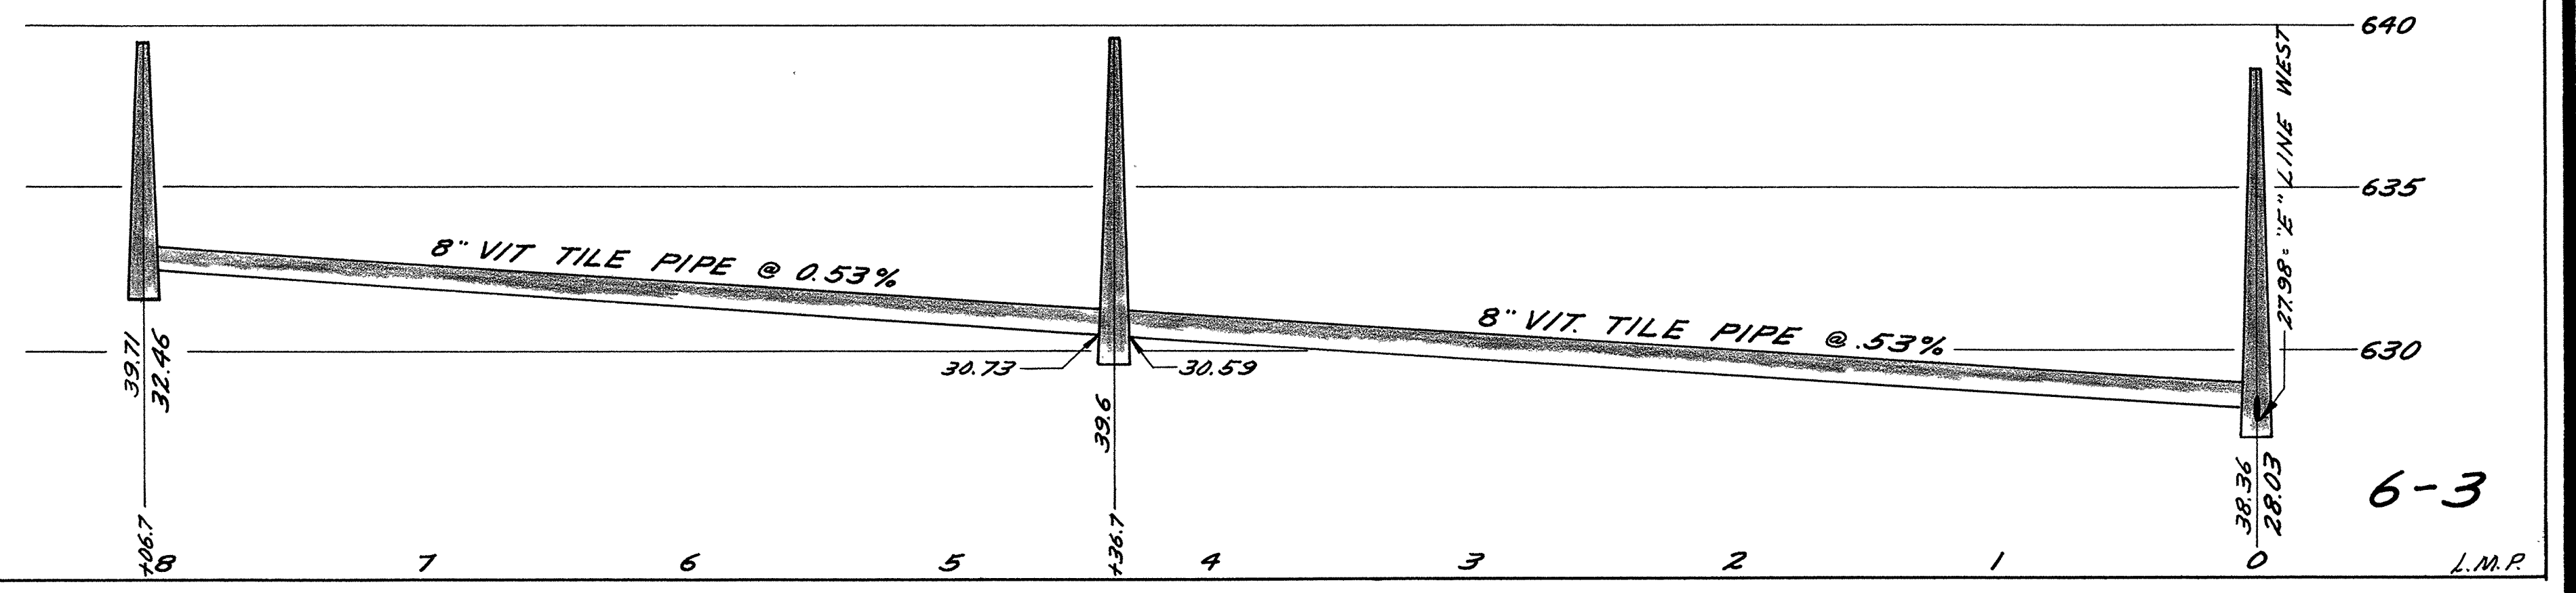

6-3