


CITY OF SUPERIOR SEWER PLAN

HORIZONTAL SCALE 1" = 60'
VERTICAL SCALE 1" = 4'

W.P.A. LABOR
F. BIRCH INSPECTOR

JOB STARTED MARCH, 1938
COMPLETED JUNE, 1938

T.M. BASTERASH CITY ENGINEER

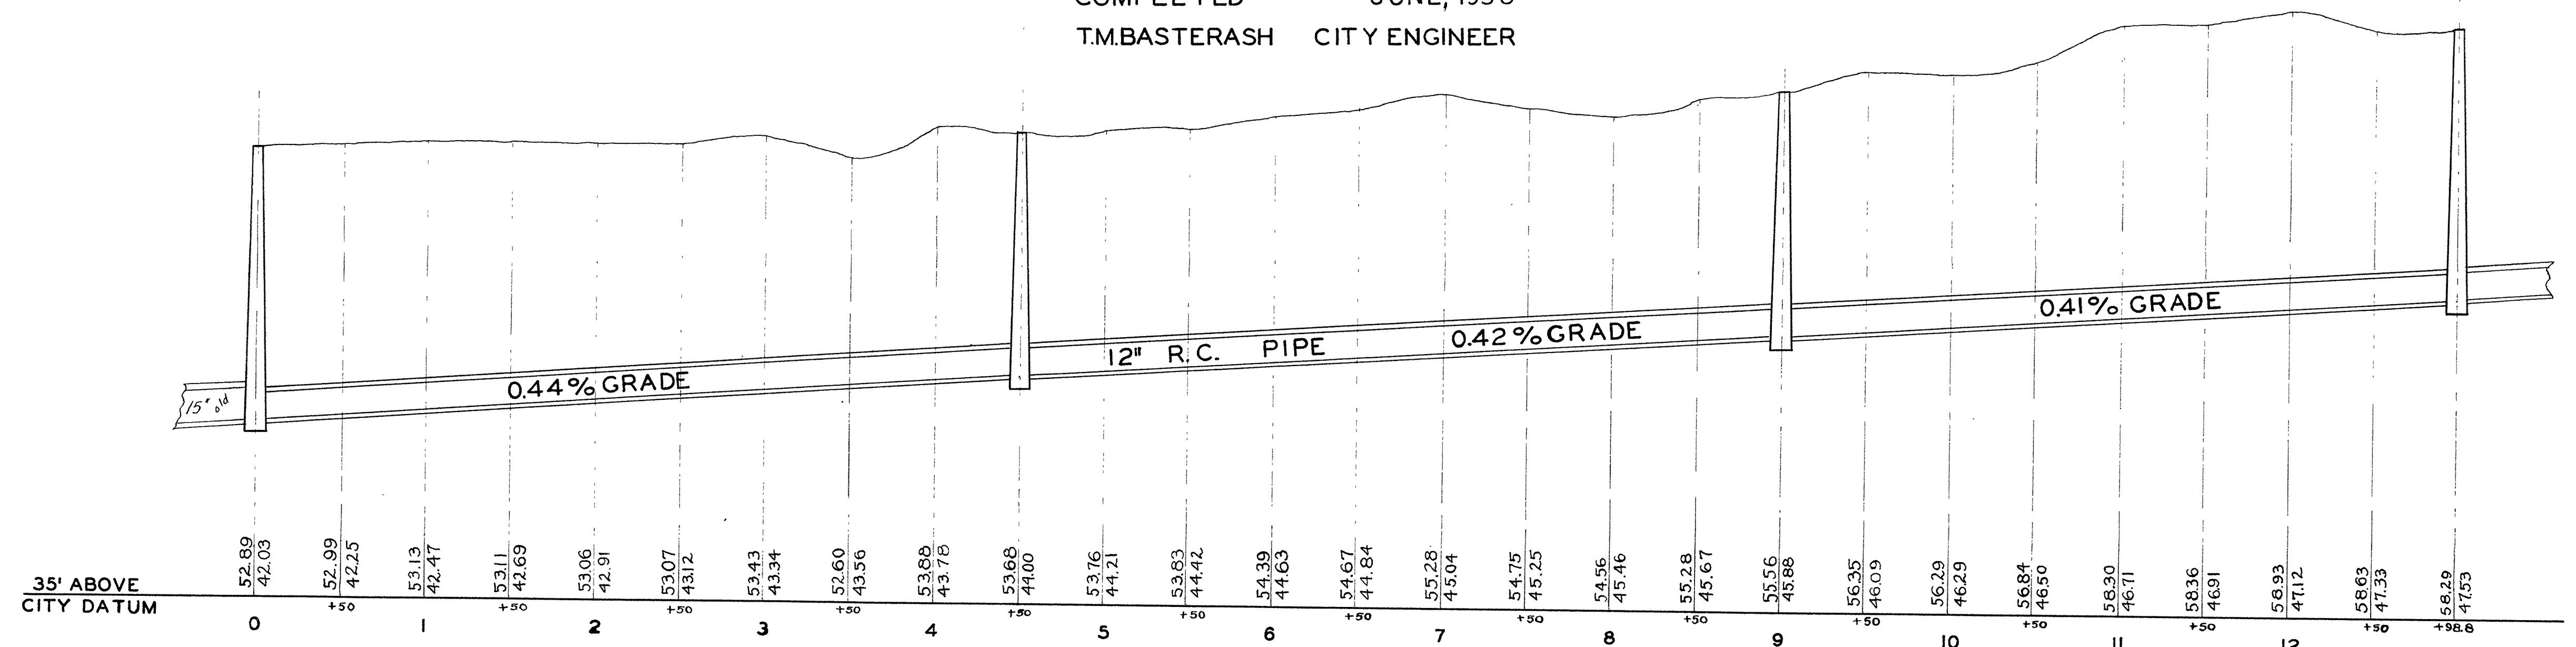

6-44