


CITY OF SUPERIOR
SANITARY SEWER DIST. NO. 6
 JOB STARTED OCTOBER 1960
 JOB COMPLETED OCTOBER 1960
 HORIZONTAL SCALE 1" = 50'
 VERTICAL SCALE 1" = 4'
 CITY ENGINEER E. W. BERG
 CONTRACTOR STANDARD CONTRACTING CO.

NOTE: ALL JOINTS HOT POURED (PLASTIC BASE)

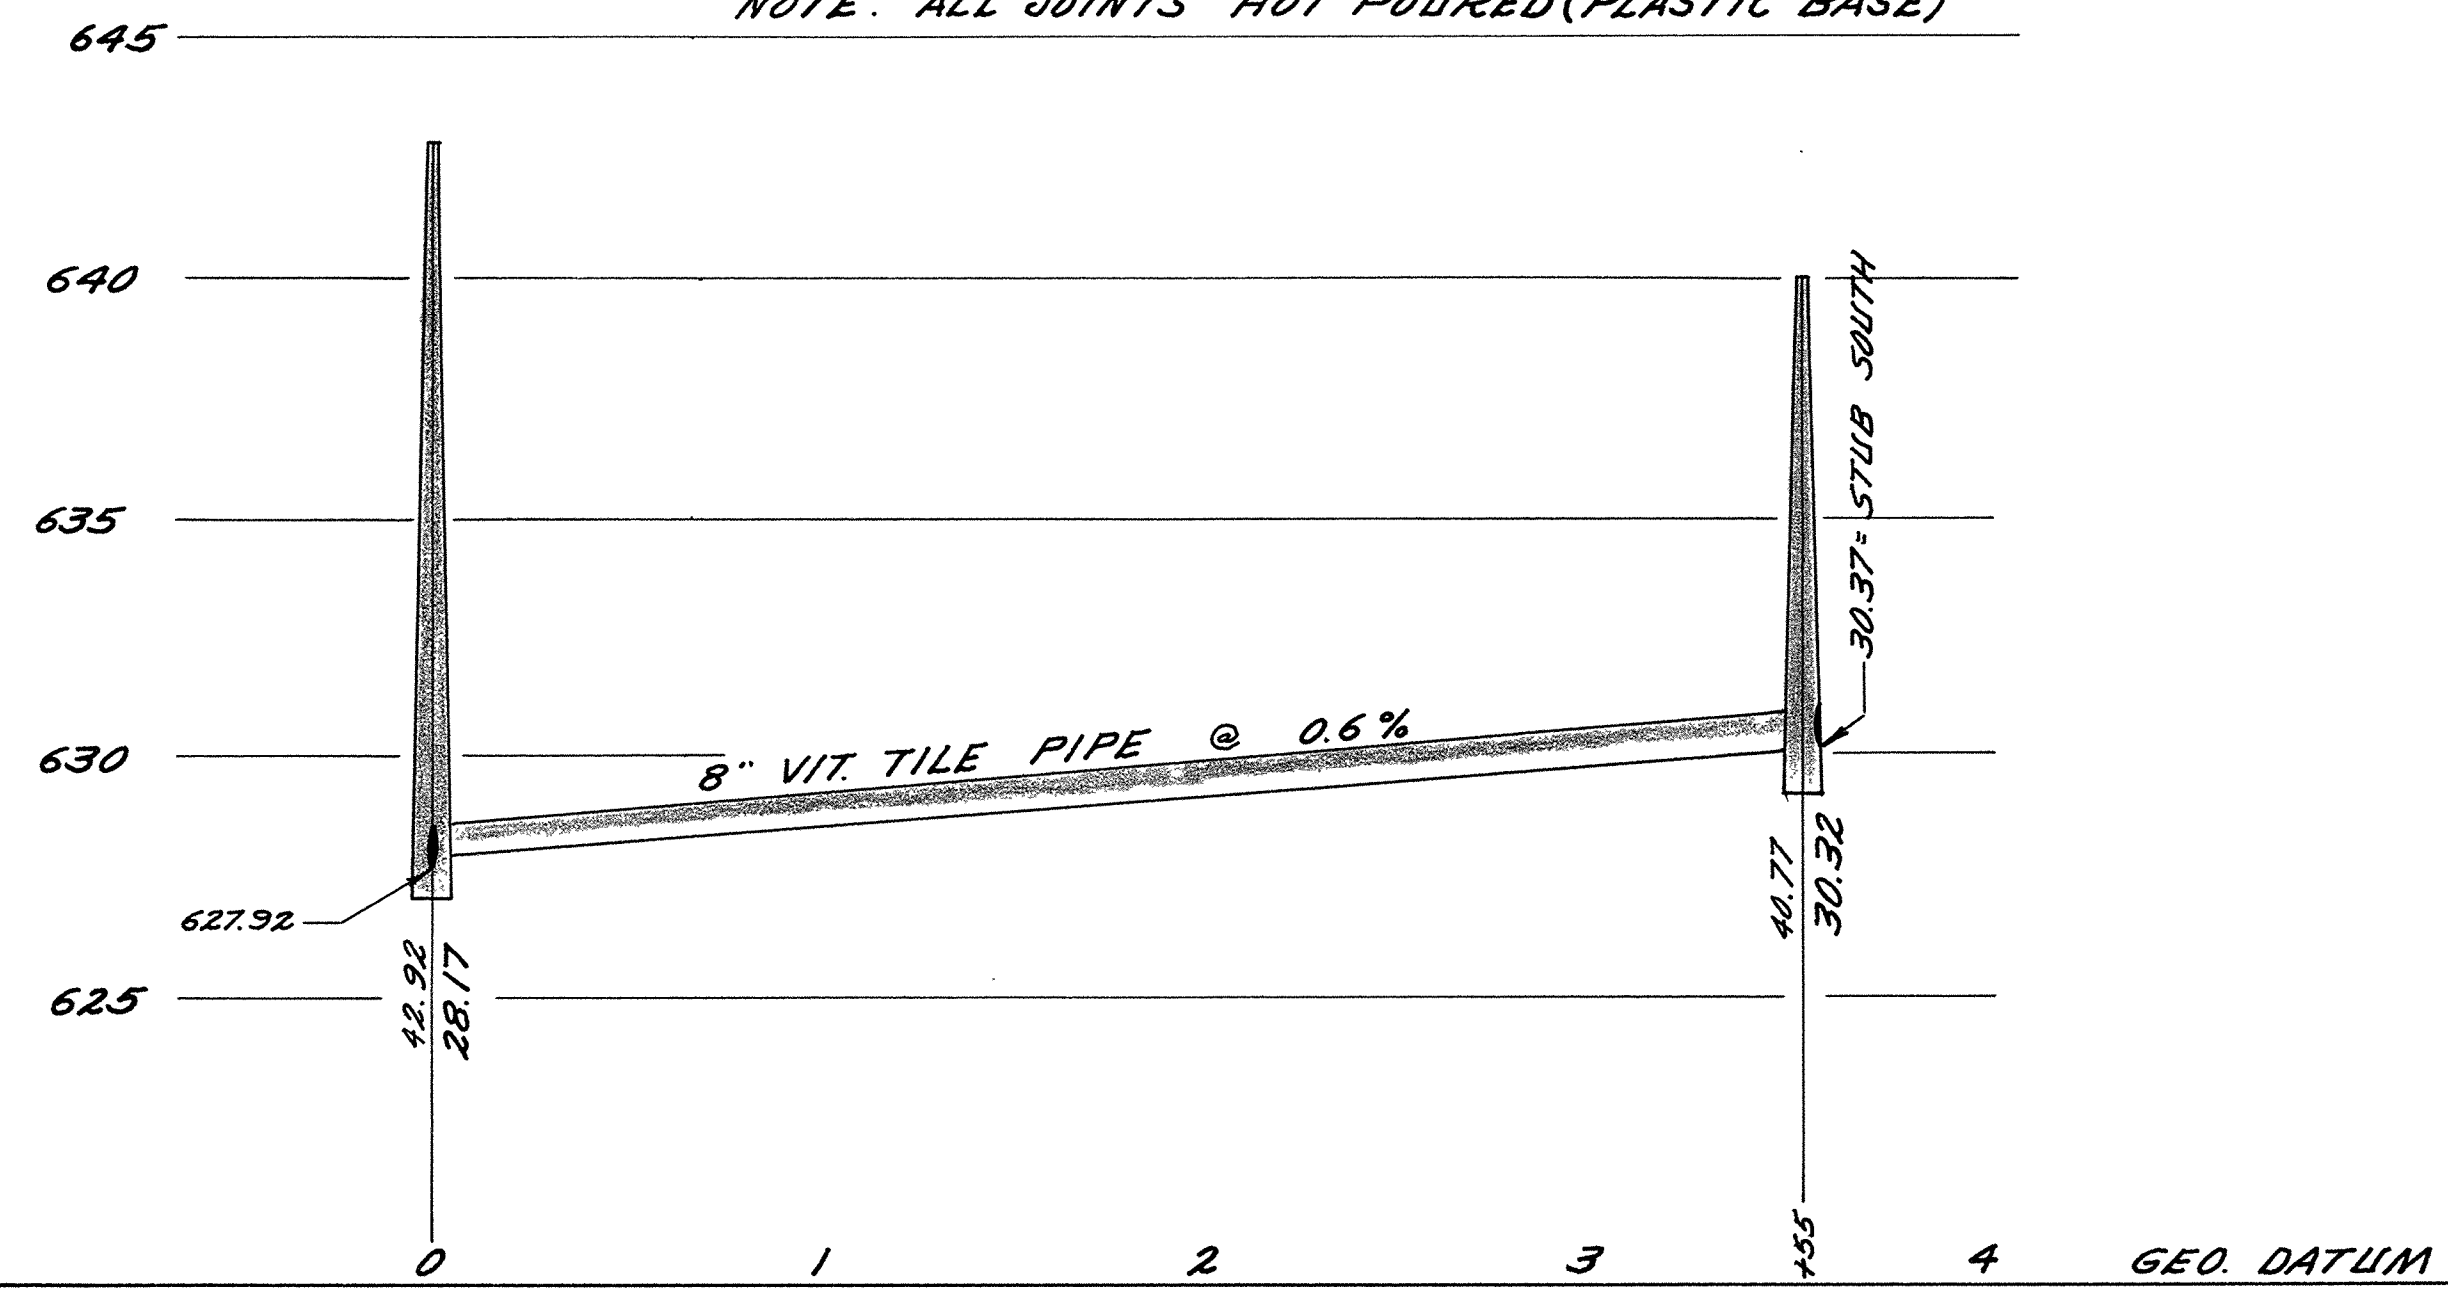

6-4
 L.M.P.

6-4
 WOODSTOCK