
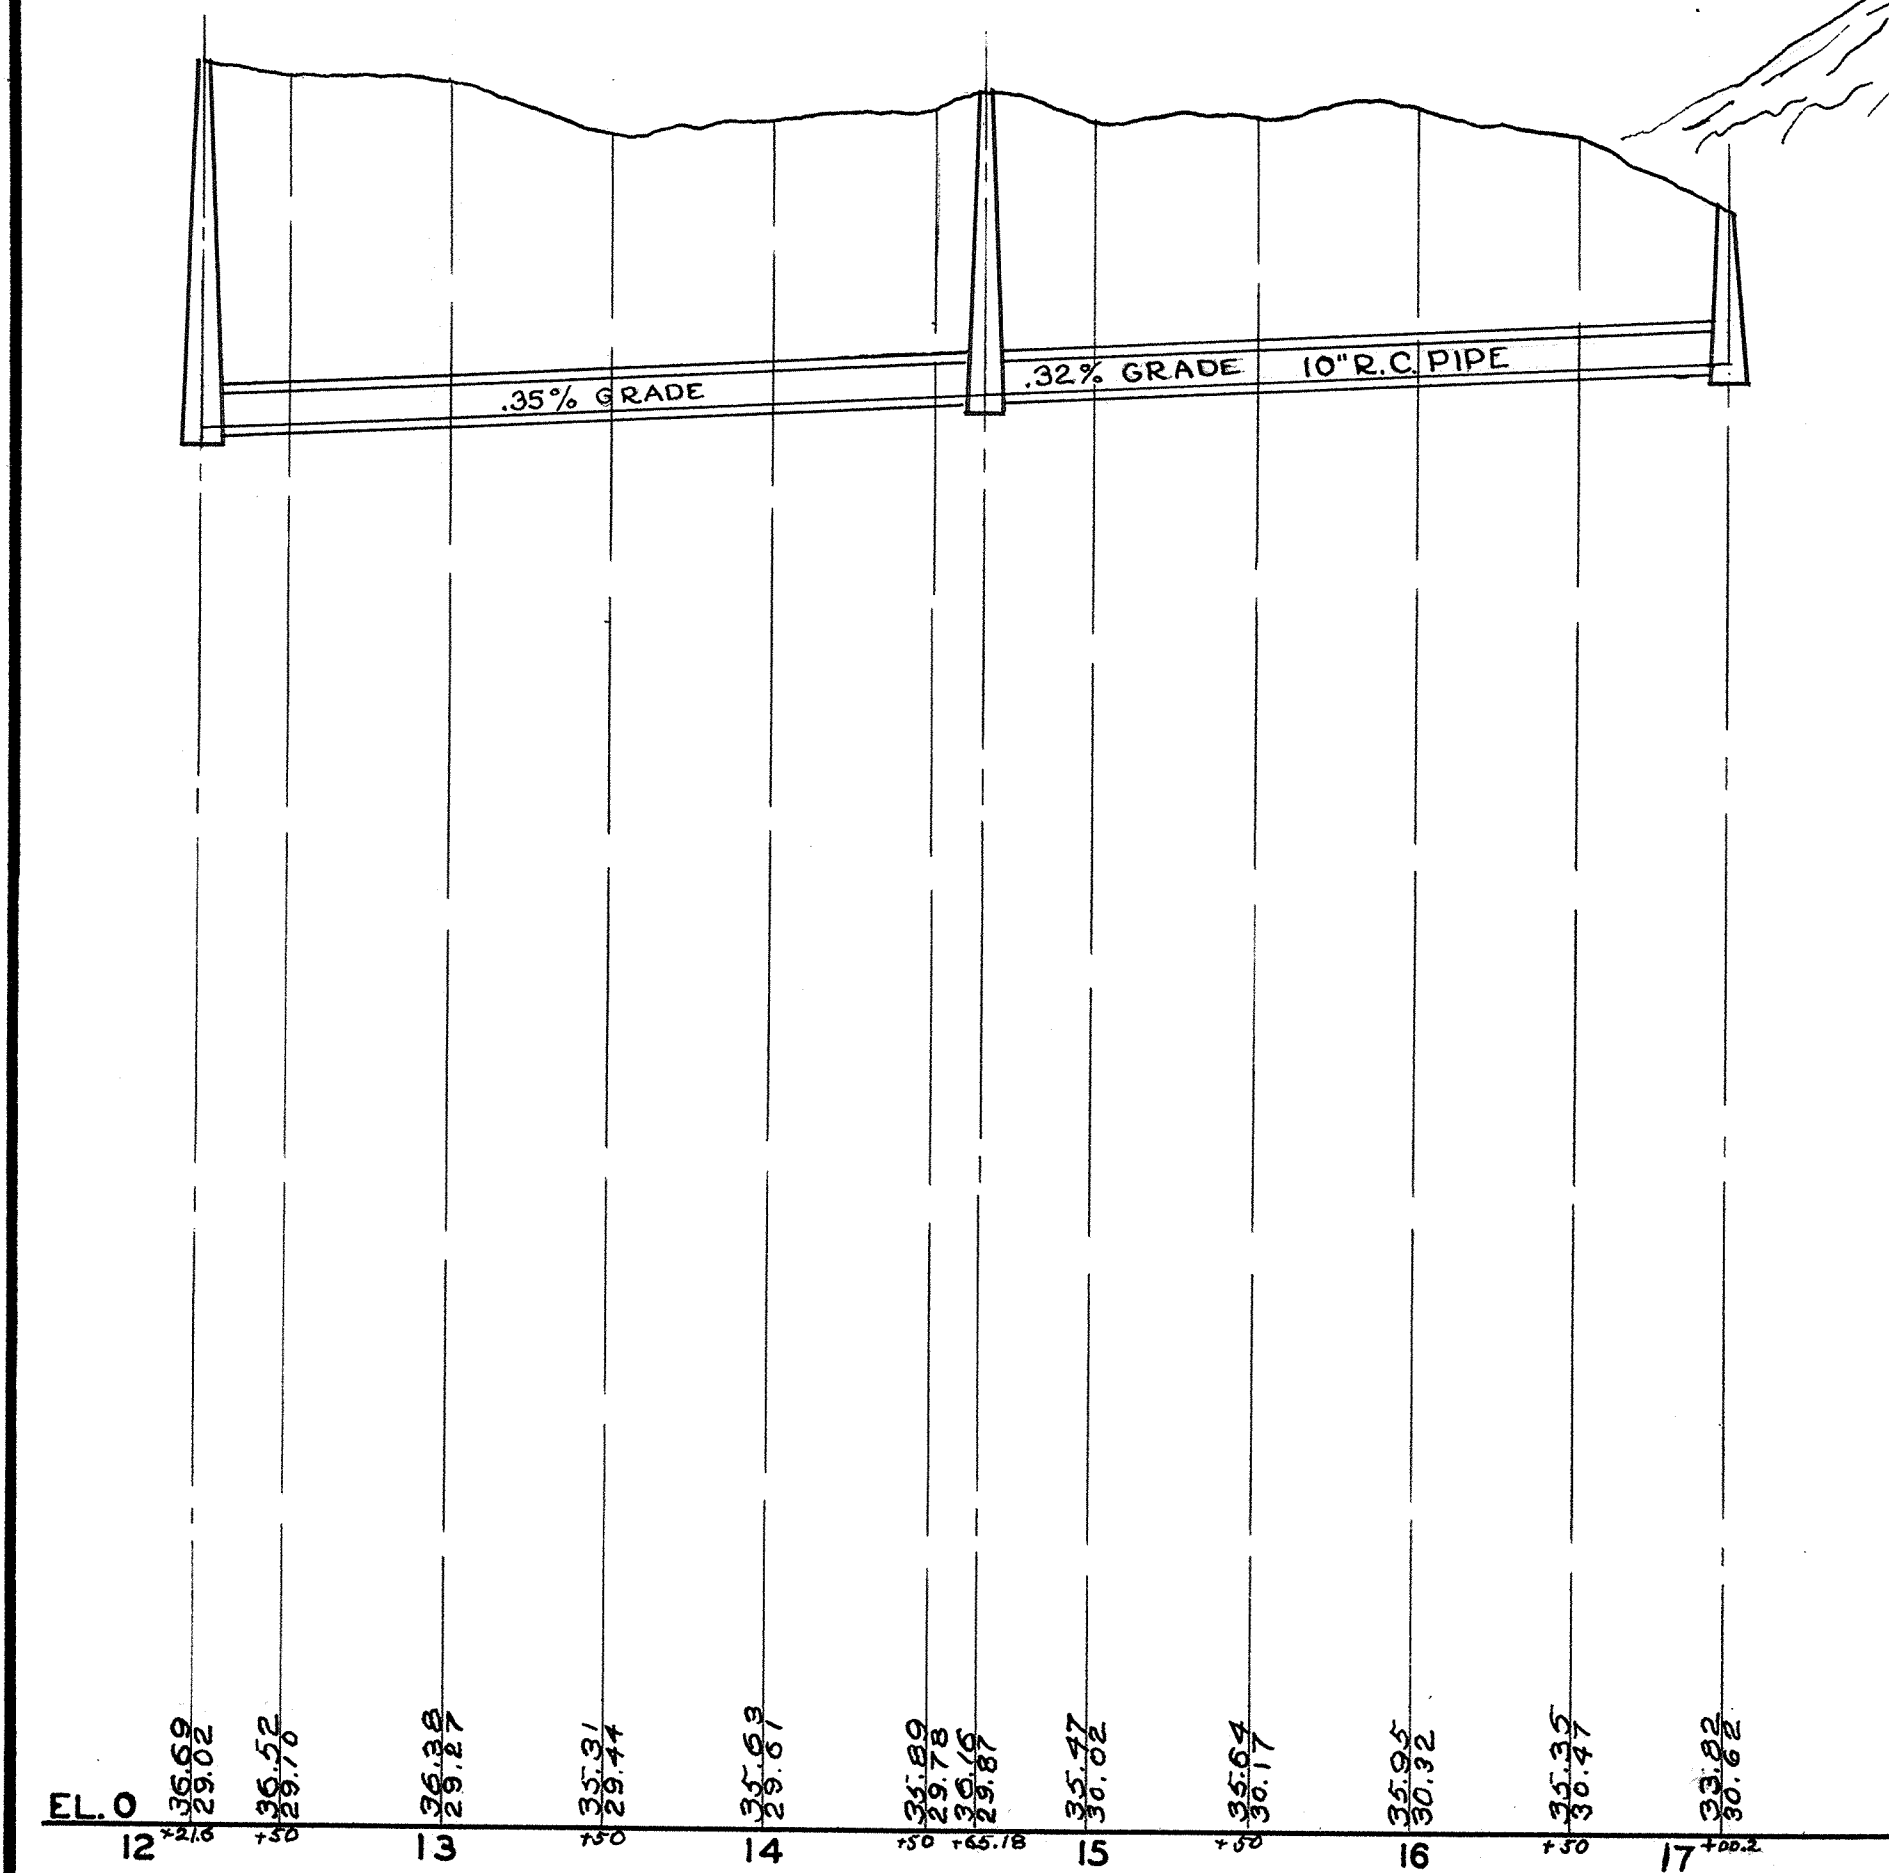


EXTENTION OF 1ST POINT SEWER - BILLINGS PARK

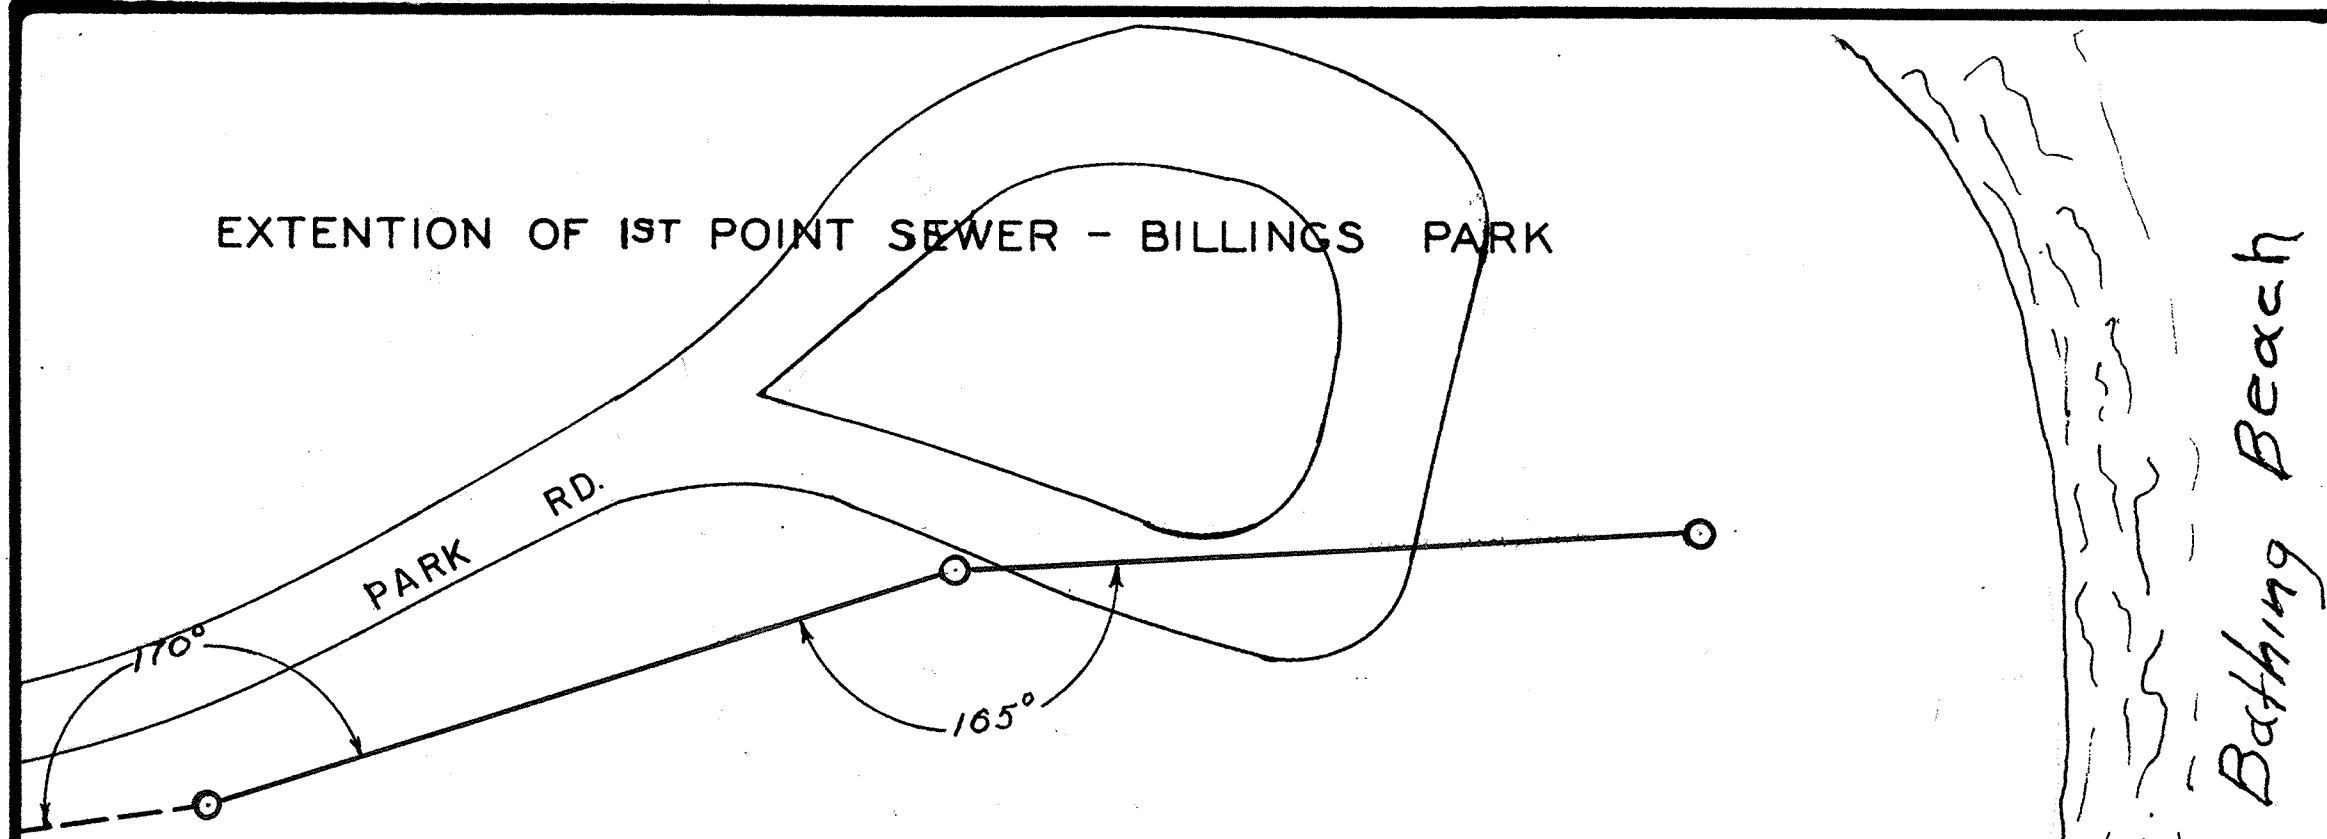

CITY OF SUPERIOR
SEWER PLAN

1" = 60'
1" = 4'

HORIZONTAL SCALE 1" = 60'
VERTICAL SCALE 1" = 4'

JOB STARTED FEBRUARY 1938
JOB COMPLETED MARCH 1938

W.P.A. LABOR
M.SKAMSER INSPECTOR
T.M.BASTERASH CITY ENGINEER

6-41A 6-9

6-41A 9
WOODSTOCK