


ST. LOUIS BAY

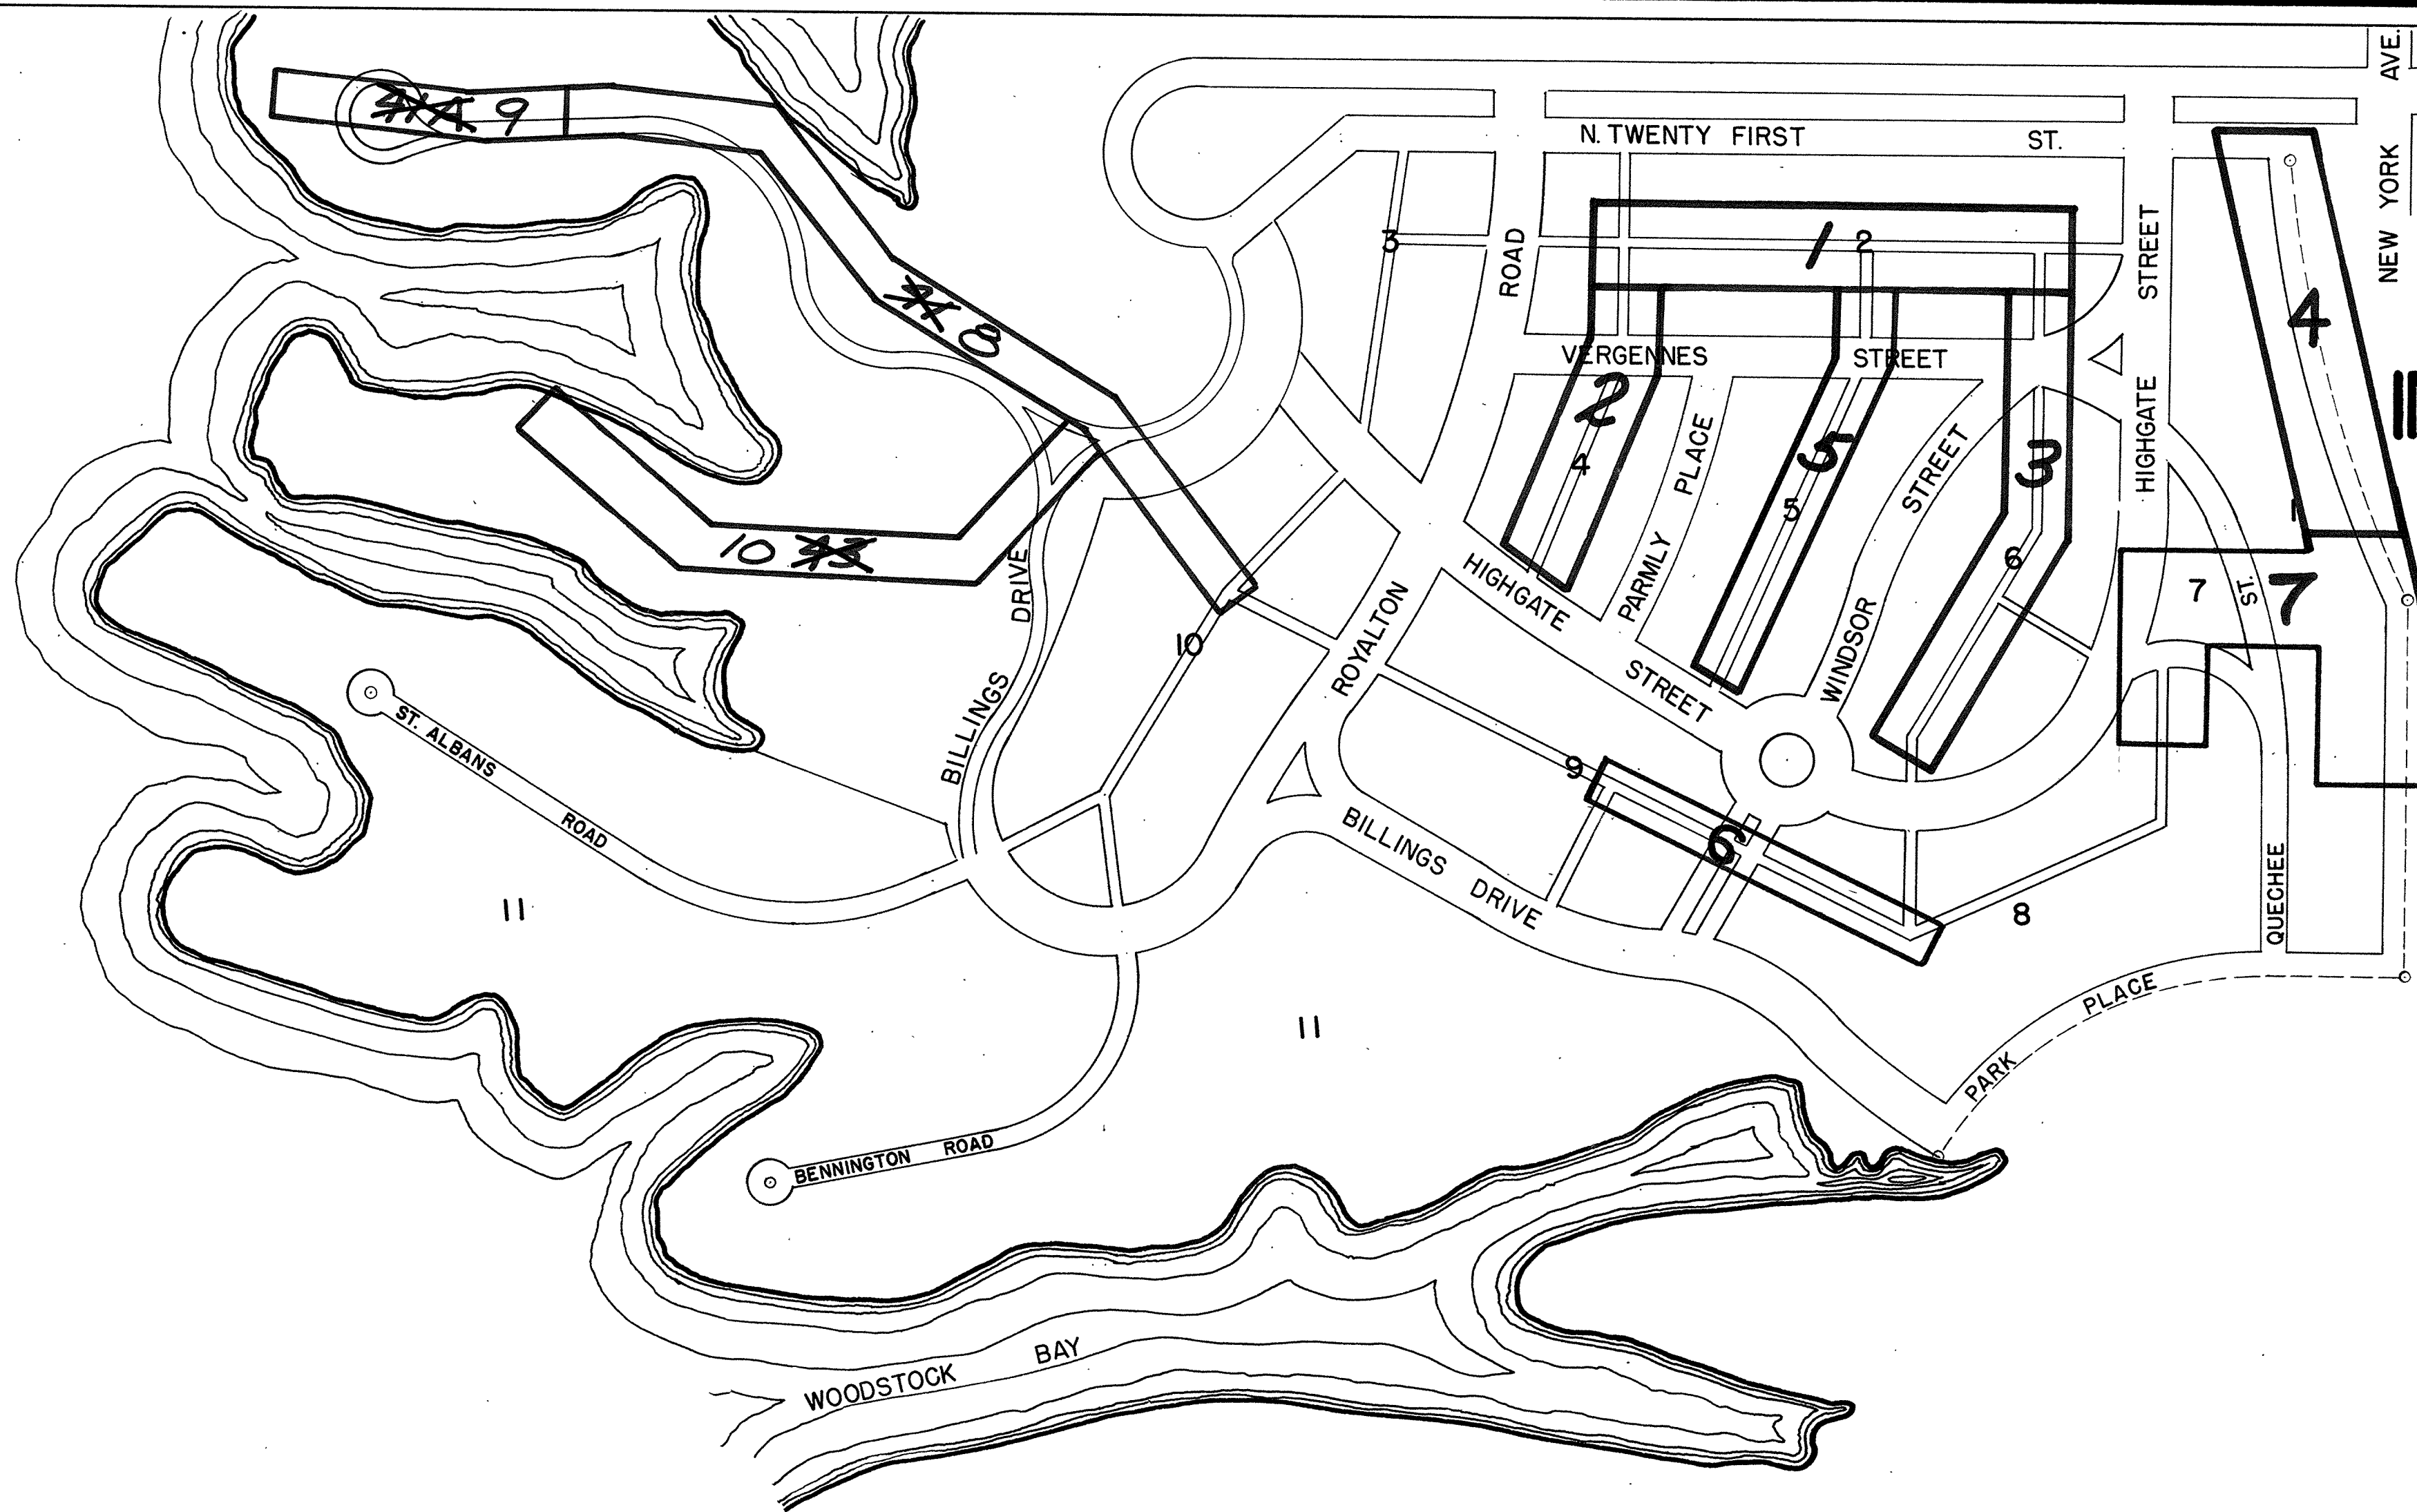

CITY OF SUPERIOR
INDEX TO SEWER PLANS
DIST. NO. 6 WOODSTOCK DIV.

SCALE 1" = 200'

DRAWN - MARCH 1961



L.M.P.