

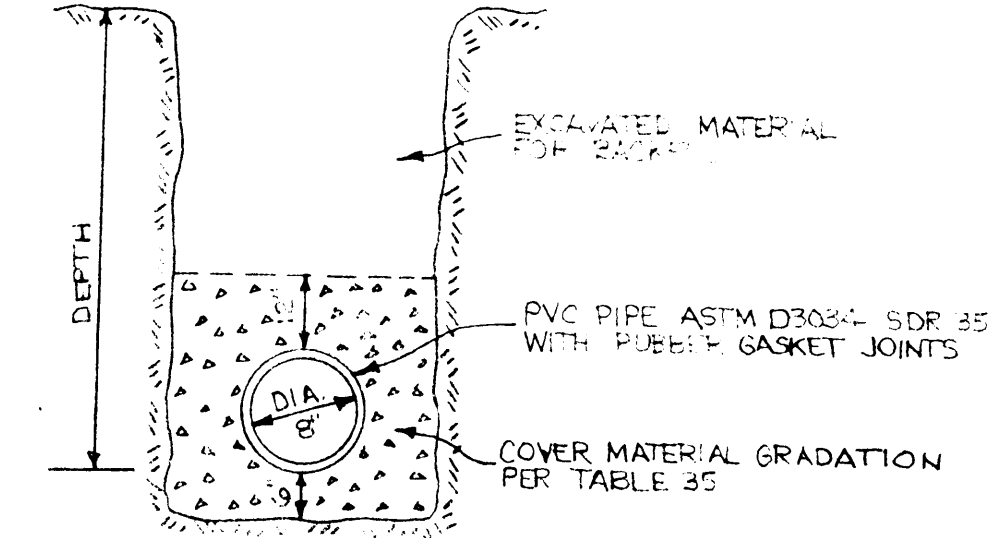
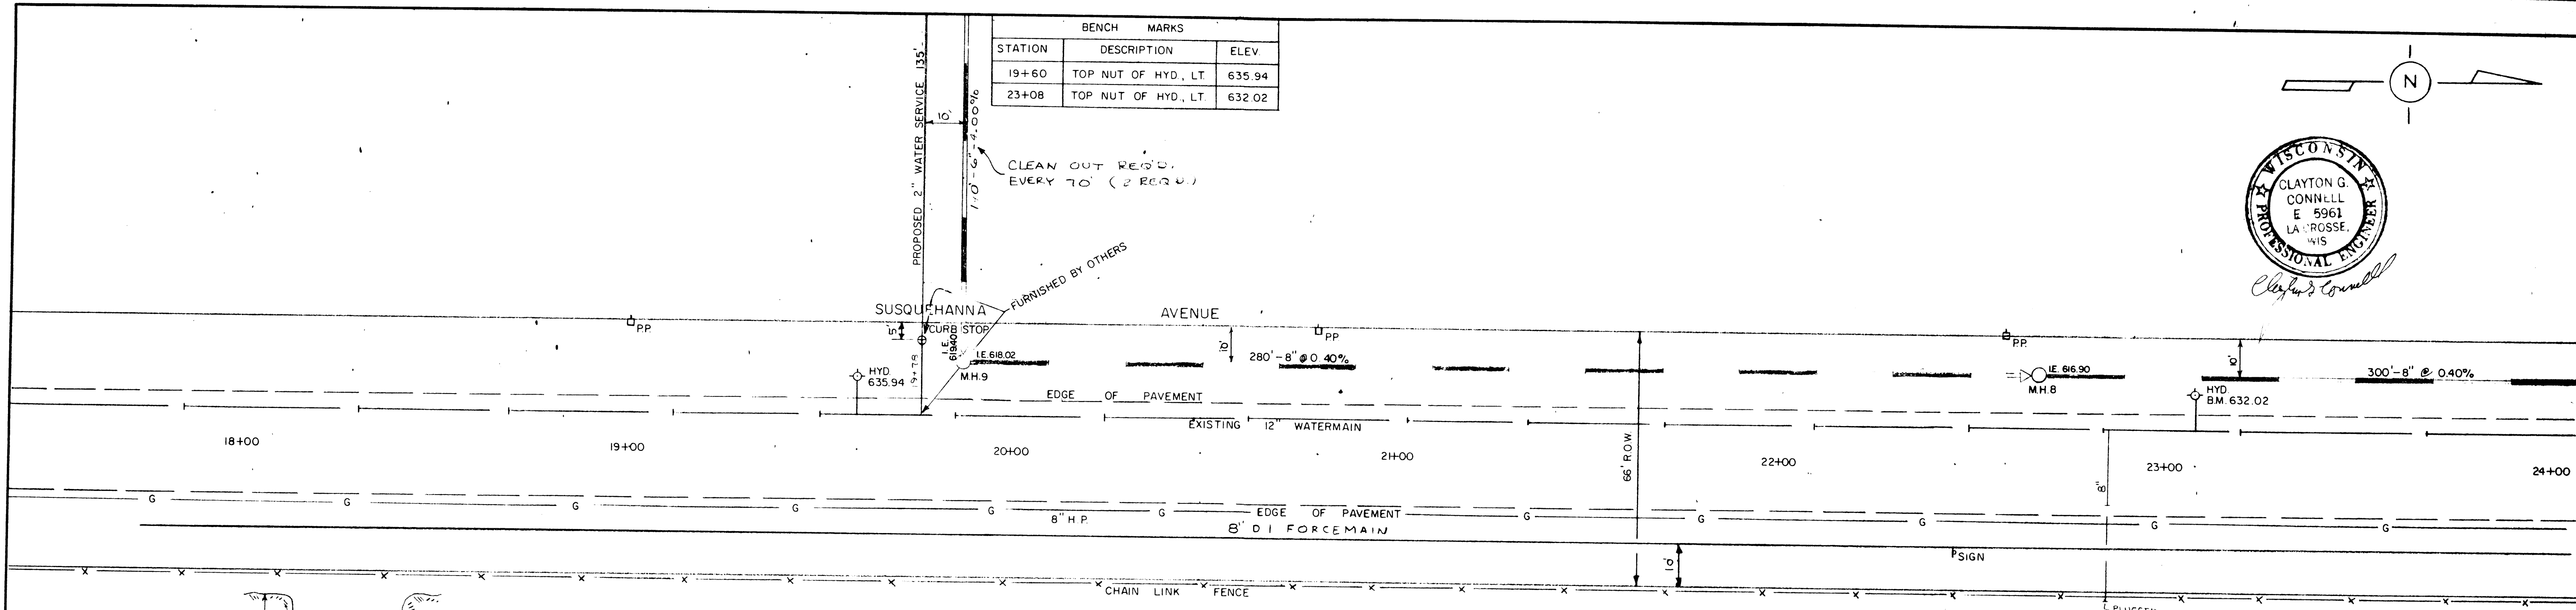
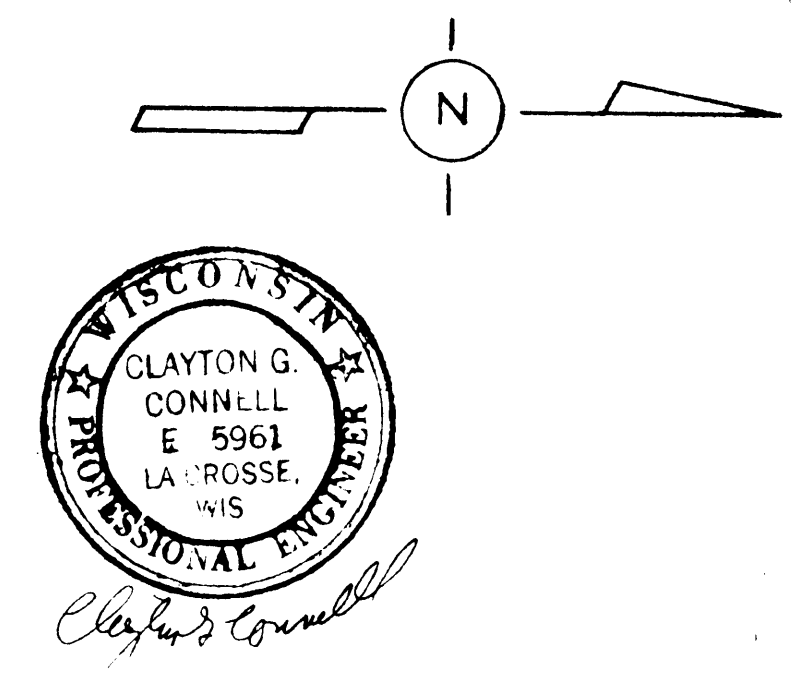


BENCH MARKS		
STATION	DESCRIPTION	ELEV.
19+60	TOP NUT OF HYD. LT.	635.94
23+08	TOP NUT OF HYD. LT.	632.02

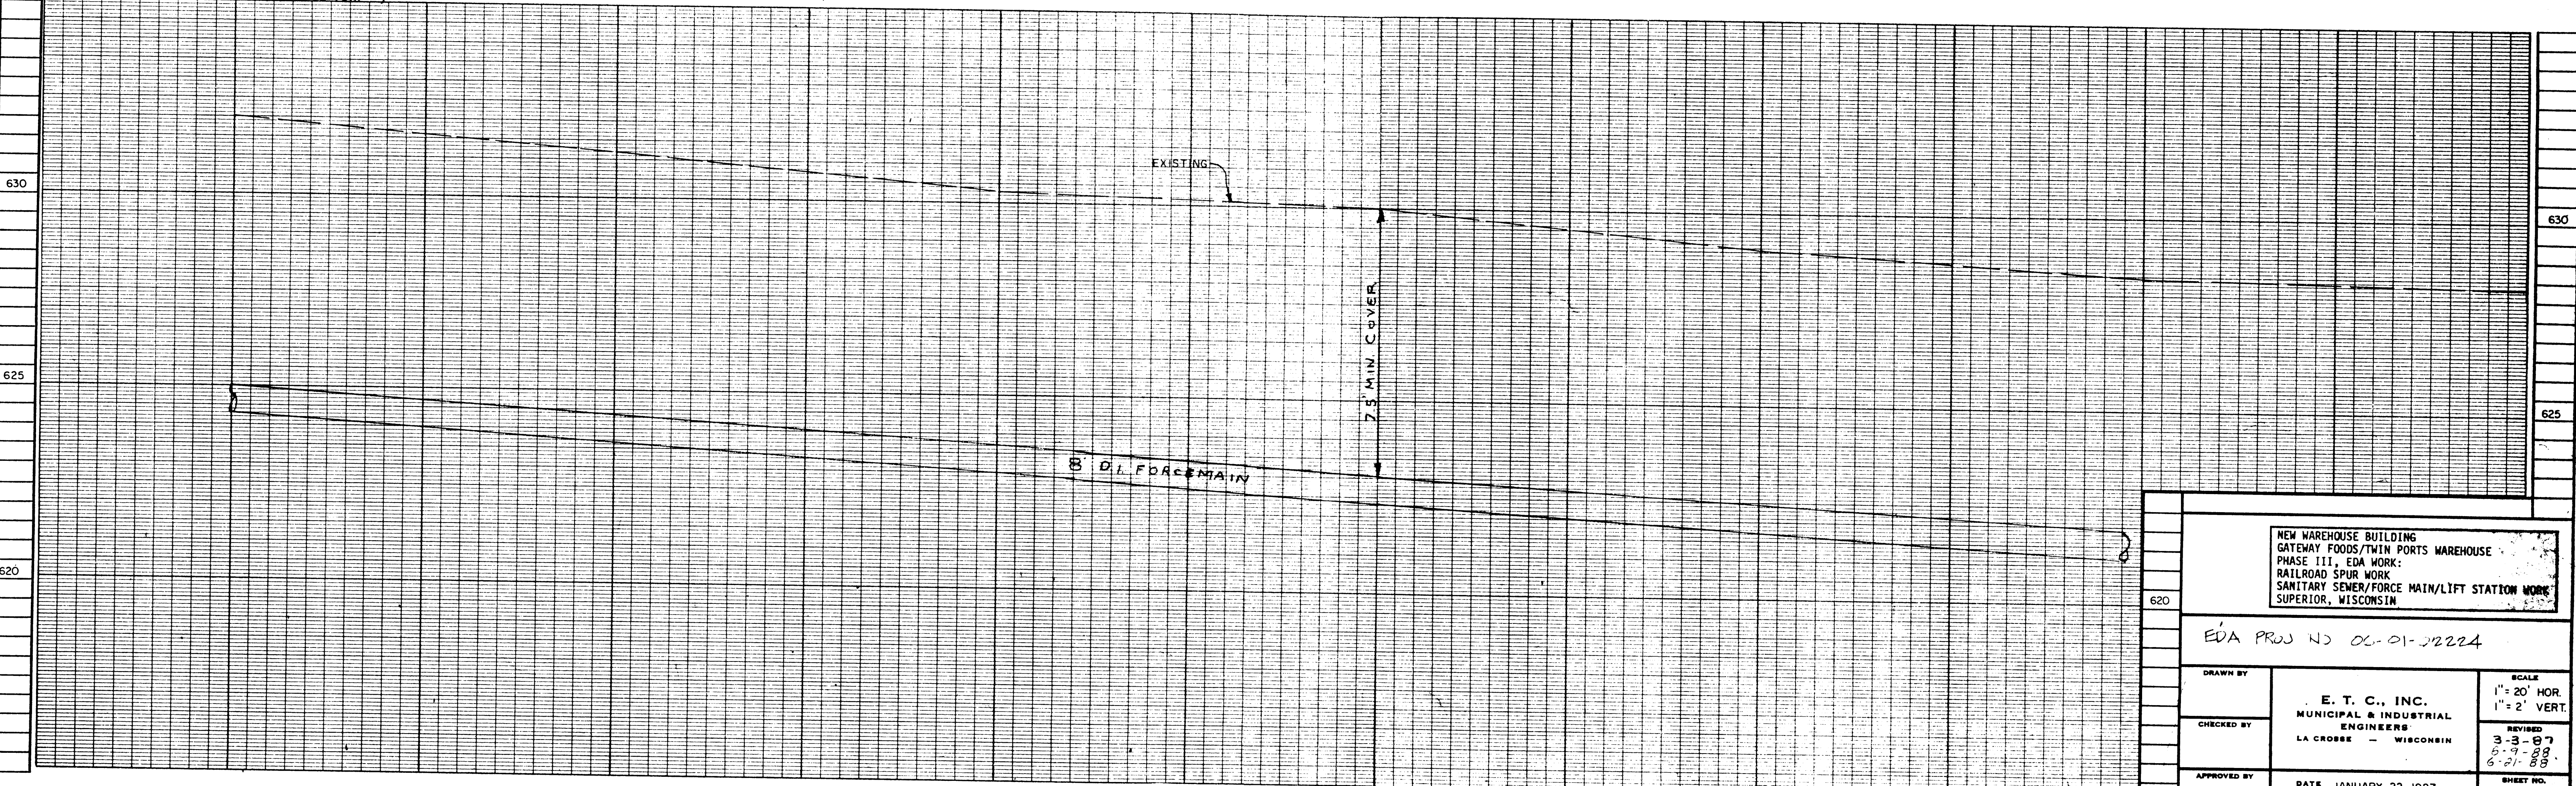

BEDDING DETAIL
SANITARY SEWER
M.H. # 9 TO M.H. # 9

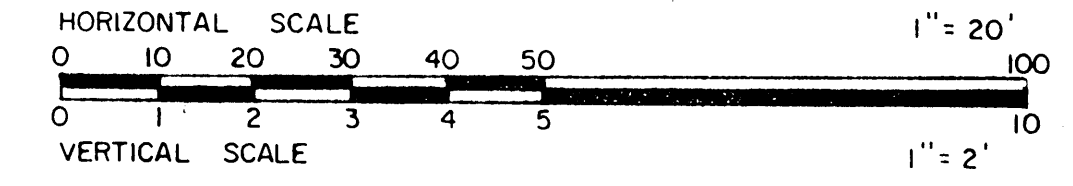

NEW WAREHOUSE BUILDING GATEWAY FOODS/TWIN PORTS WAREHOUSE PHASE III, EDA WORK: RAILROAD SPUR WORK SANITARY SEWER/FORCE MAIN/LIFT STATION WORK SUPERIOR, WISCONSIN		
EDA PROJ NO 00-01-22224		
DRAWN BY CHECKED BY APPROVED BY	E. T. C., INC. MUNICIPAL & INDUSTRIAL ENGINEERS LA CROSSE - WISCONSIN	SCALE 1" = 20' HOR. 1" = 2' VERT. REVISED 3-3-87 5-7-88 6-21-88 SHEET NO. CE 5 OF 8
DATE JANUARY 22, 1987		JOB NO. E-162 BK 52 PG. 1-10