



LA POINT AVE.  
35TH AVE. E.

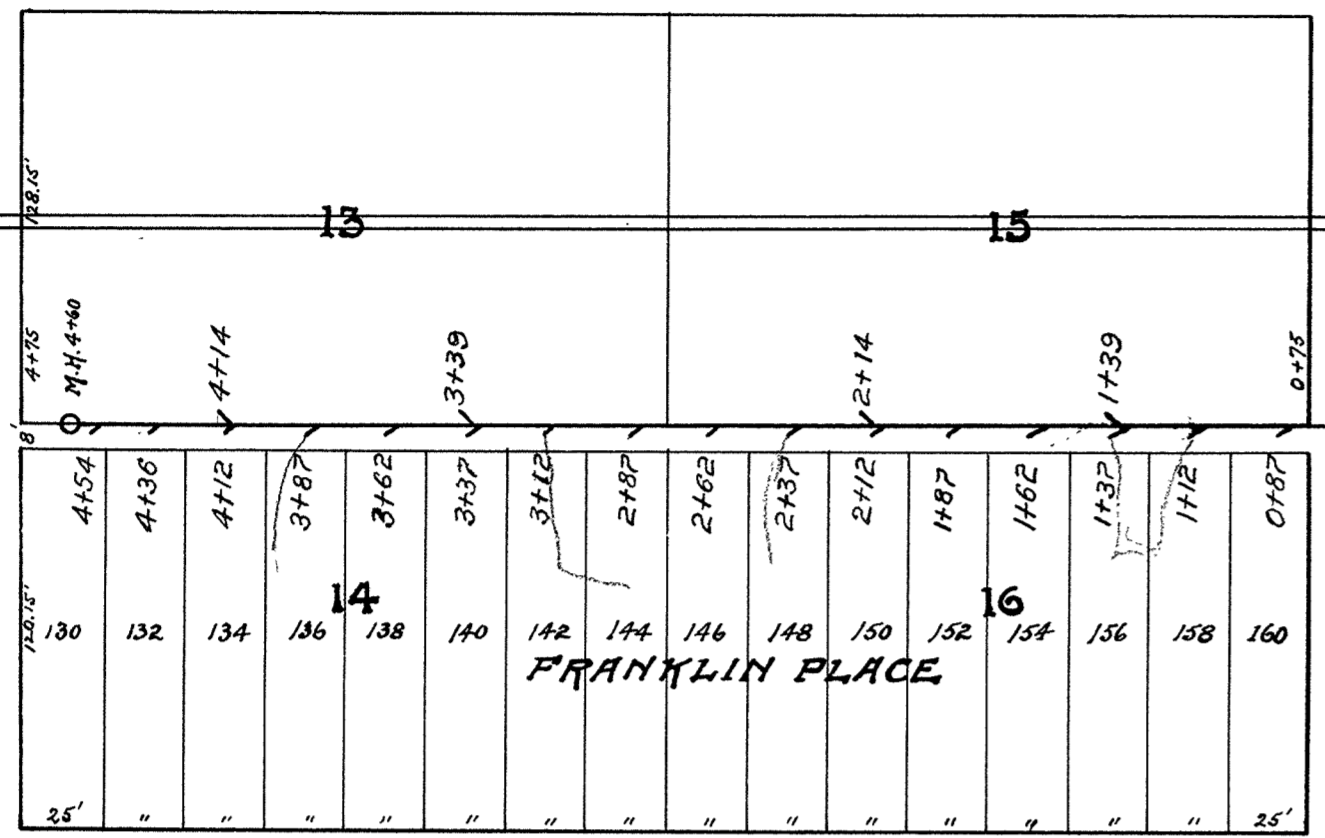

36TH AVE. EAST  
MISSISSIPPI

E. FIRST

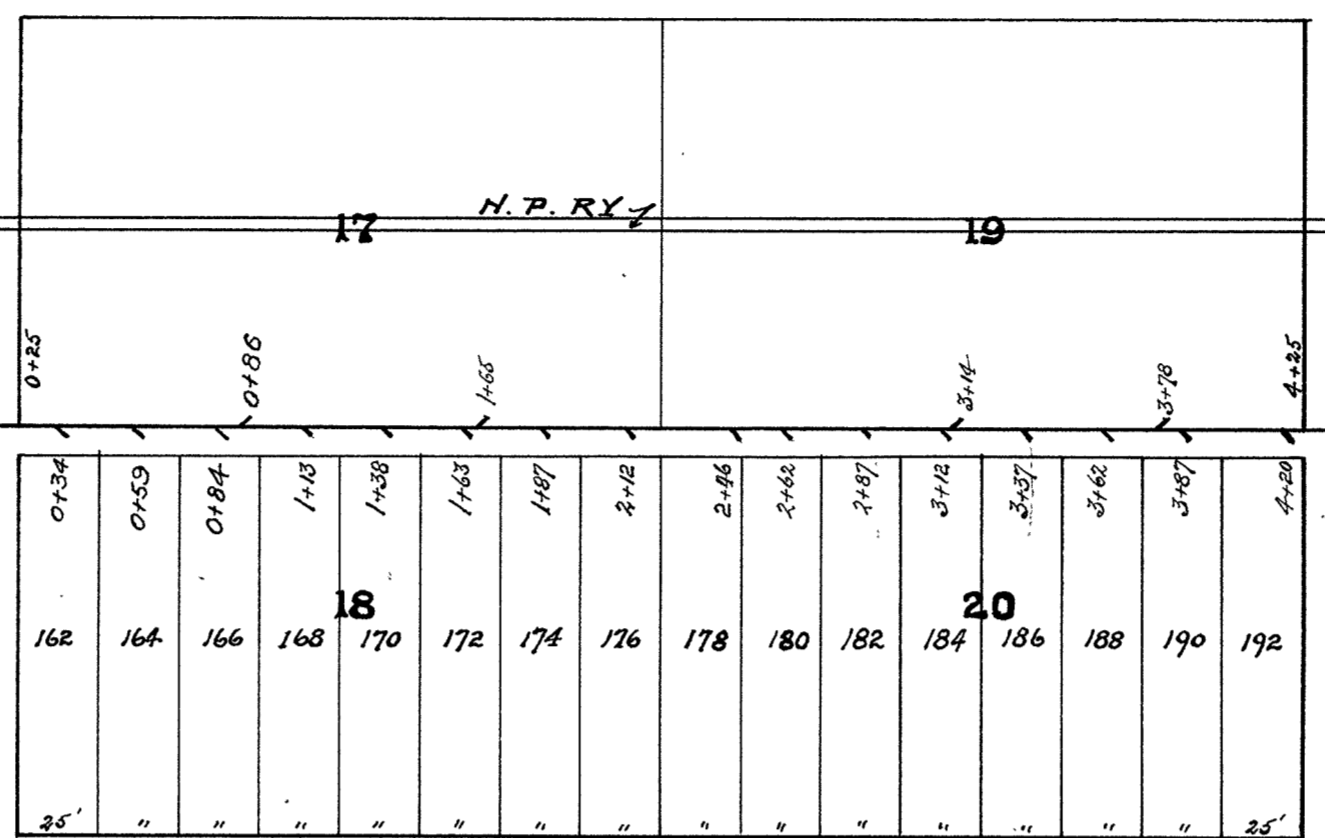

37TH AVE. EAST  
CLARK

ST.

ST.

RAILROAD AVE.

38TH AVE. EAST  
M<sup>rs</sup> BAIN AVE.

Horizontal Scale: 1 in. = 60 ft.  
 Vertical Scale: 1 in. = 4 ft.  
 CONTRACT N<sup>o</sup> 1422  
 Contract let July 1<sup>st</sup> 1914  
 Contract completed Nov. 2<sup>nd</sup> 1914.  
 M. Jacobson & Co. Contractors  
 W. D. Belknap Inspector  
 E. B. Banks City Engineer.

