
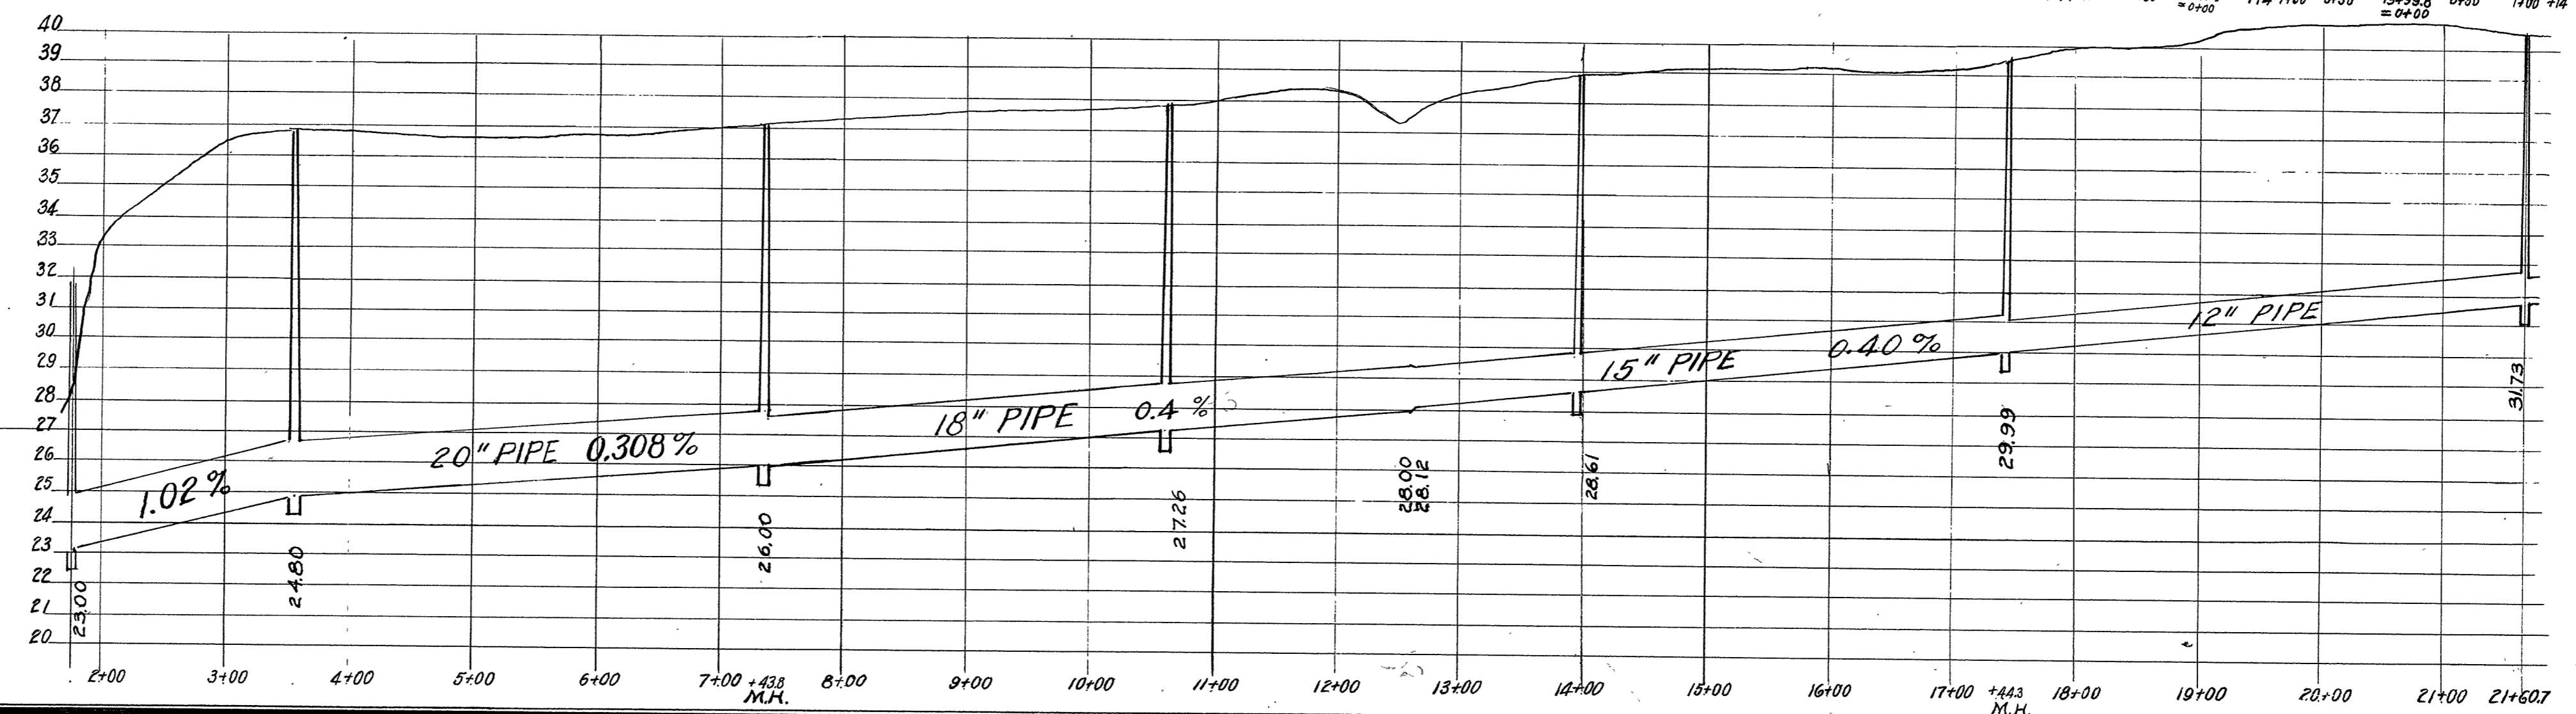
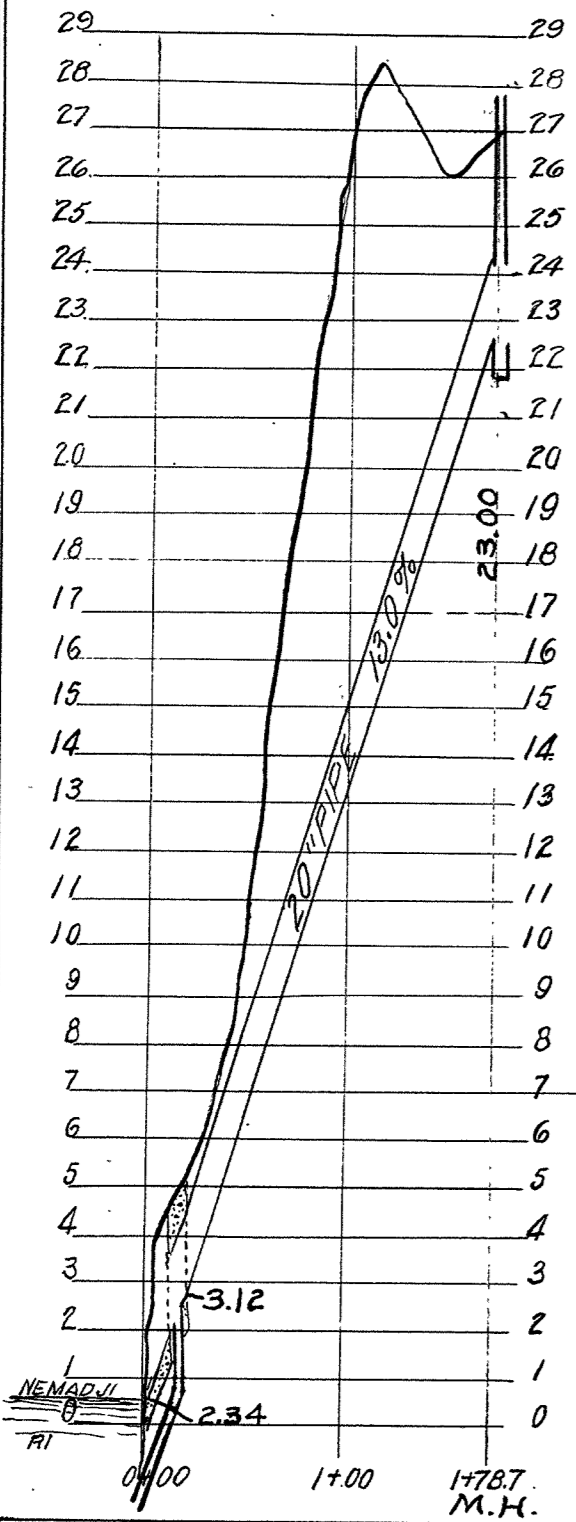


CITY OF SUPERIOR SEWER PLAN

CONTRACT NUMBER 1616
 " LET OCT. 25, 1919
 " COMPLETED FEB. 16, 1920
 MAGNUS PETERSON CONTRACTOR
 E. M. STEFFENSON INSPECTOR
 E. B. BANKS CITY ENGINEER

SCALE { 1" = 100' HORIZONTAL
 1" = 4' VERTICAL

LATERAL SEWERS
 IN ALLEY BET. McBAIN & CASS.
 IN ALLEY BET. CASS & RIGGS.

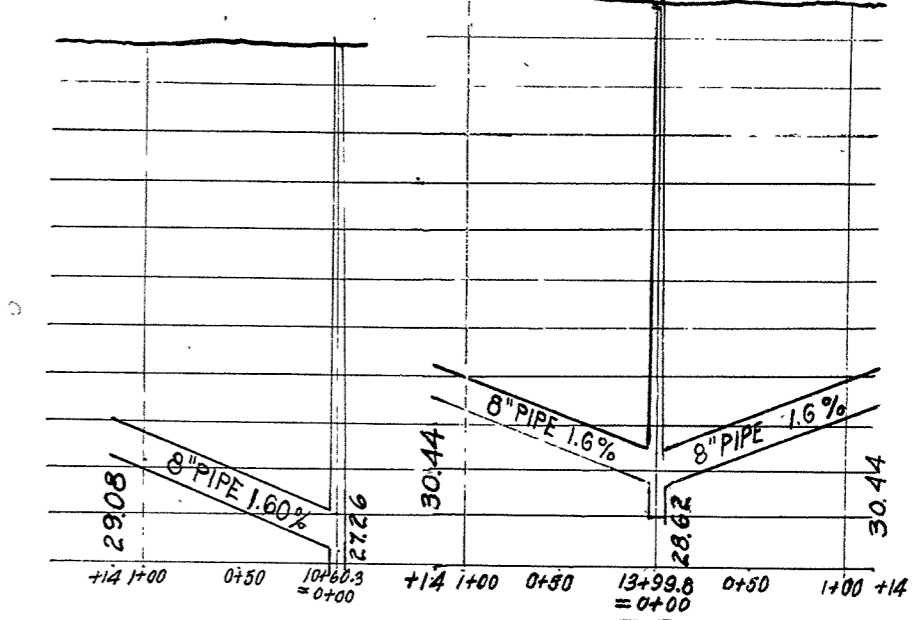

7-17