
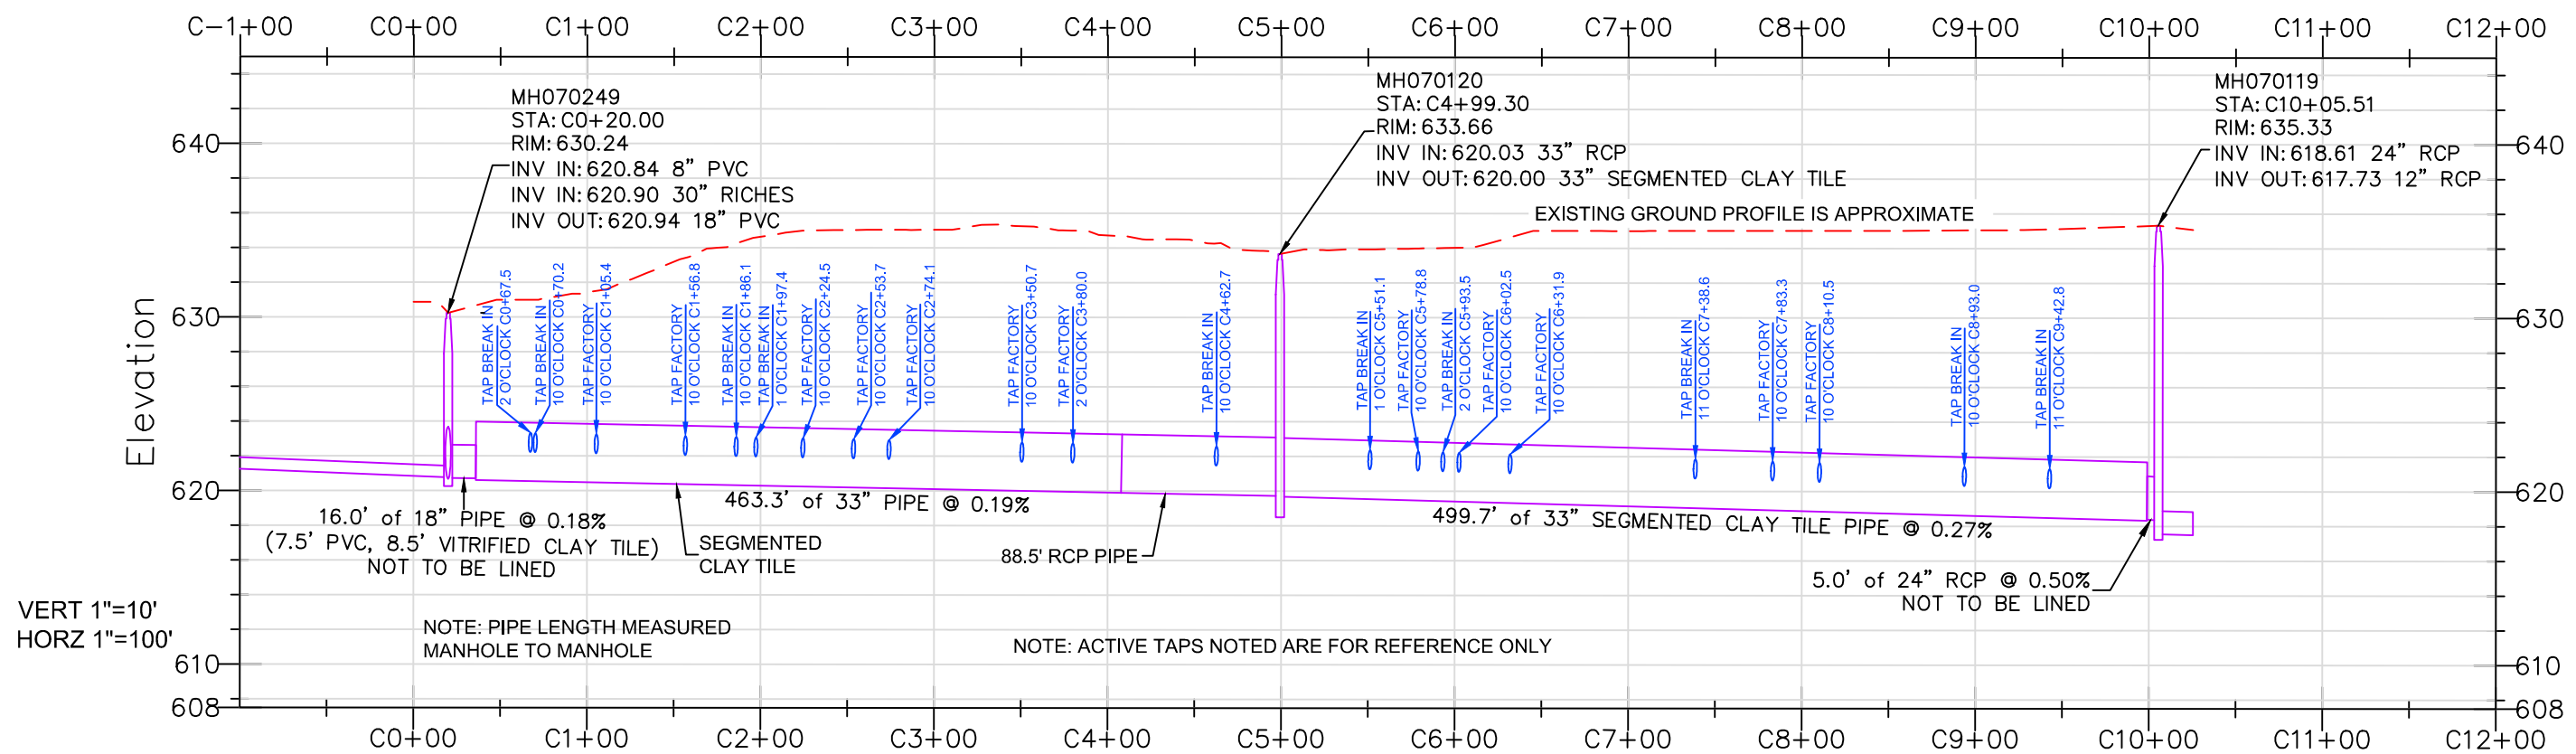


NOTE: CONTRACTOR TO VERIFY AND IDENTIFY ANY ACTIVE TAP CONNECTIONS PRIOR TO CIPP LINING

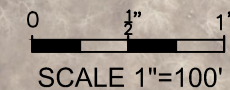

VERT 1"=10'  
HORZ 1"=100'

NOTE: PIPE LENGTH MEASURED MANHOLE TO MANHOLE

NOTE: ACTIVE TAPS NOTED ARE FOR REFERENCE ONLY

