

PREEM CONSULTING ENGINEERS
 1000 W. UNIVERSITY AVENUE
 SUITE 100
 DENVER, CO 80202
 TEL: 303.733.8800
 FAX: 303.733.8801
 WWW.PREEM-ENGINEERS.COM

Checked By: JAC
 Drawn By: JAC

1
 N/C


REVIEW TO RECORD DRAWING
 REVISION

2/26/94
 DATE

Sheet No. 7 of 11 Sheets

RECORD DRAWING


Profile

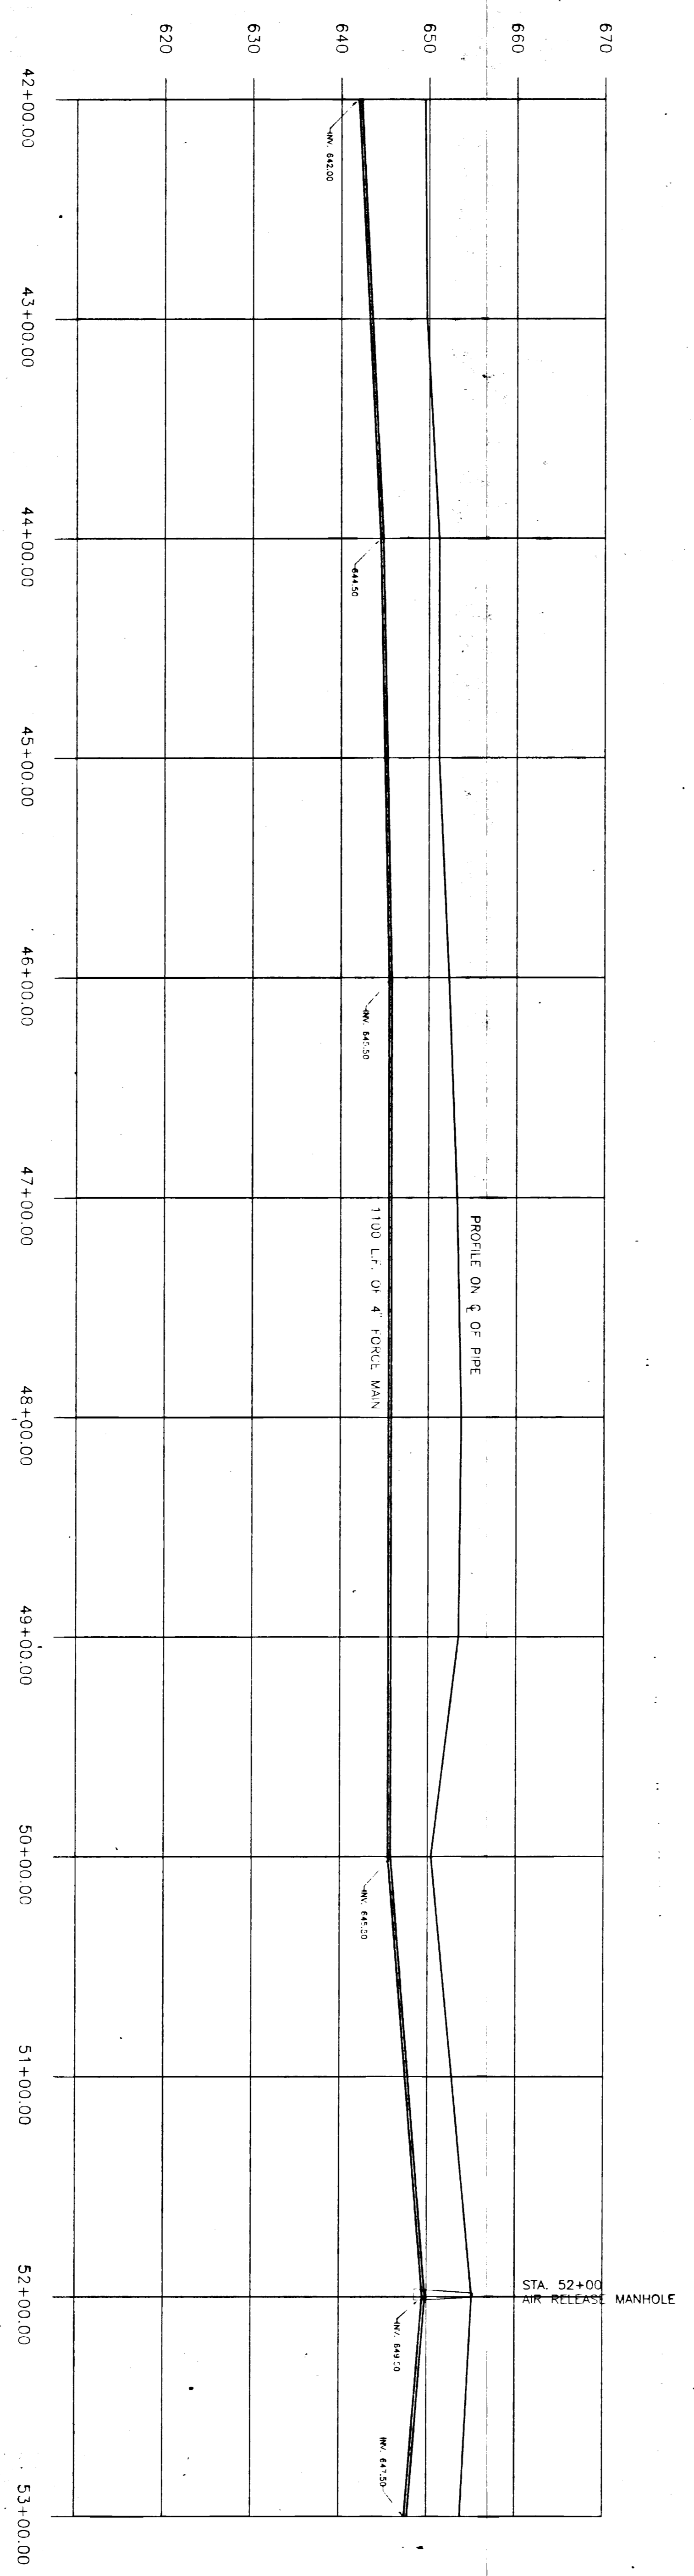

MATCH LINE STA. 42+00
 SEE SHEET 6

MOCCASIN MIKE RD.

MATCH LINE STA. 53+00
 SEE SHEET 8

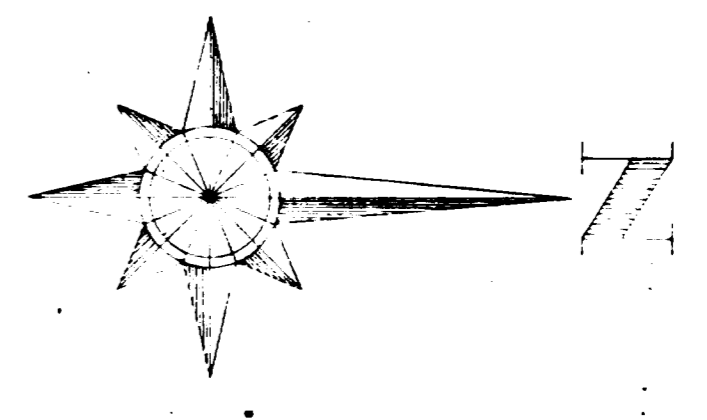

GRAPHIC SCALE
 0 20 40 80
 FEET

