


PREEM, INC. CONSULTING ENGINEERS
 1000 W. UNIVERSITY AVENUE
 SUITE 100
 DENVER, COLORADO 80202
 PHONE: (303) 733-1111
 FAX: (303) 733-1112
 WWW: WWW.PREEM-INC.COM

DESIGNED BY: E.F. COOPER
 CHECKED BY: J.P. COOPER
 DATE: 2/26/94


NO. 1
 REVISION TO RECORD DRAWING
 REVISION DATE

RECORD DRAWING
 Sheet No. 8 of 11 Sheets

Profile

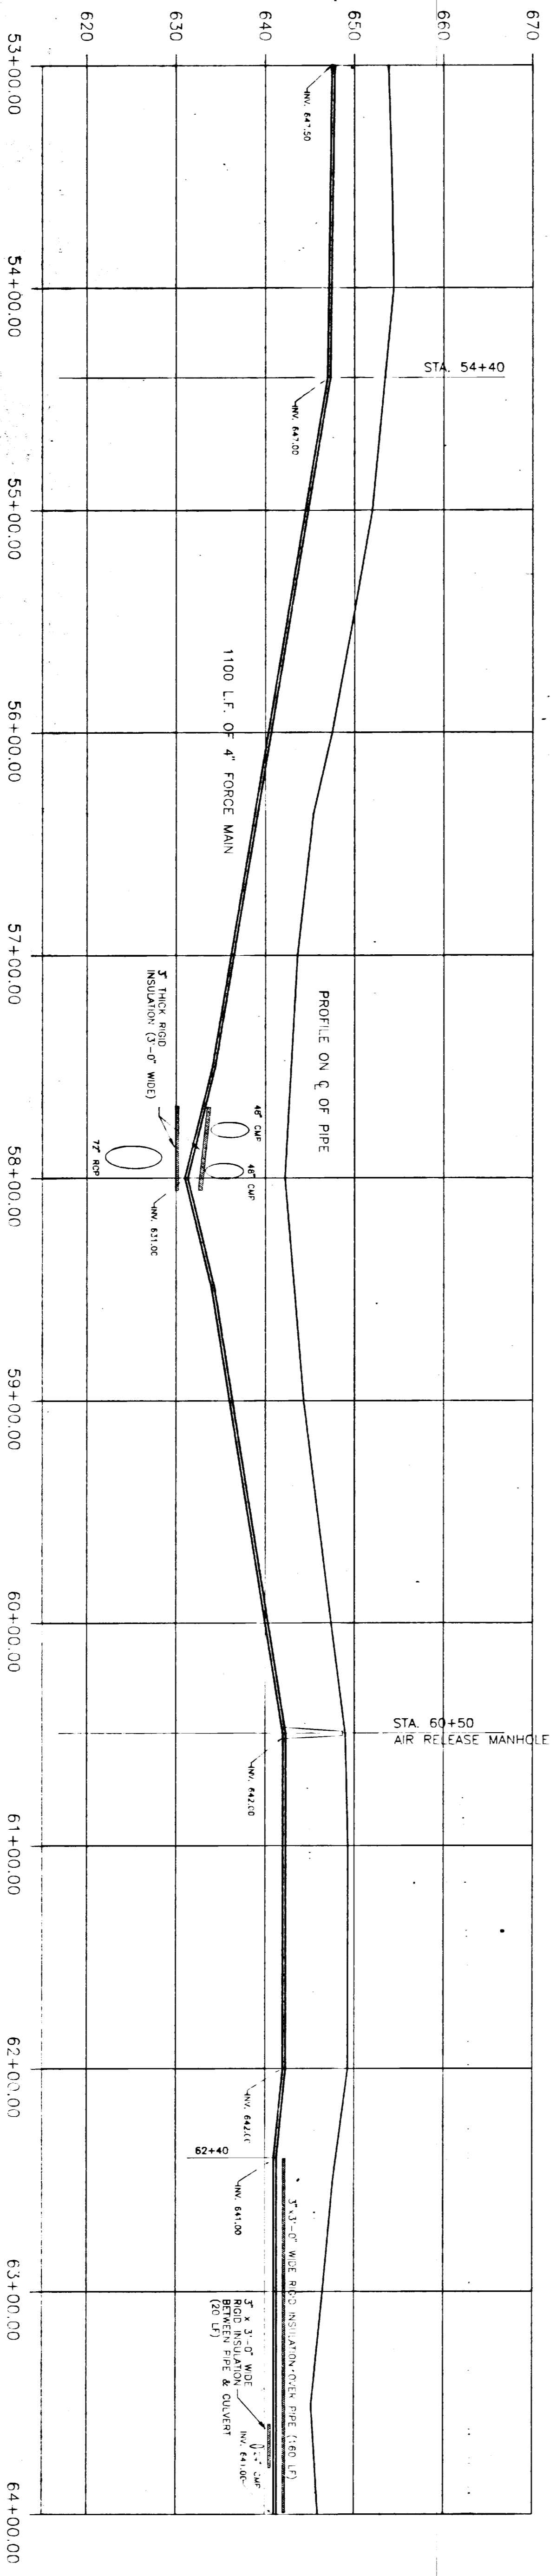

MATCH LINE STA. 53+00
 SEE SHEET 7

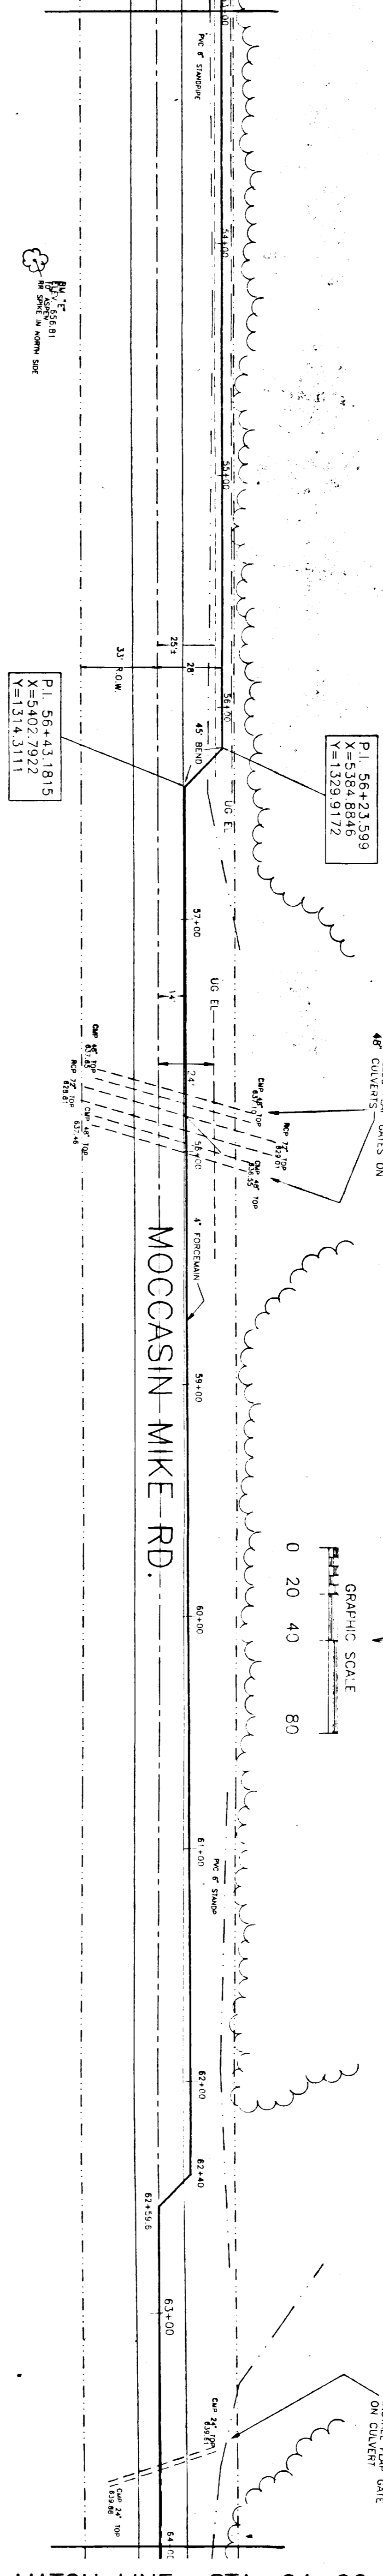

MATCH LINE STA. 64+00
 SEE SHEET 9

