


BENCHMARKS			
No.	STATION	DESCRIPTION	ELEV.
1		SW CORN. CONC. SLAB OF BAY 5 AT CARWASH 32ND & TOWER	657.61
TP3	608+40, 50'LT.	LAG BOLT IN POWER POLE	658.95
TP4		TOP CURB S. ENT. TO HOSPITAL	662.95

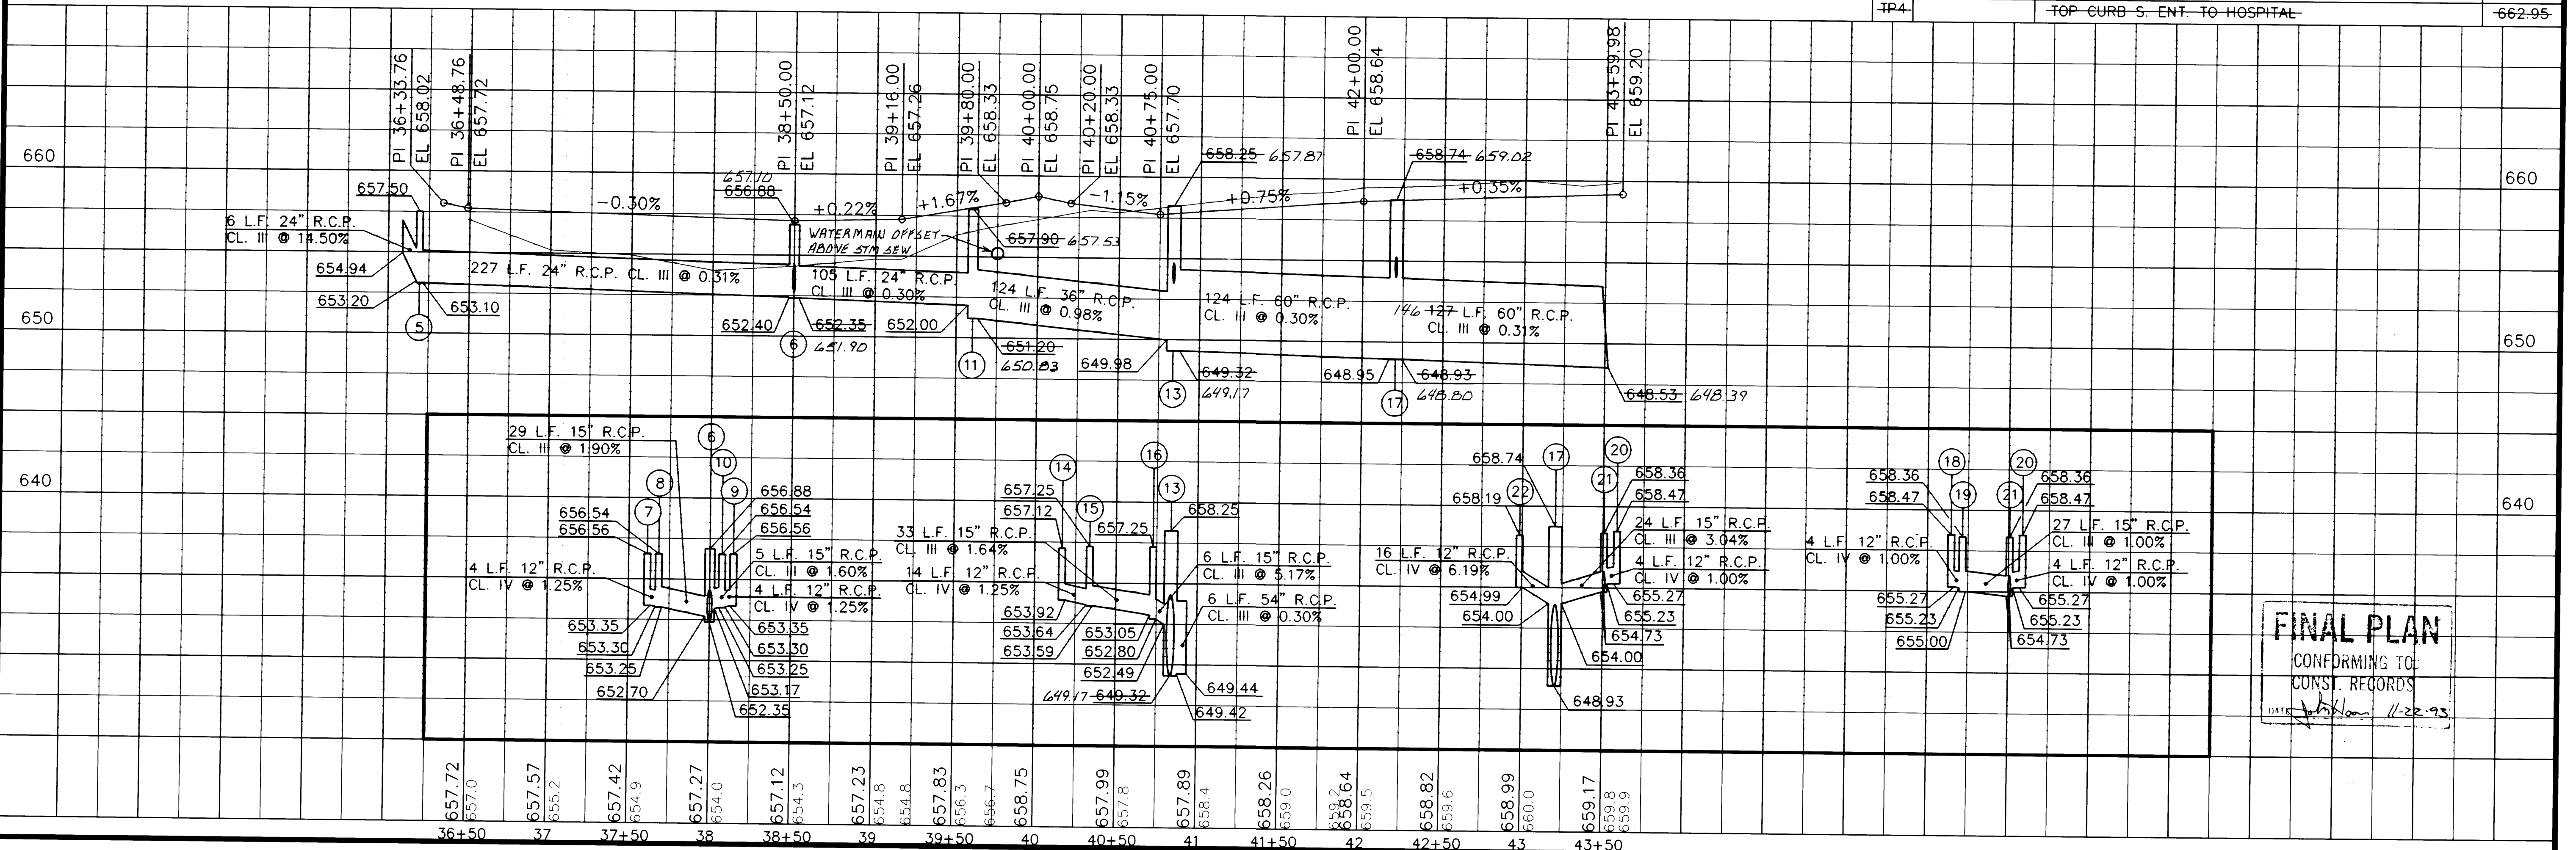

**FINAL PLAN**  
 CONFIRMING TO  
 CONST. RECORDS  
 11-22-93