

R.R. CULVERT 2500' N. 59.6

FOUND 1 1/2" PIPE UP 2'

S-89°-49'-30" E

N 1/4 COR.
















385.4'

1236.1' WATER 40th STREET

755.0'

45.2' 80.1'

1316.2'

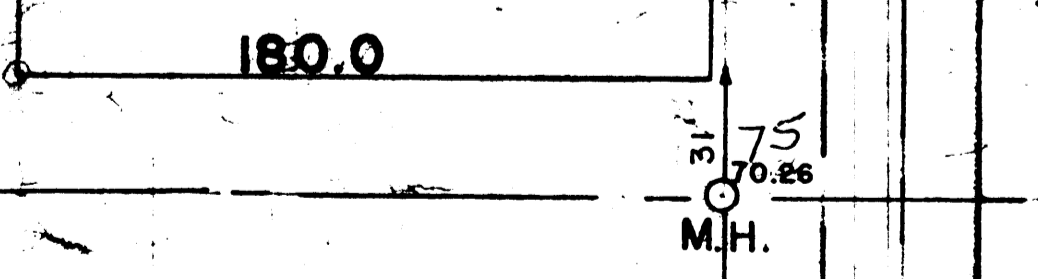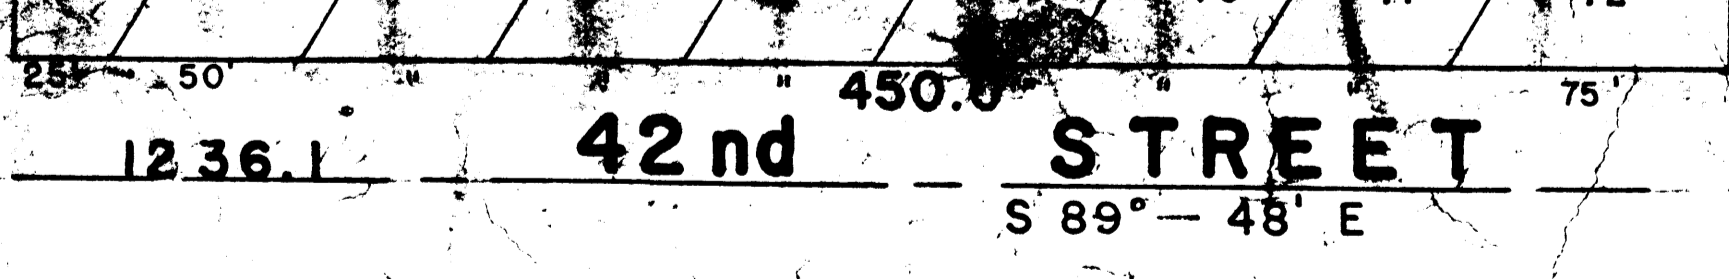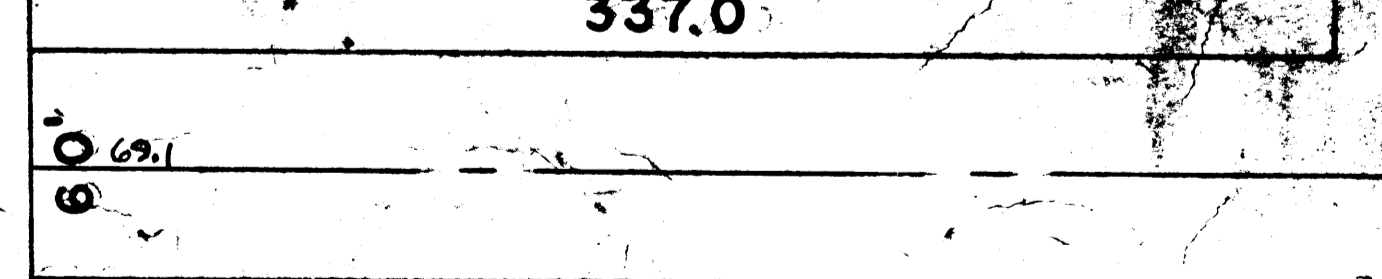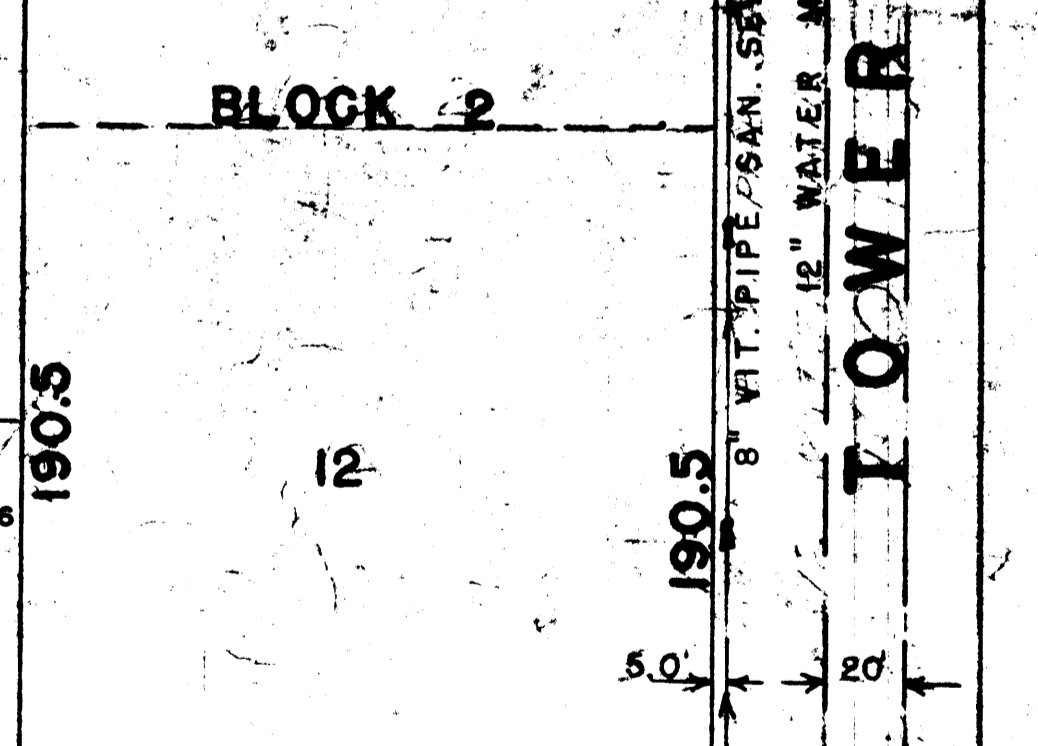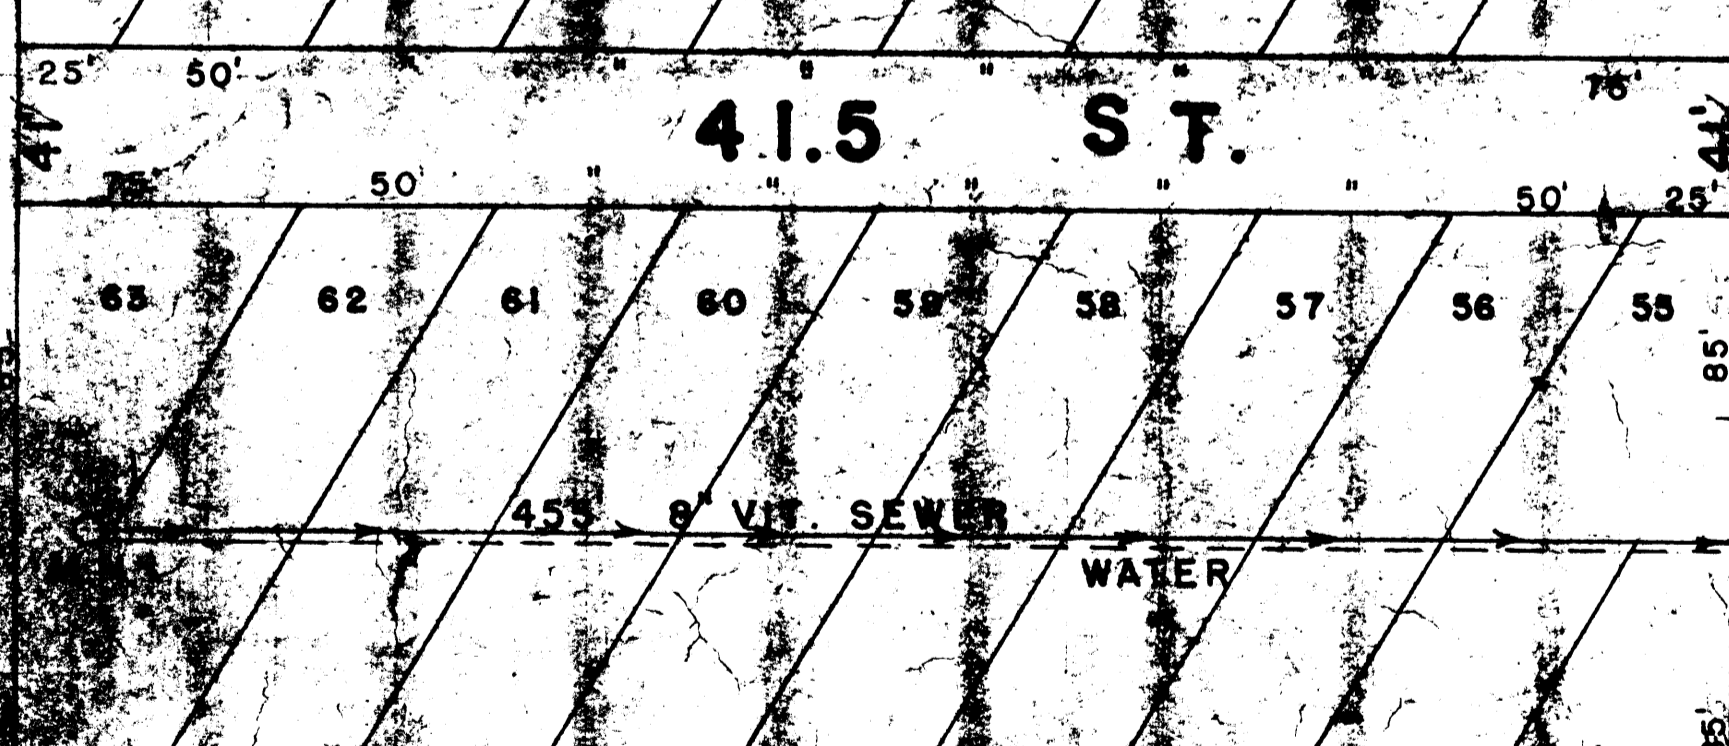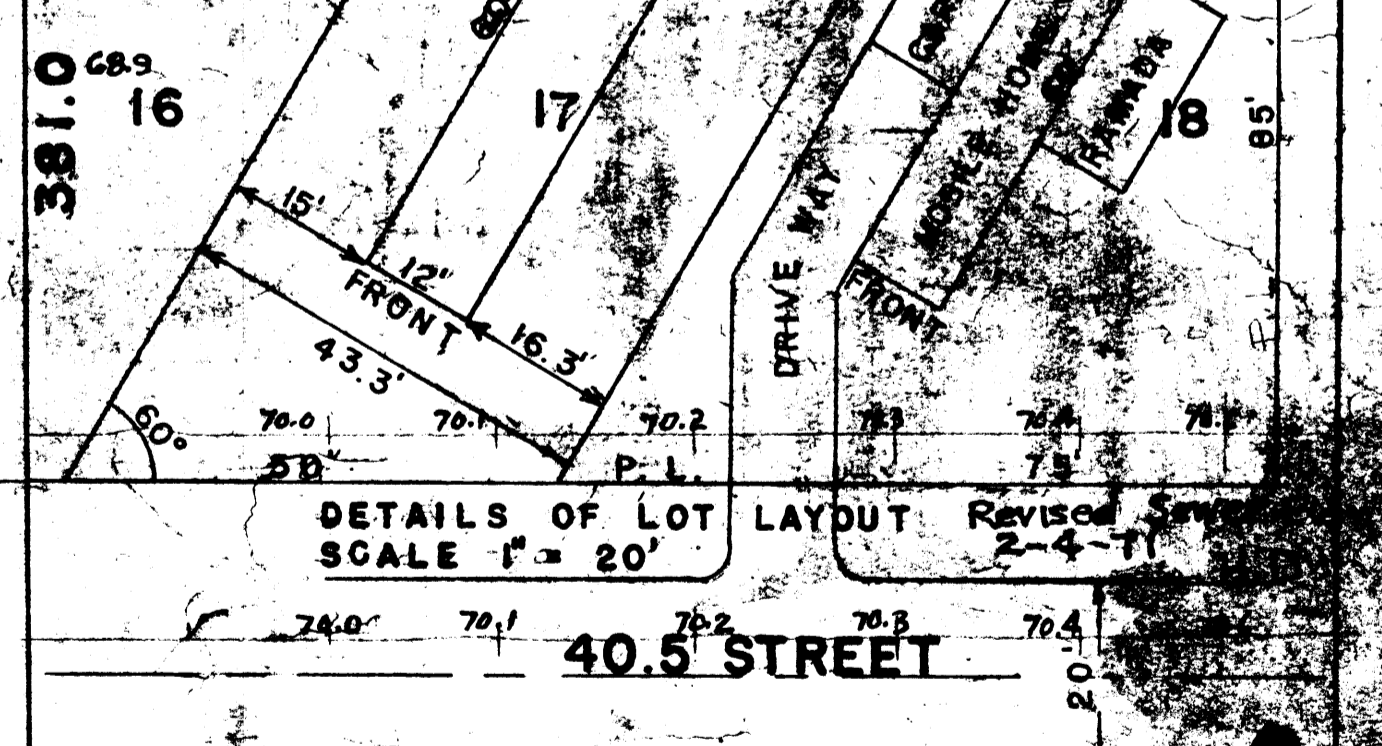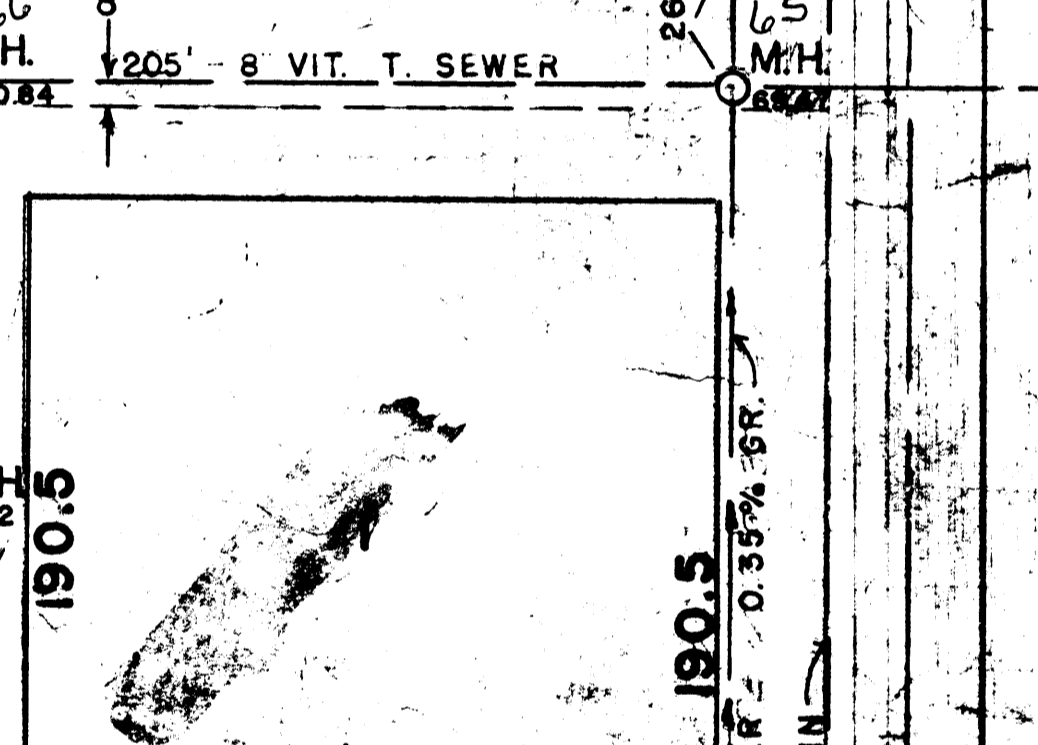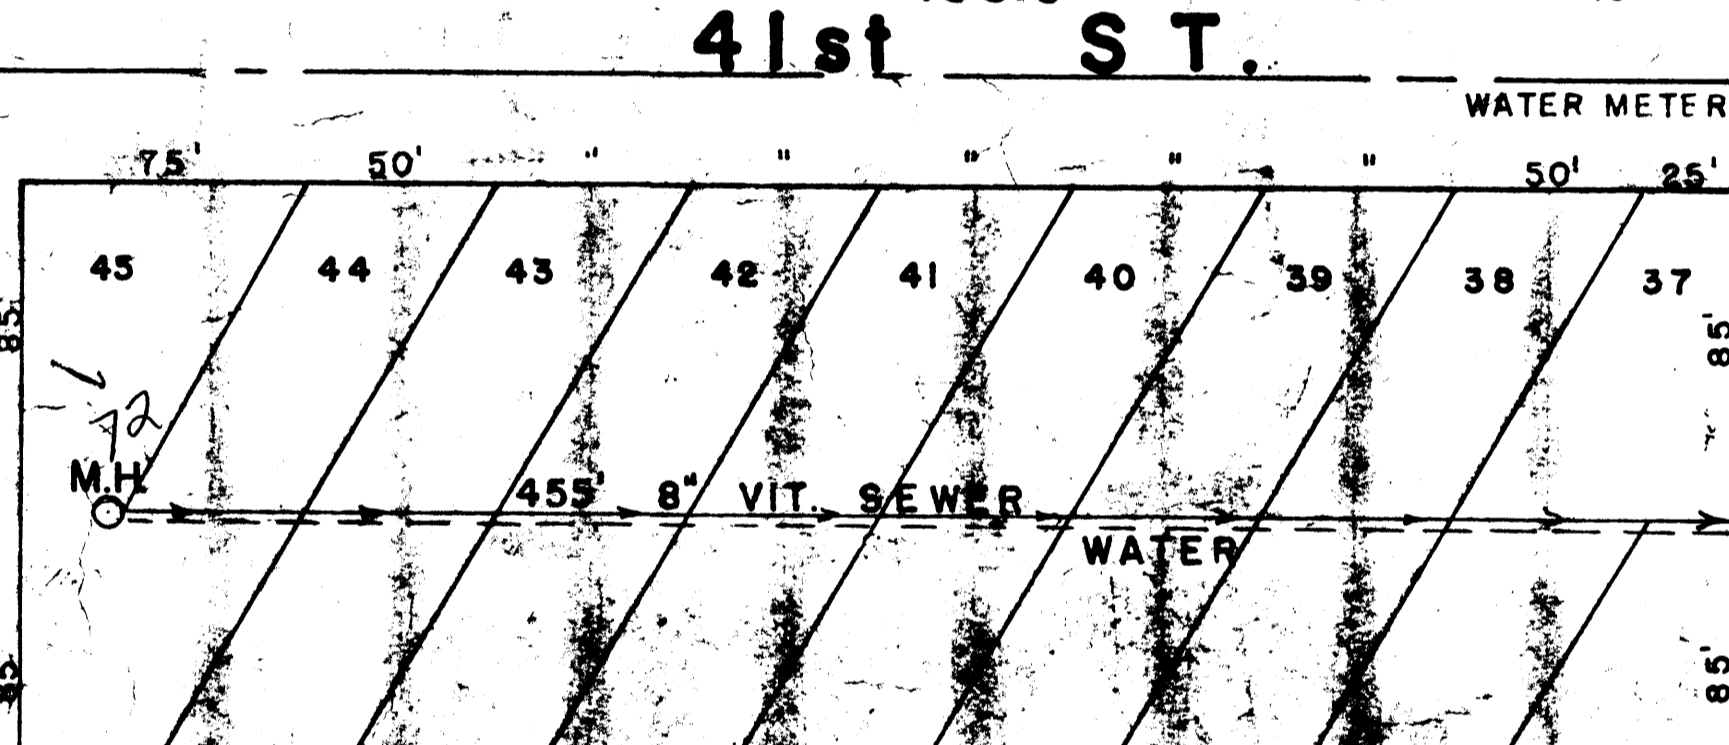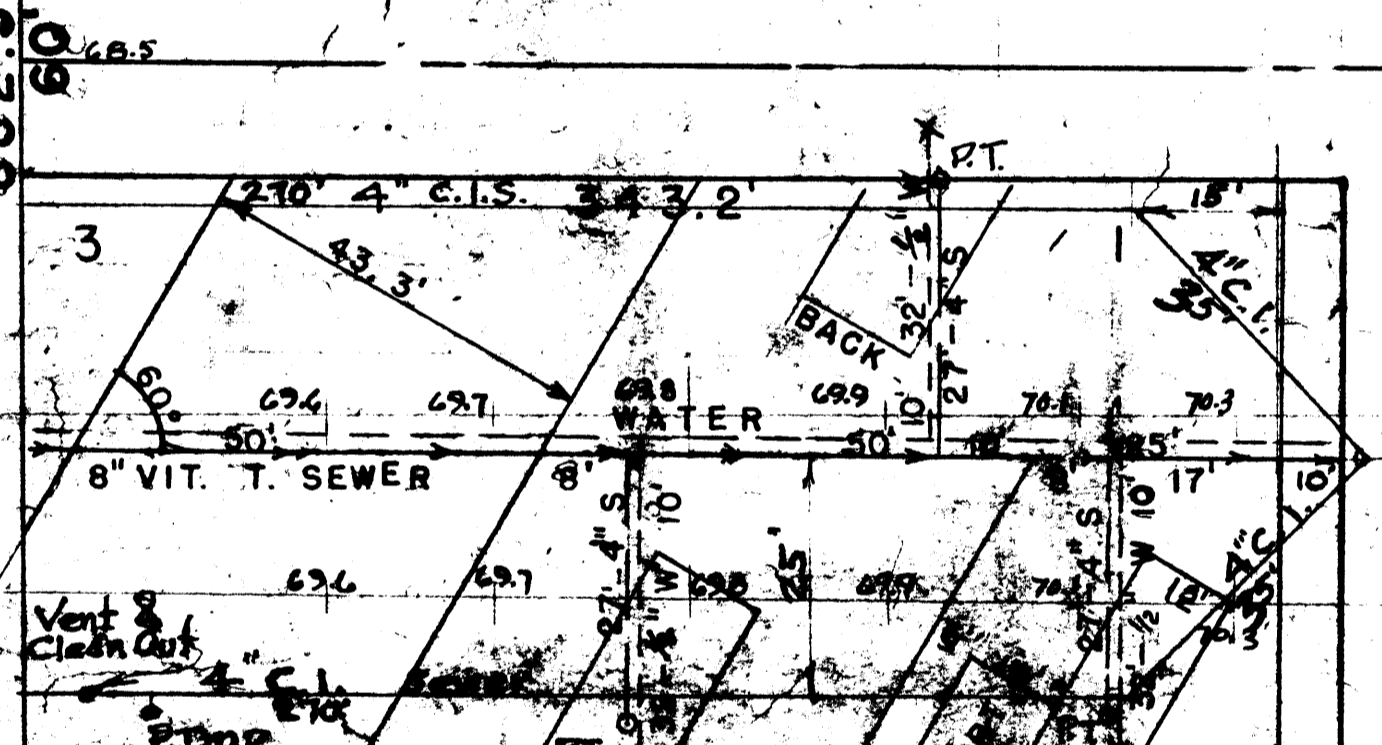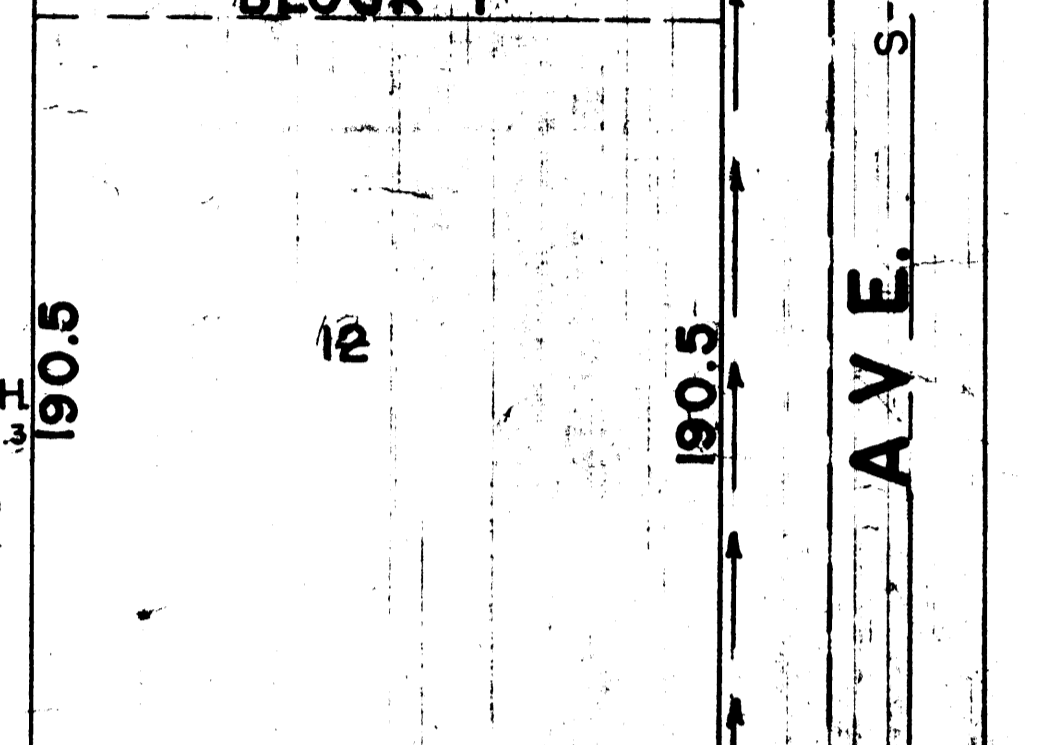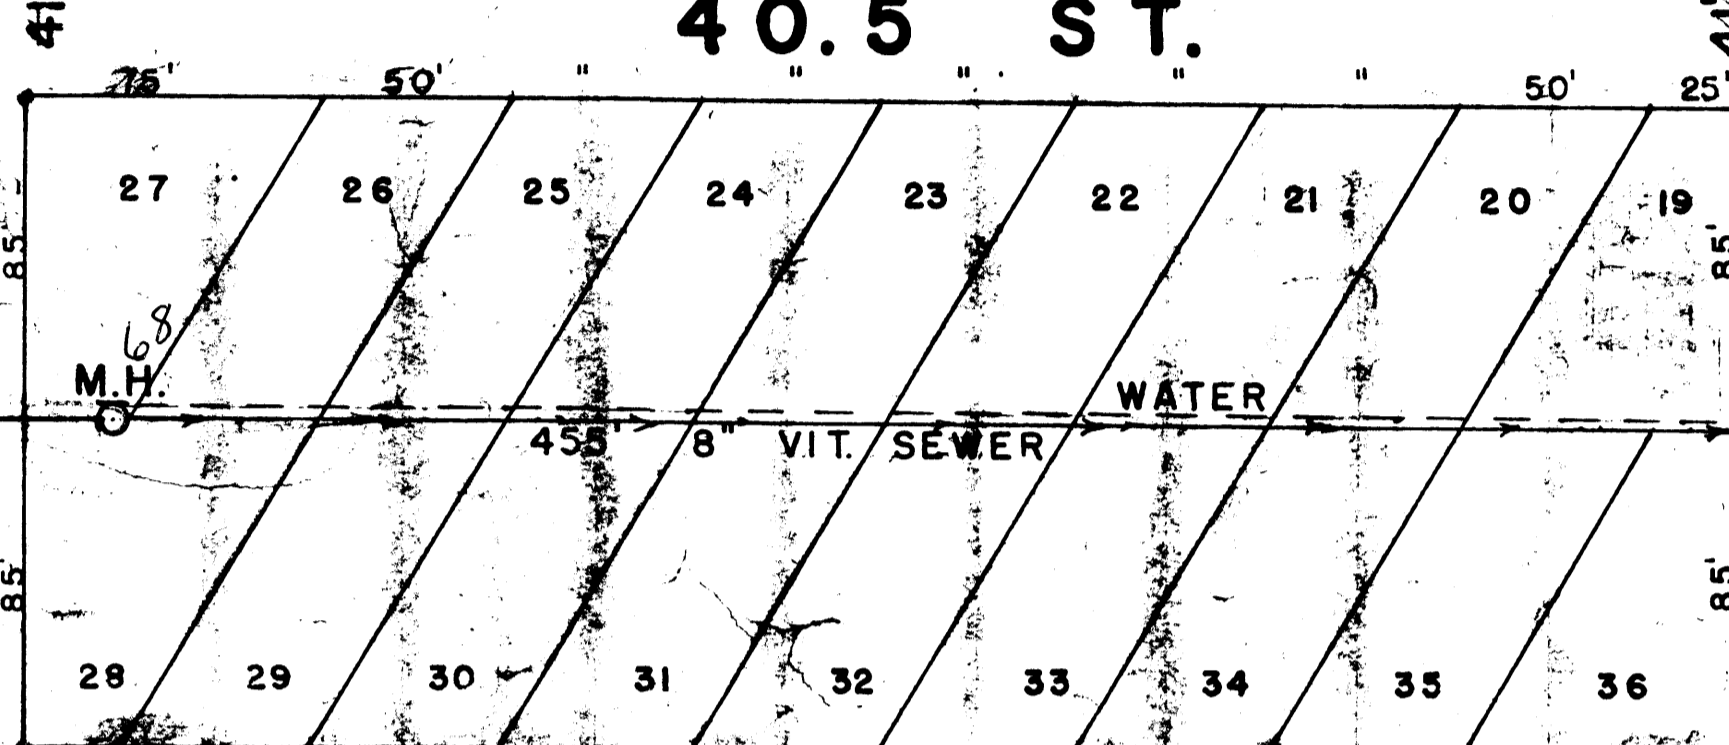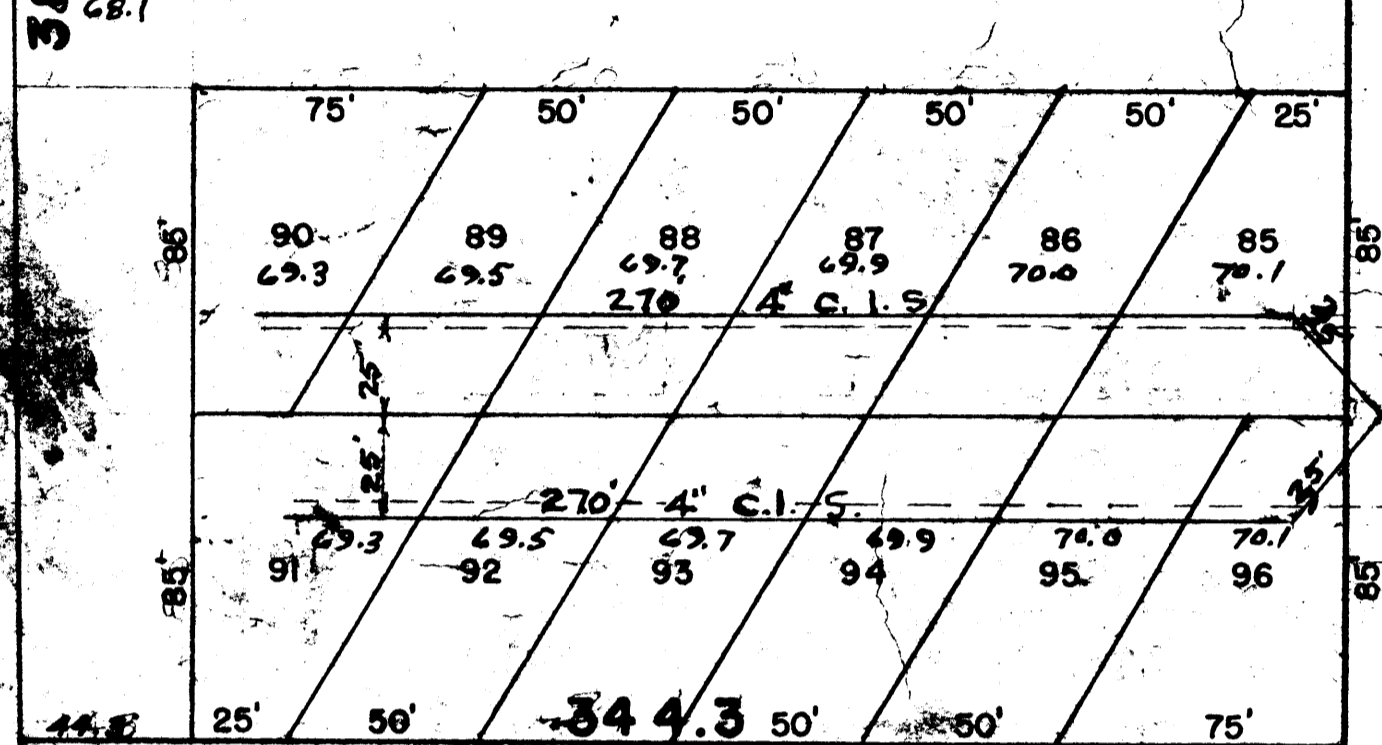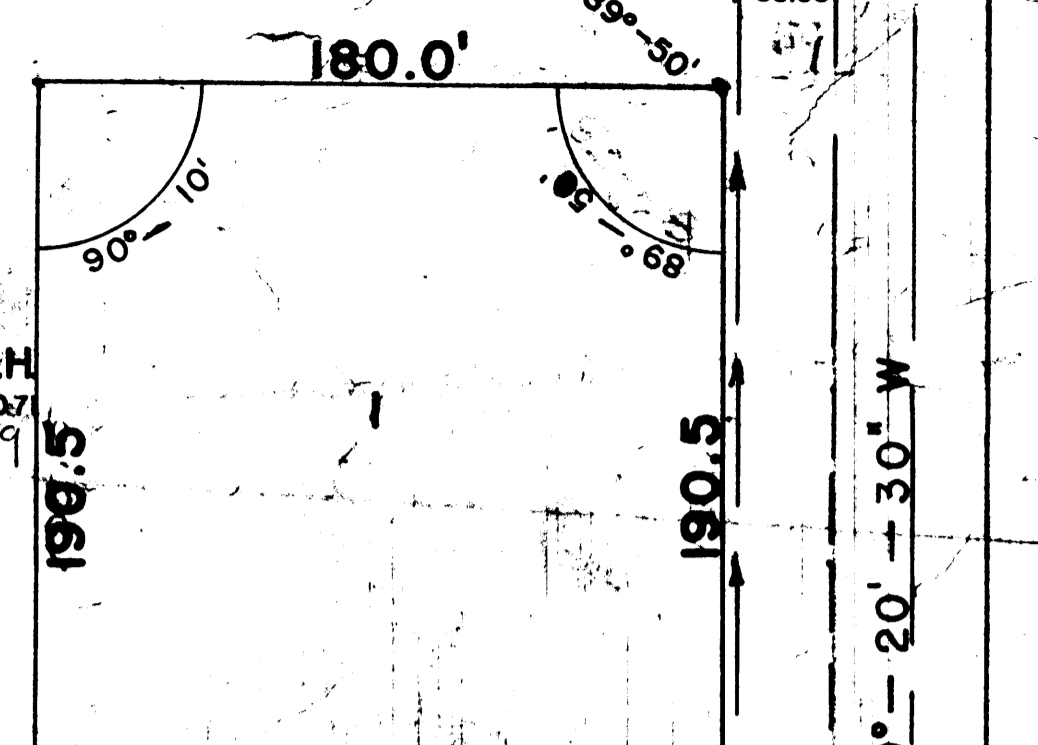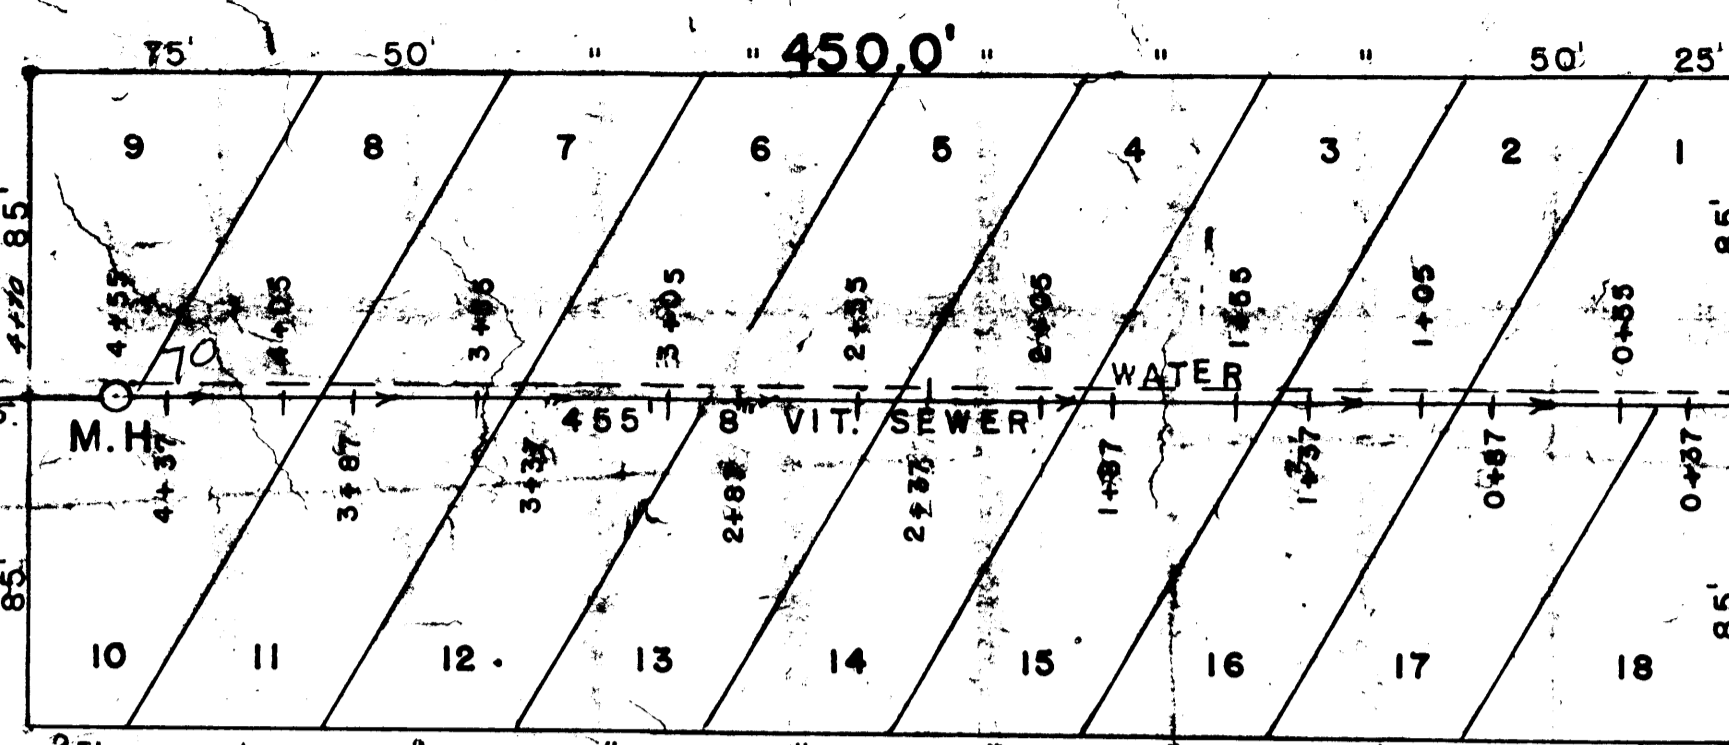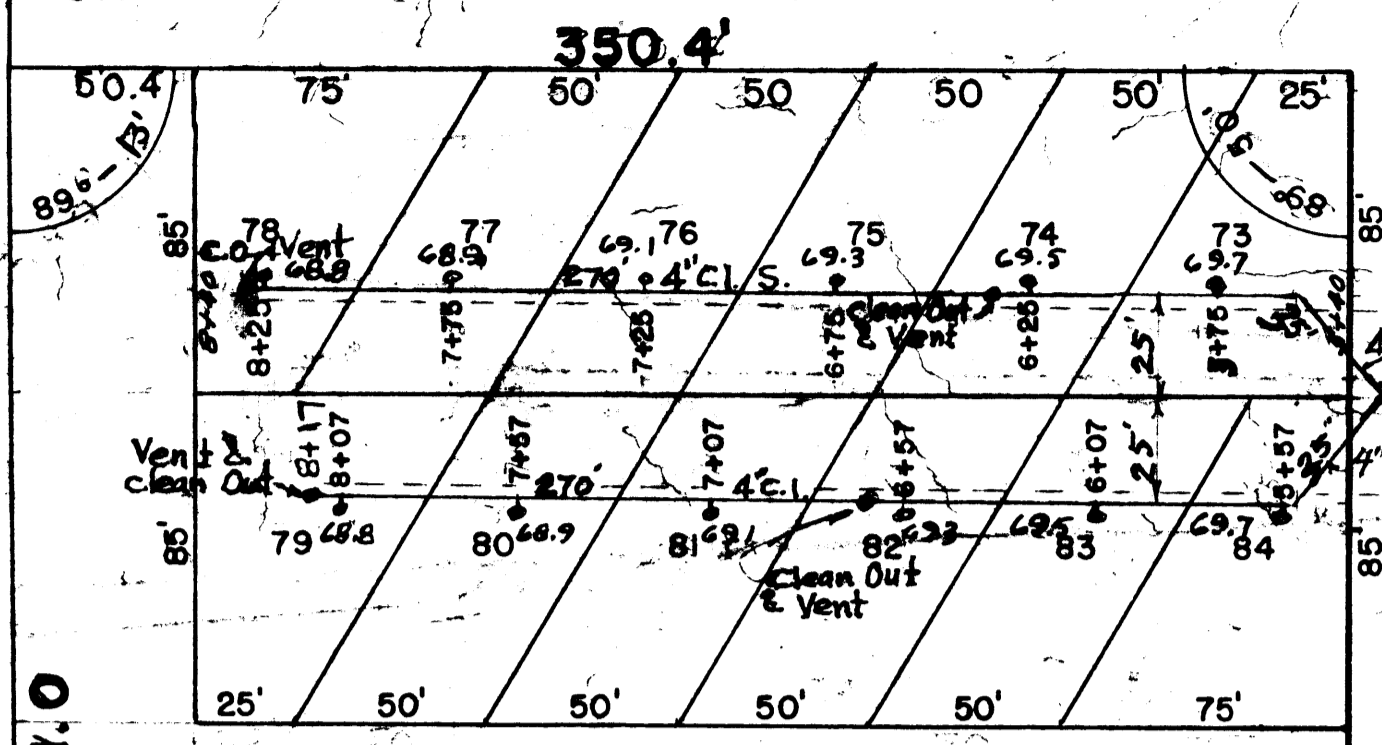

N. P. R. R.

OAKES AVE.

TOWER AVE.

DETAILS OF LOT LAYOUT SCALE 1" = 20'

40.5 STREET

337.0

1236.1' WATER 42nd STREET S-89°-48' E

LOTS 73-120 9-9-70

MOBILE HOME COURTS HOMEGROFT ACRES

N 1/4 W 75 100 ACRES NE 1/4 S 34 T 49 R 14 EDWARDS REALTY CO.

DATE 7-20-68 SCALE 1" = 50'

BY H. DANN



BASIN 9

BASIN 9