


BENCH MARKS			
NO.	STA.	DESCRIPTION	ELEV.
2		GEO. MON. #2794-19, S.W. COR. 31 ST & HAM.	650.985
3		GEO. MON. #2794-43, S.E. COR. 31 ST & TOWER	637.85

PLAN	DATE
NO.	BY
NO.	BY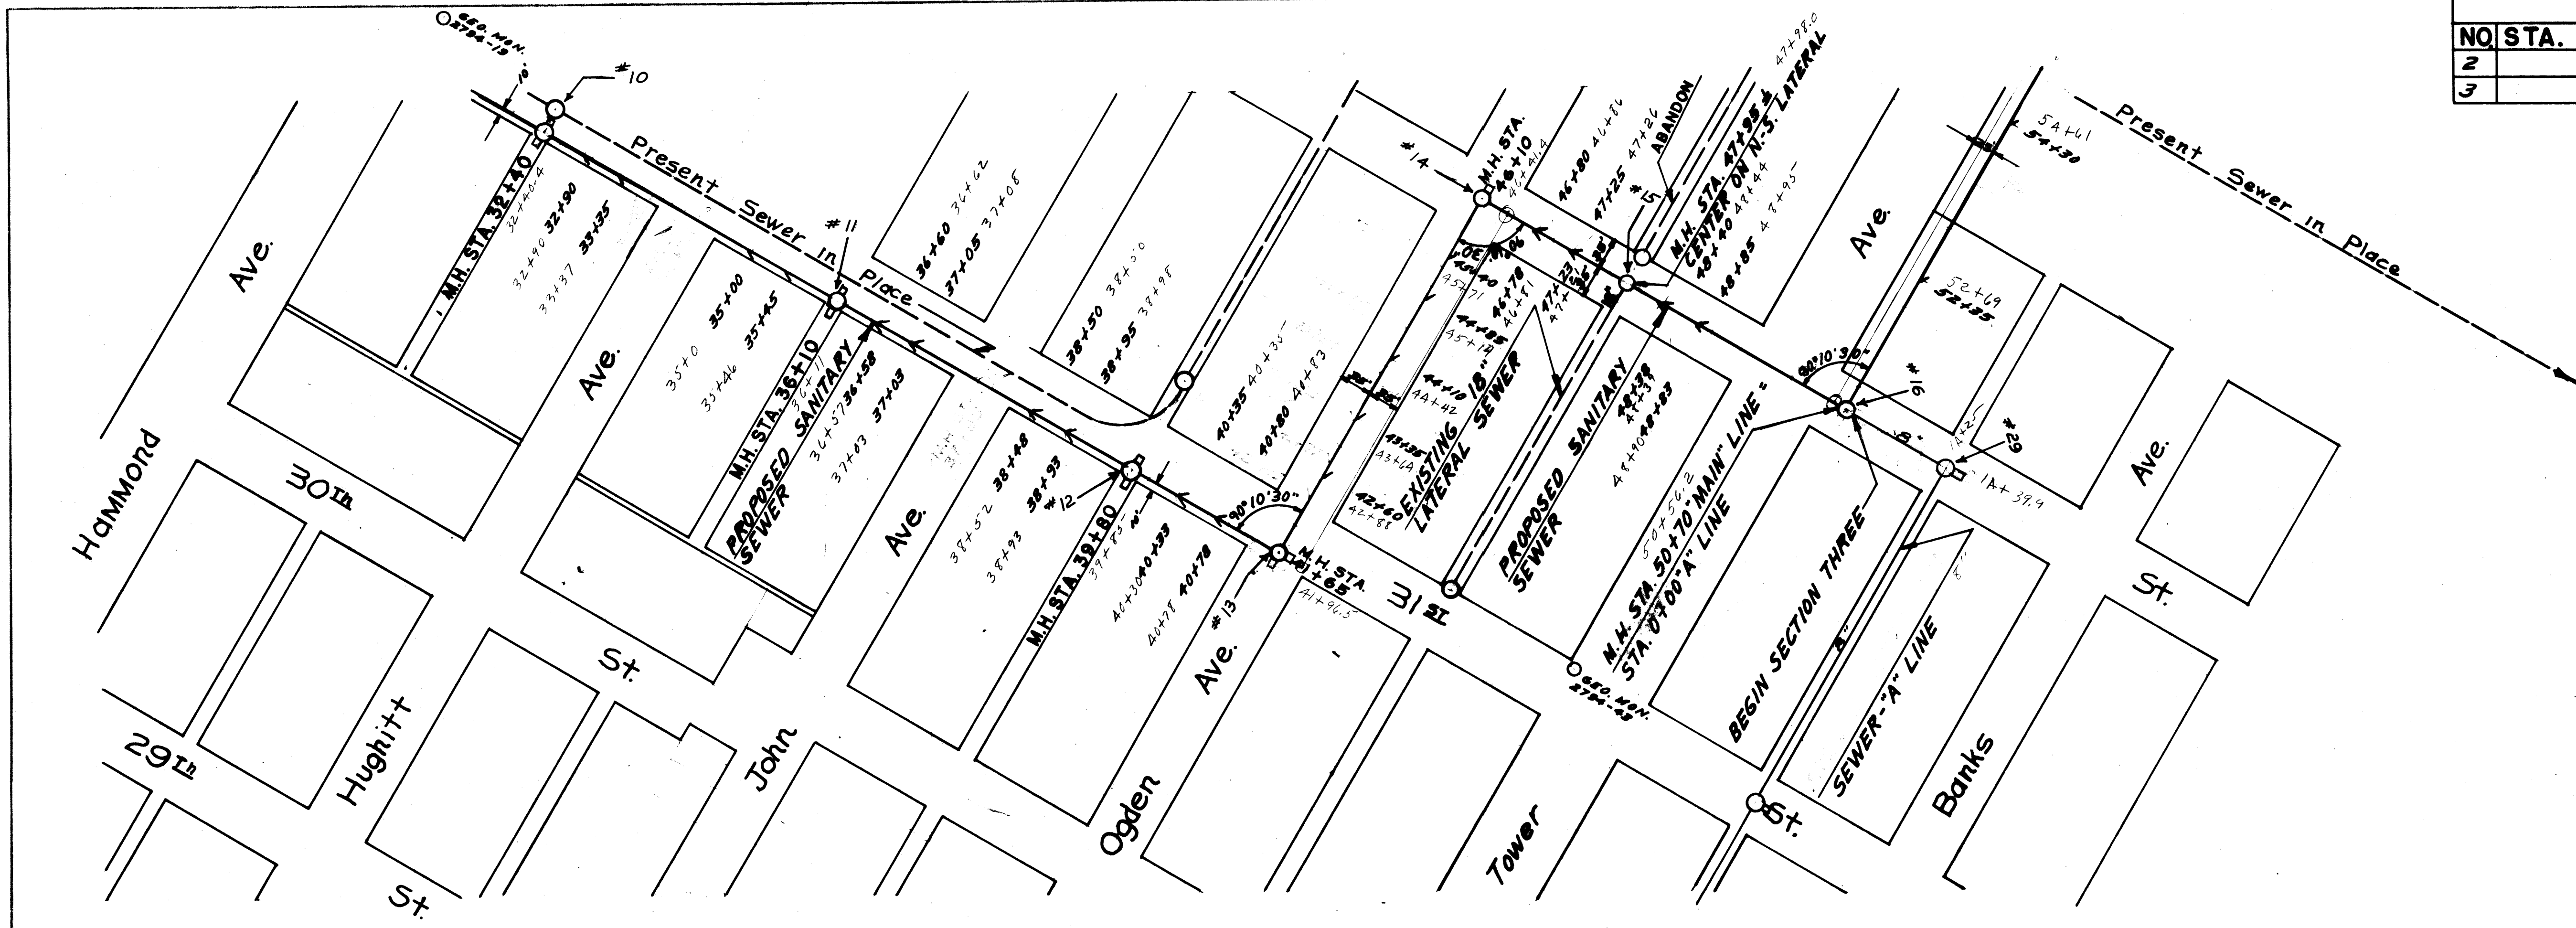
Revised 5-8-59

PROFILE	DATE
NO.	BY
NO.	BY
