



BENCH MARKS			
NO.	STA.	DESCRIPTION	ELEV.
3		GEOD. MON. #2794-43, SE. COR. 31 <sup>ST</sup> 97 <sup>TH</sup> MER.	657.85

REVISED 5-8-59

PLAN SURVEYED BY DATE  
 NOTE BOOK NO. OF WAY CHECKED  
 NO. OF WAY CHECKED

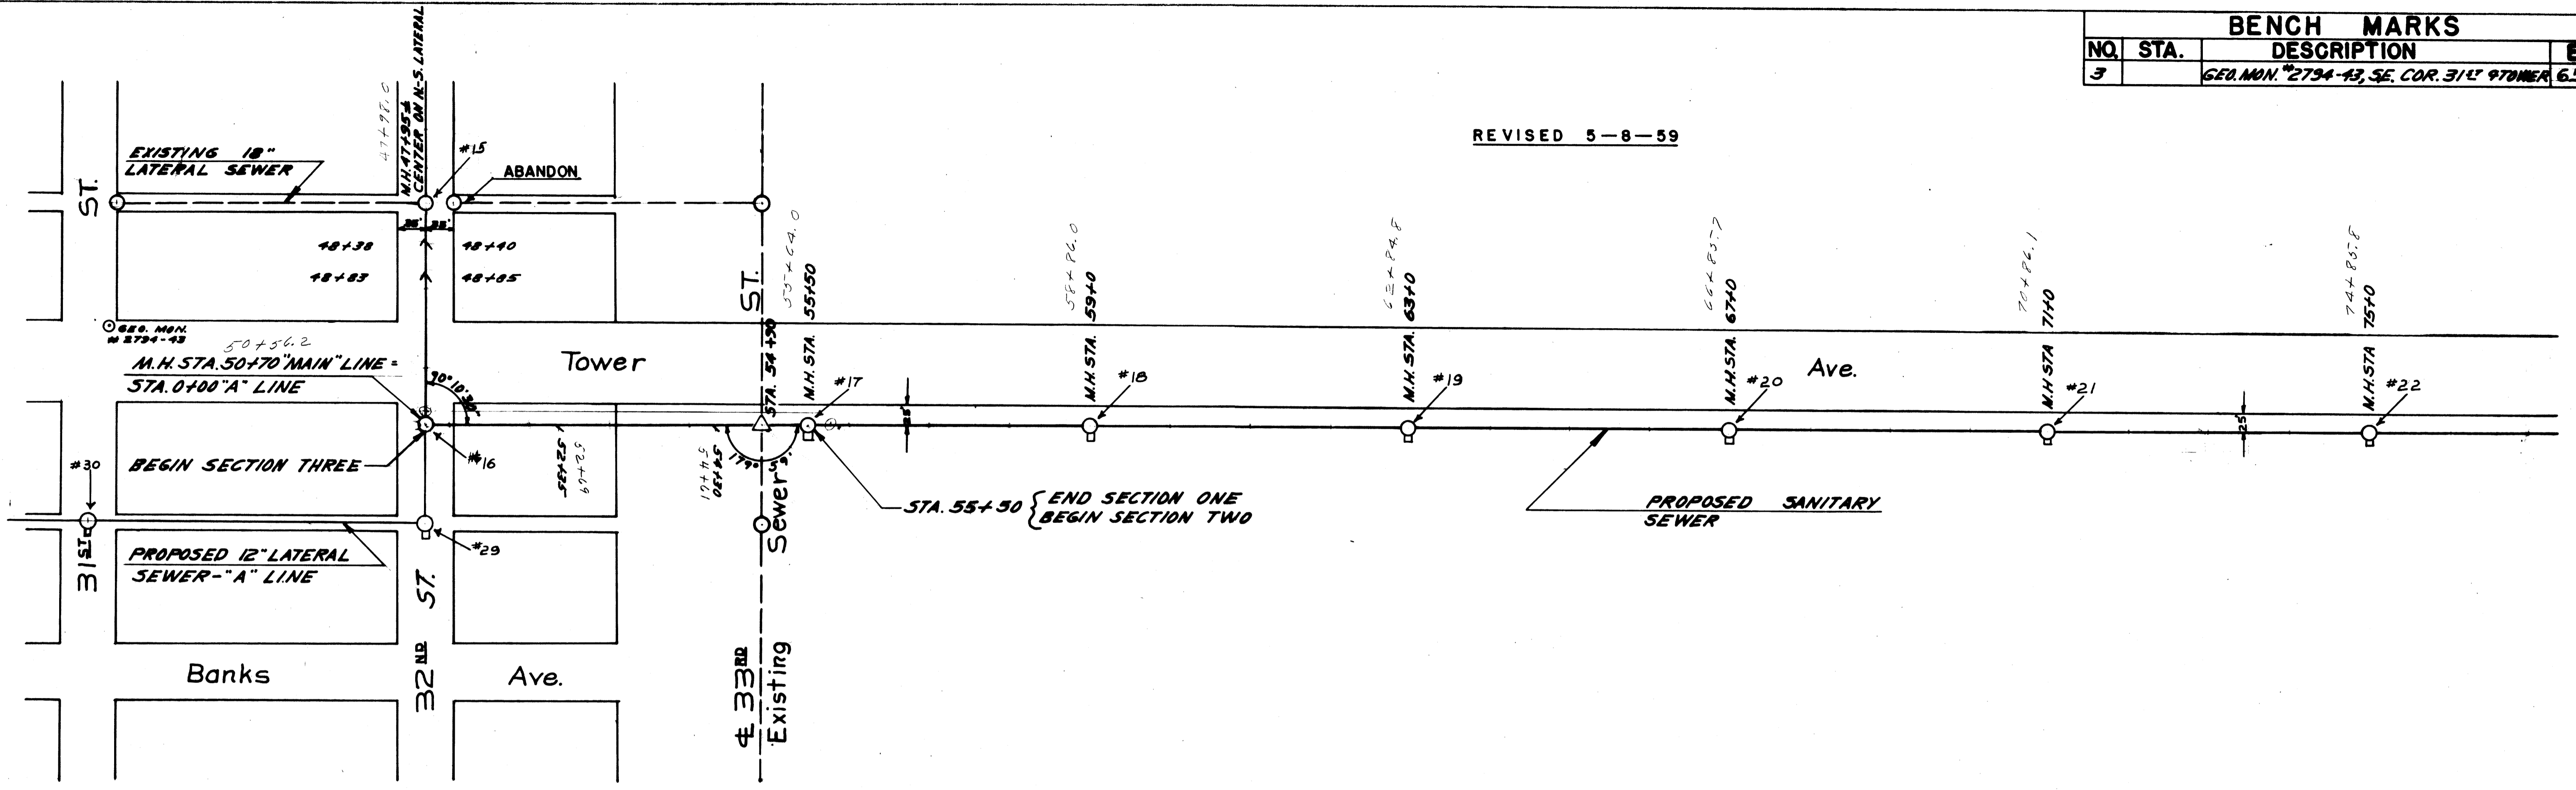

PROFILE SURVEYED BY DATE  
 NOTE BOOK NO. GRADES CHECKED  
 NO. GRADES CHECKED

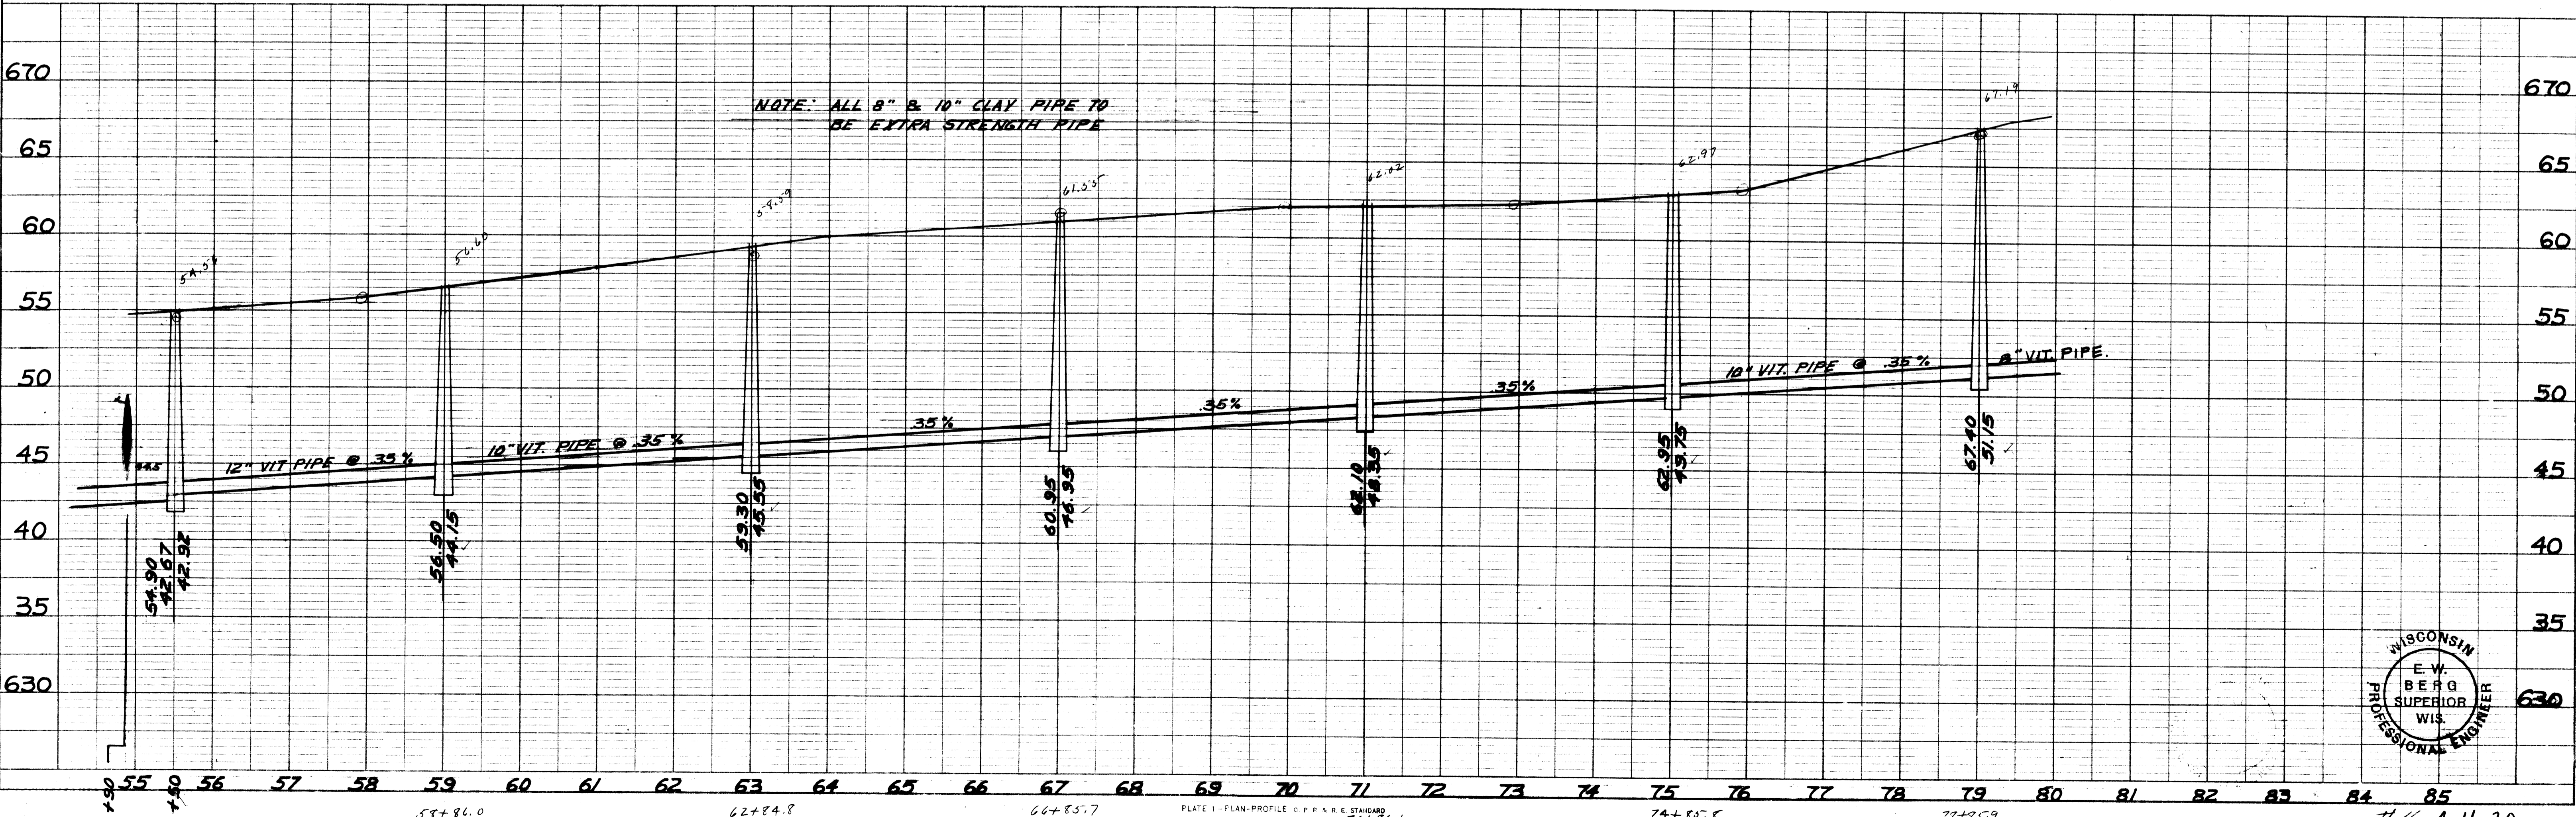

NOTE: ALL 8" & 10" CLAY PIPE TO BE EXTRA STRENGTH PIPE

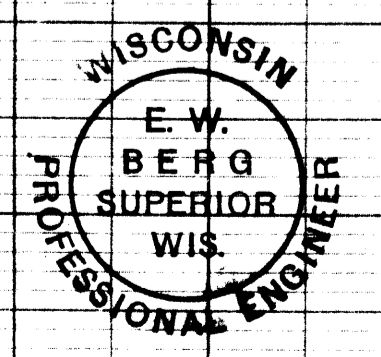


PLATE 1-PLAN-PROFILE © P. R. & R. STANBARD  
 KELFEL & ESSER CO., NEW YORK, 747 86.1