


BELKNAP EXT.

E. W. FOURTH

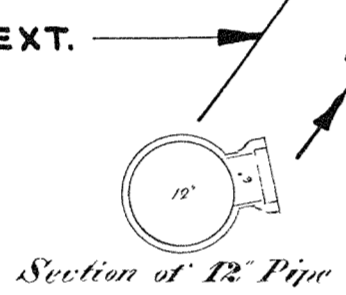


Section of 12" Pipe

STORM SEWER-BUILT IN 1850 BY J.L. SULLIVAN & SONS CONTRACTORS UNDER HIGHWAY CONTRACT.




Section of 15" Pipe

1893

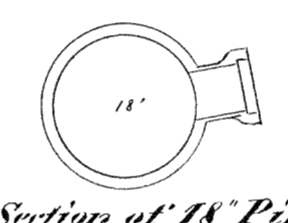


Section of 18" Pipe

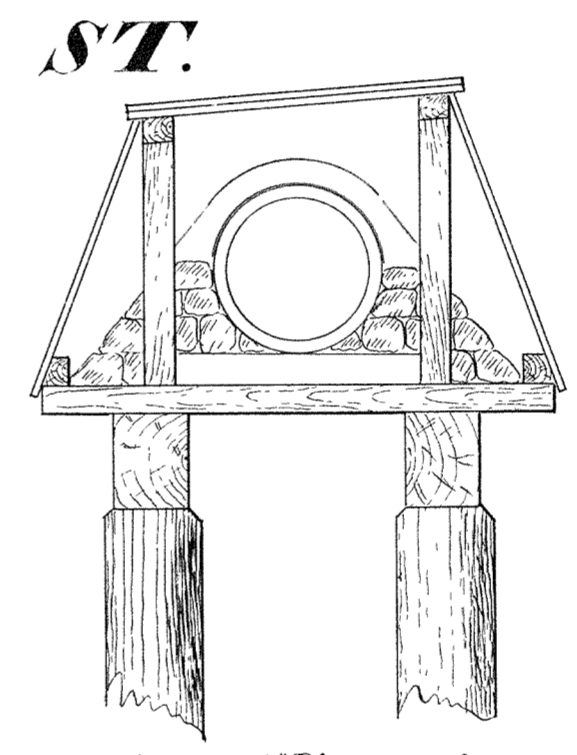

Section of 18" Pipe on Piles

Scale: Horizontal 1 in. = 60 ft.
Vertical 1 in. = 4 ft.
Section 1 in. = 2 ft.

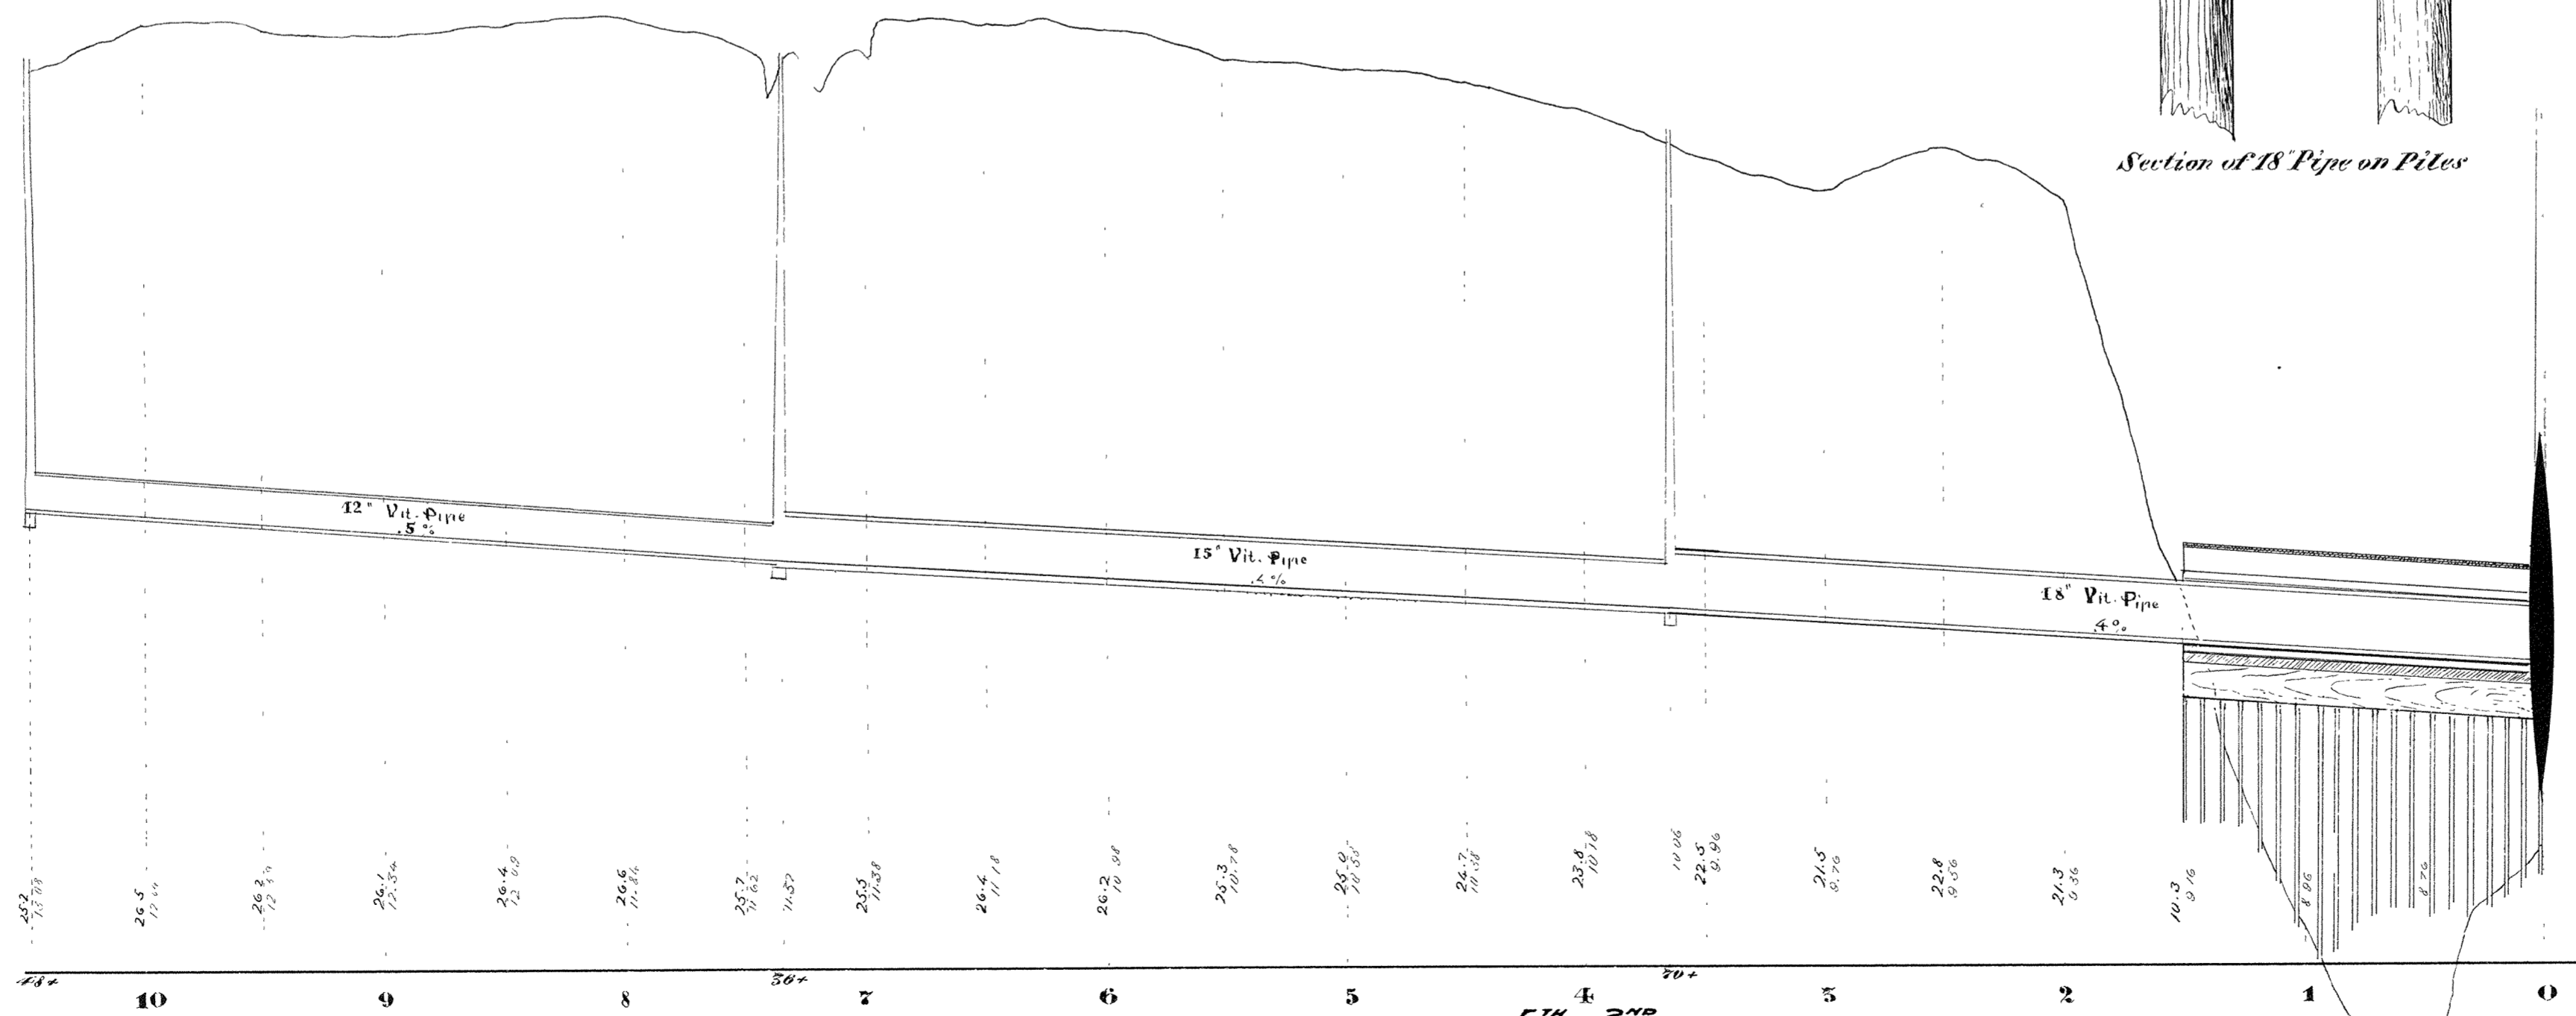

Plan & Profile of Sewer in Alley betw. W. Third and W. Fourth St. from (K) to (H) St.

**CITY OF SUPERIOR
SEWER PLAN**

Contract let Sept. 22, 1893
" completed Oct. 30, 1893
Sang, Nicholson & Co. Contractor
N. T. Hare, Inspector
A. T. Thomas, City Engineer.

3A-1