


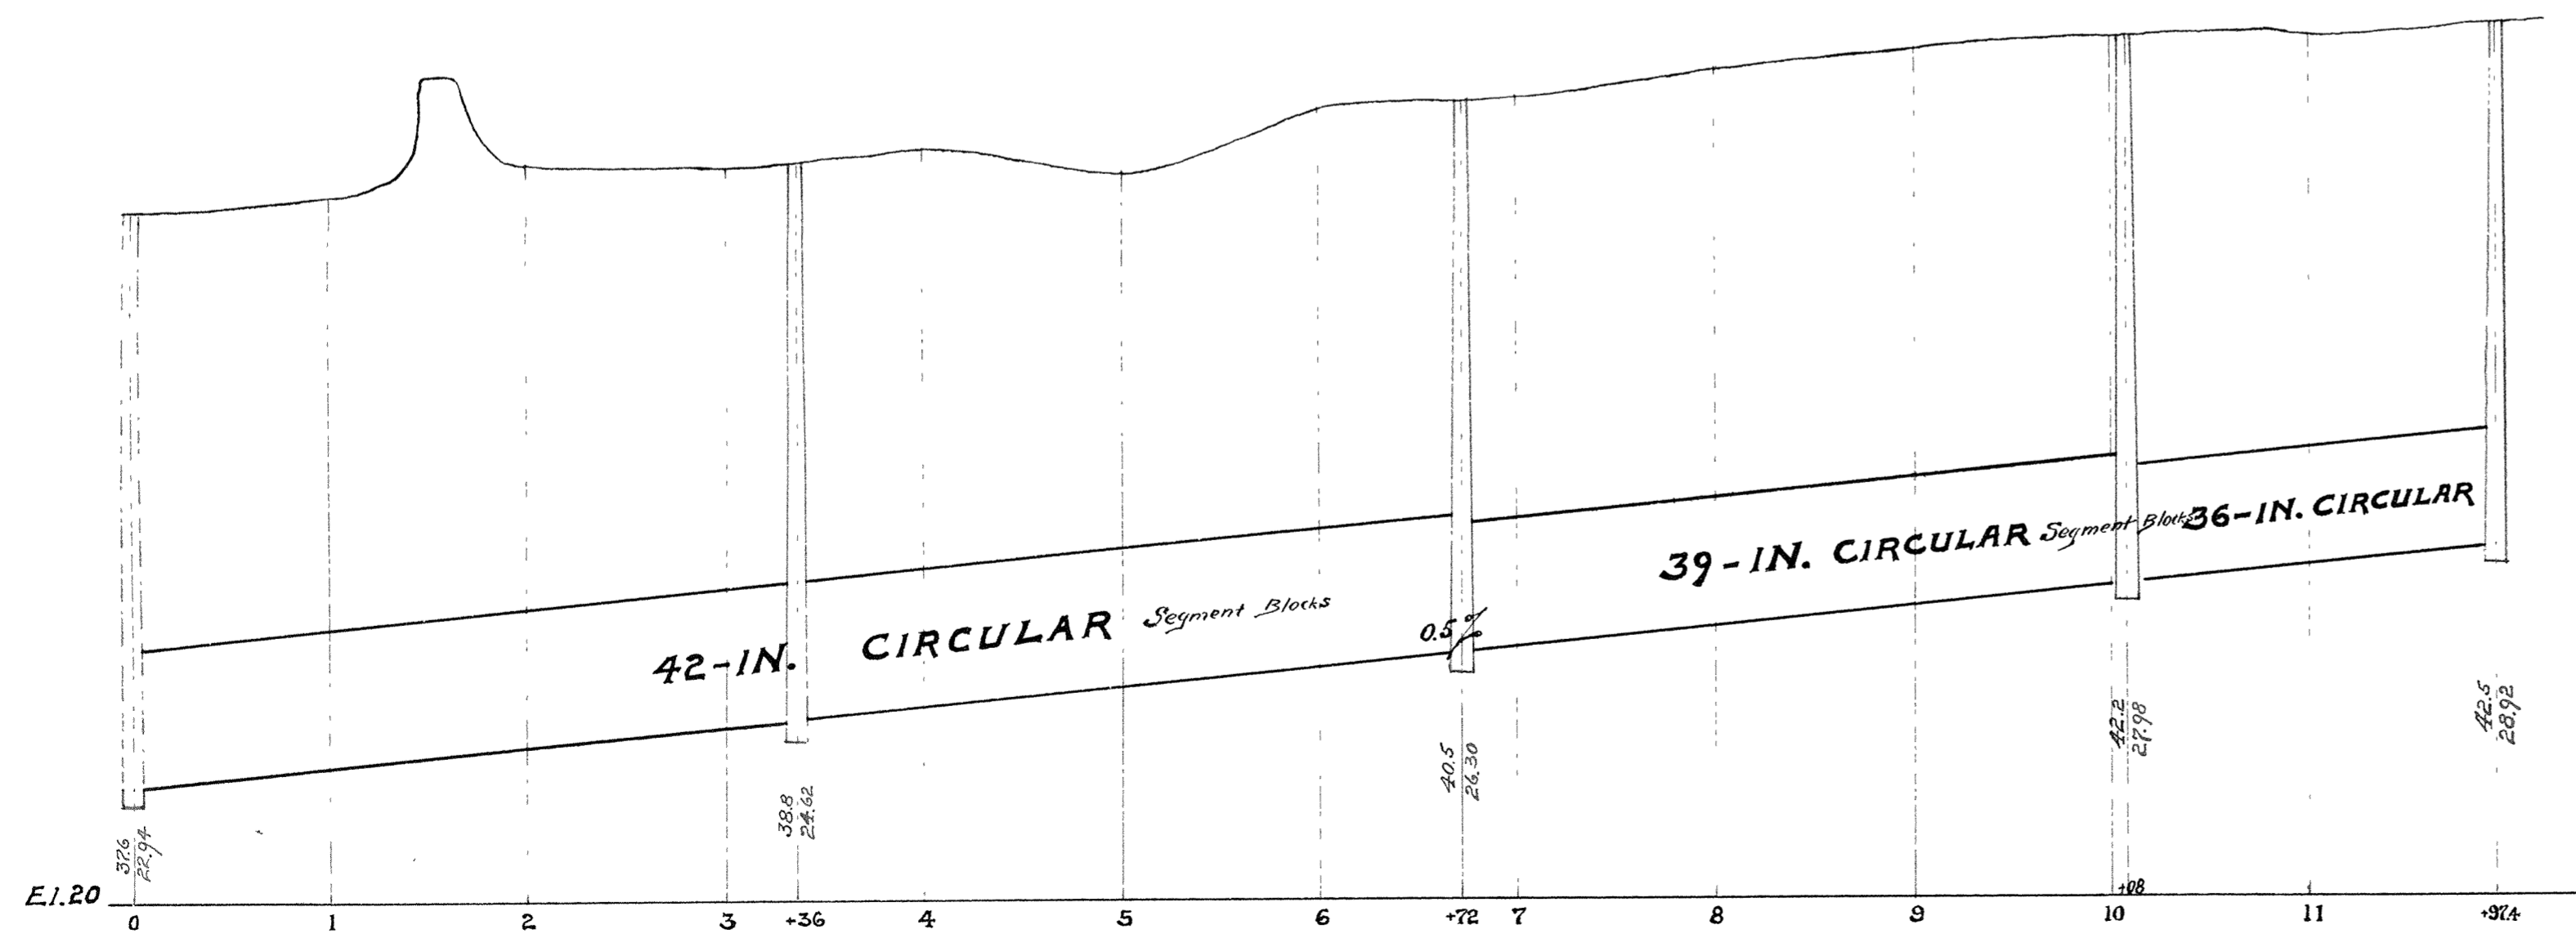

Horizontal Scale: 1in.=80ft.
 Vertical Scale: 1in.=4ft.
 CONTRACT N^o 1494
 Contract let _____ Aug. 20-15.
 Contract completed _____ Oct. 28-15.
 Pastoret Const. Co. _____ Contractor
 J. B. Graham _____ Inspector
 E. B. Banks _____ City Engineer.



3A-12A